

- \* LT LANE CONSTRUCTION
- GRANITE SLOPE EDGING
- ITEM 556-A
- 939+38-939+88 RT LANE (NOSING)
- 5+13-5+63 LT RAMP 'A' (NOSING)
- 2+30-8+01 RT RAMP 'B'
- \* BITUMINOUS CONCRETE CURB
- ITEM 555
- 2+00-6+72 LT U.S. 7
- \* THREE CABLE GUARD RAIL
- W/STEEL POSTS ITEM 543
- 1+65-6+77 LT U.S. 7
- 2+77-6+77 RT U.S. 7
- \* WOOD MARKER POSTS
- ITEM 548-C
- 7+00-10+00 LT U.S. 7

RT LANE CONSTRUCTION  
PROPERTY LINE FENCE  
WITH STEEL POSTS  
RAMP A 0+00-9+00  
RAMP B 0+50-945+25  
RT-RT LANE

DRILLING & BLASTING OF SOLID ROCK SUBGRADE	
ITEM 114 MOD	
RAMP A	6+00-8+50
RAMP B	1+00-3+00

* RT LANE CONSTRUCTION			
THREE CABLE GUARD RAIL WITH STEEL POST			
ITEM 543			
STATION	US 7	STATION	
1+93		6+65	LT
2+73		6+65	RT


BEGIN MAINT. AGREE. AREA NO.3  
RTE. 7 1+72 (765')

END MAINT. AGREE. AREA NO.3  
T.R. 61 9+37 6

PARCEL 59H  
GRANTOR: MARTHA F. SIBLEY & CHARLES A. SIBLEY, ESTATE  
TAKING: 80A ± REMAINING: 135.3 A ±  
STATIONS 938+50-950+00 NB

CONTROL OF ACCESS IS COMPLETE ON THIS SHEET  
EXCEPT FOR N.B. 939+00 AND N.B. 944+50 RT.

\* STAGE 2 CONSTRUCTION

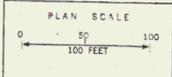

RT LANE CONSTRUCTION  
HIGHGATE

SURVEYED BY \_\_\_\_\_ DATE \_\_\_\_\_  
DRAWN BY \_\_\_\_\_ DATE \_\_\_\_\_  
TRACED BY A.J.A. DATE 11/63

JAN 16 1980

PROJ. I NO. 89-3 (33)  
SHEET 51A OF 204

47