


CONSTRUCT 12' HOLDING LANE INCLUDING 17% TAPER			
STATION	STATION	POS.	LENGTH
967+00	967+18	LT	18'
RIGHT TAP			
967+00	966+65	LT	165'

CONSTRUCT U-TURN		
STATION	POS.	RT.
969+22		RT

DEMOLITION & REMOVAL OF BUILDING ITEM 566		
STATION	POS.	NO.
969+75	LT	11 D

STANDARD STEEL BEAM BRIDGE WITH SKILL POSTS ITEM 547			
STATION	STATION	POS.	LOCATION
969+675	969+965	LT	POINT MON NO. 630

969+84.1
AT 83°48'30" RT.
END PROJECT
I 89-3(6)

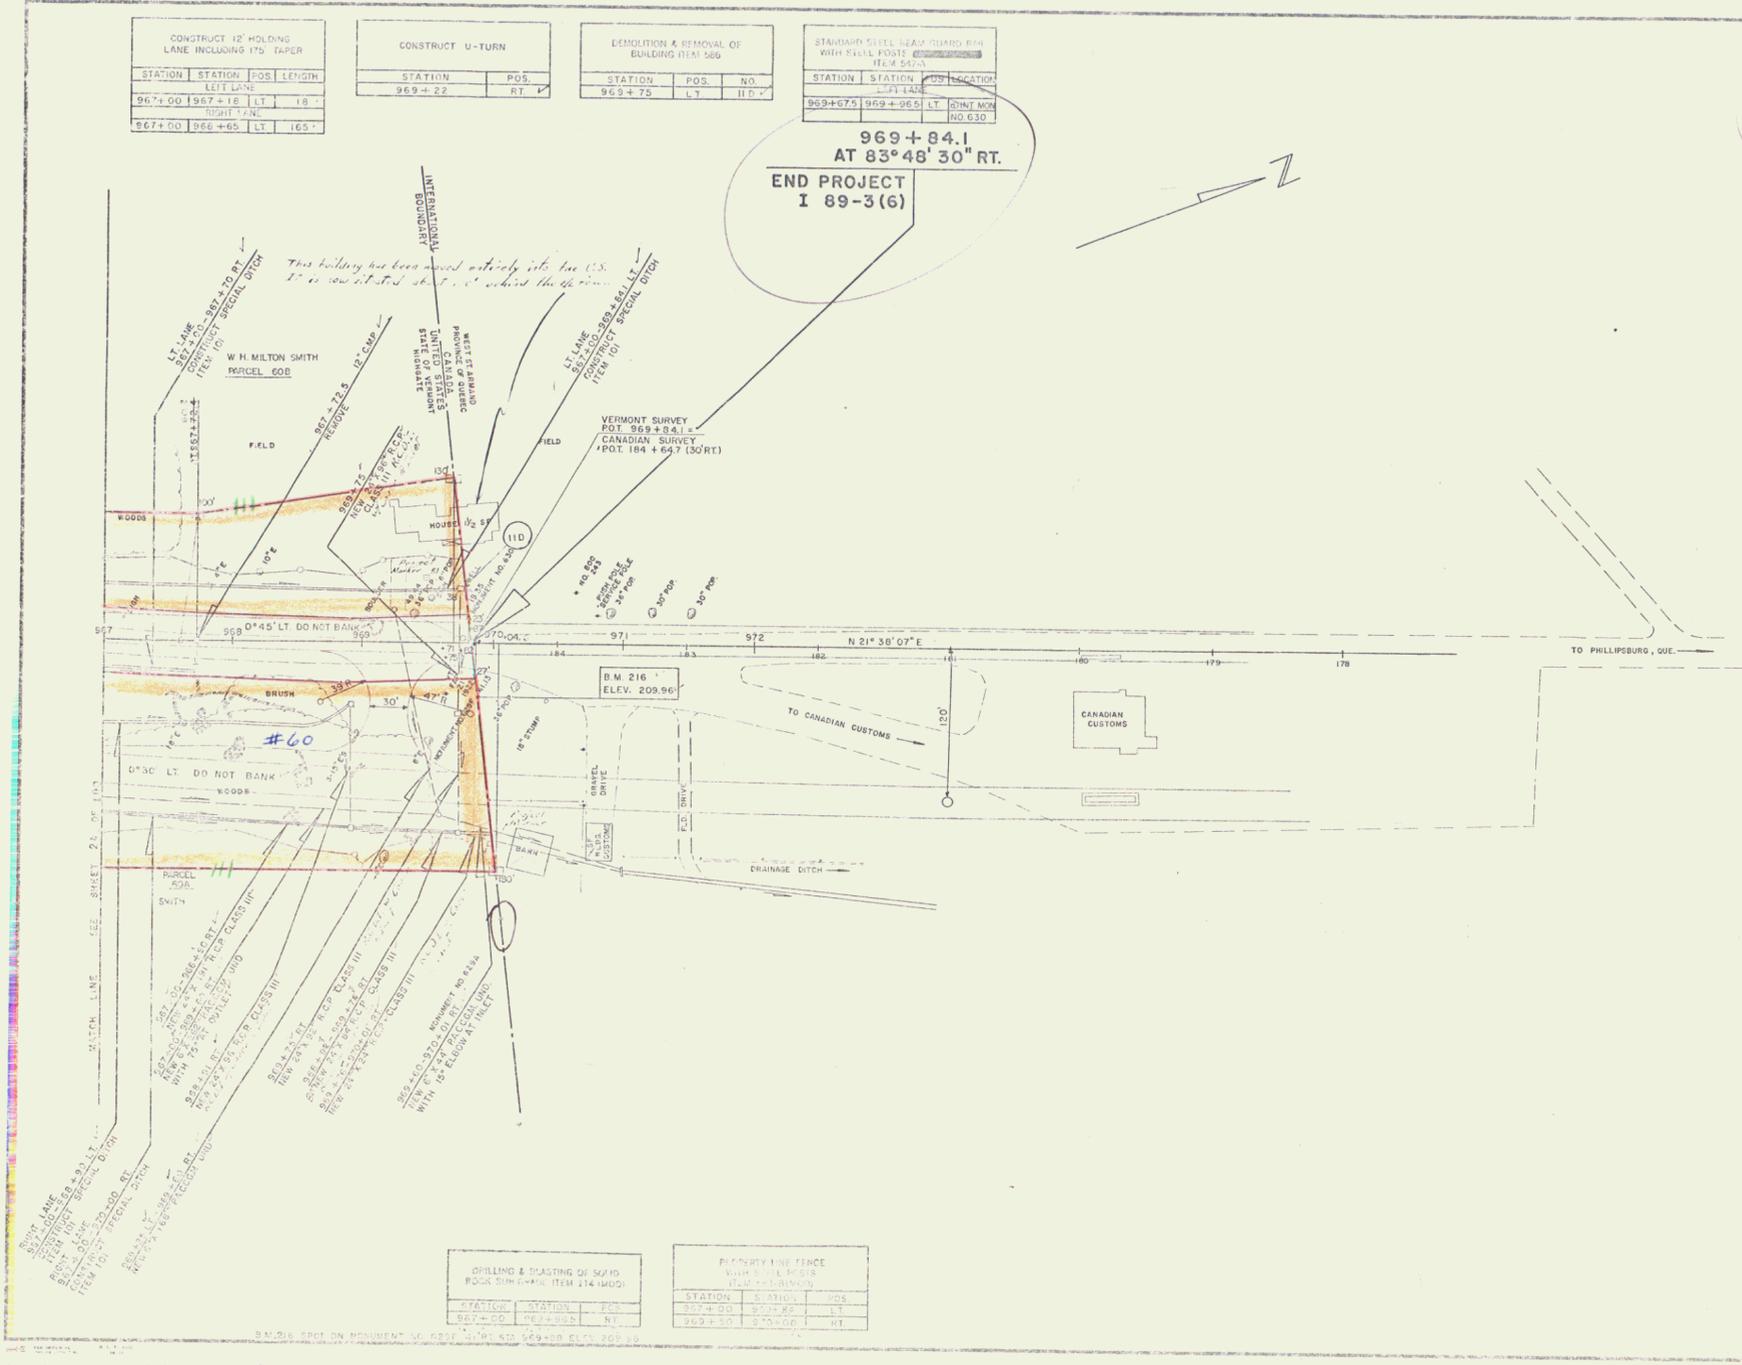

CONTROL OF ACCESS IS NOT COMPLETE ON THIS SHEET.
ALL BEARINGS ARE MAGNETIC.
* ALL ITEMS WITH ASTERISK ARE STAGE 2 CONSTRUCTION

STAGE 1 CONSTRUCTION	
STATION	POS.
967+00	967+18
967+00	966+65
969+22	969+22
969+675	969+965
HIGHGATE PLAN	
STA. 967+00 TO 969+84.1	

GRILLING & BRACING OF SKYD. ROAD SIGN C-MARK ITEM 114-14002		
STATION	STATION	POS.
967+00	967+18	LT
969+22	969+22	RT

PROPERTY LINE FENCE		
STATION	STATION	POS.
967+00	967+18	LT
969+22	969+22	RT

47

26