


Property Line Fence With Steel Posts Item 563 B 659 + 00 to 674 + 00 Rt. 659 + 00 to 674 + 00 Lt. 671 + 17 to 672 + 00 Lt. 672 + 25 to 674 + 00 Lt.	Paved Median Gutter Item No. 351 - B 661 + 00 To 661 + 25 ✓ 665 + 50 To 665 + 75 ✓ 670 + 65 To 670 + 90 ✓	Construct Special Ditch Item No. 103 - A 365 - 35 To 667 - 50 Lt.	Drilling & Blasting of Solid Rock Subgrade Item No. 114 A & B 667 + 00 To 670 + 00 LE 667 + 00 To 670 + 00 RT	Three Cable Guard Rail With Steel Posts 670 + 00 To 674 + 00 RL 672 + 25 To 674 + 00 Lt.	Bituminous Concrete Carb Item No. 555 672 + 50 To 674 + 00 Lt.	<table border="1"> <tr> <th>PLAN NO.</th> <th>STATE</th> <th>FED. AID PROJECT NO.</th> <th>FISCAL YEAR</th> <th>SHEET NO.</th> <th>TOTAL SHEETS</th> </tr> <tr> <td>1</td> <td>VT.</td> <td>1 - 91 - (19)</td> <td>POST WAR</td> <td>32</td> <td>530</td> </tr> </table>	PLAN NO.	STATE	FED. AID PROJECT NO.	FISCAL YEAR	SHEET NO.	TOTAL SHEETS	1	VT.	1 - 91 - (19)	POST WAR	32	530
PLAN NO.	STATE	FED. AID PROJECT NO.	FISCAL YEAR	SHEET NO.	TOTAL SHEETS													
1	VT.	1 - 91 - (19)	POST WAR	32	530													

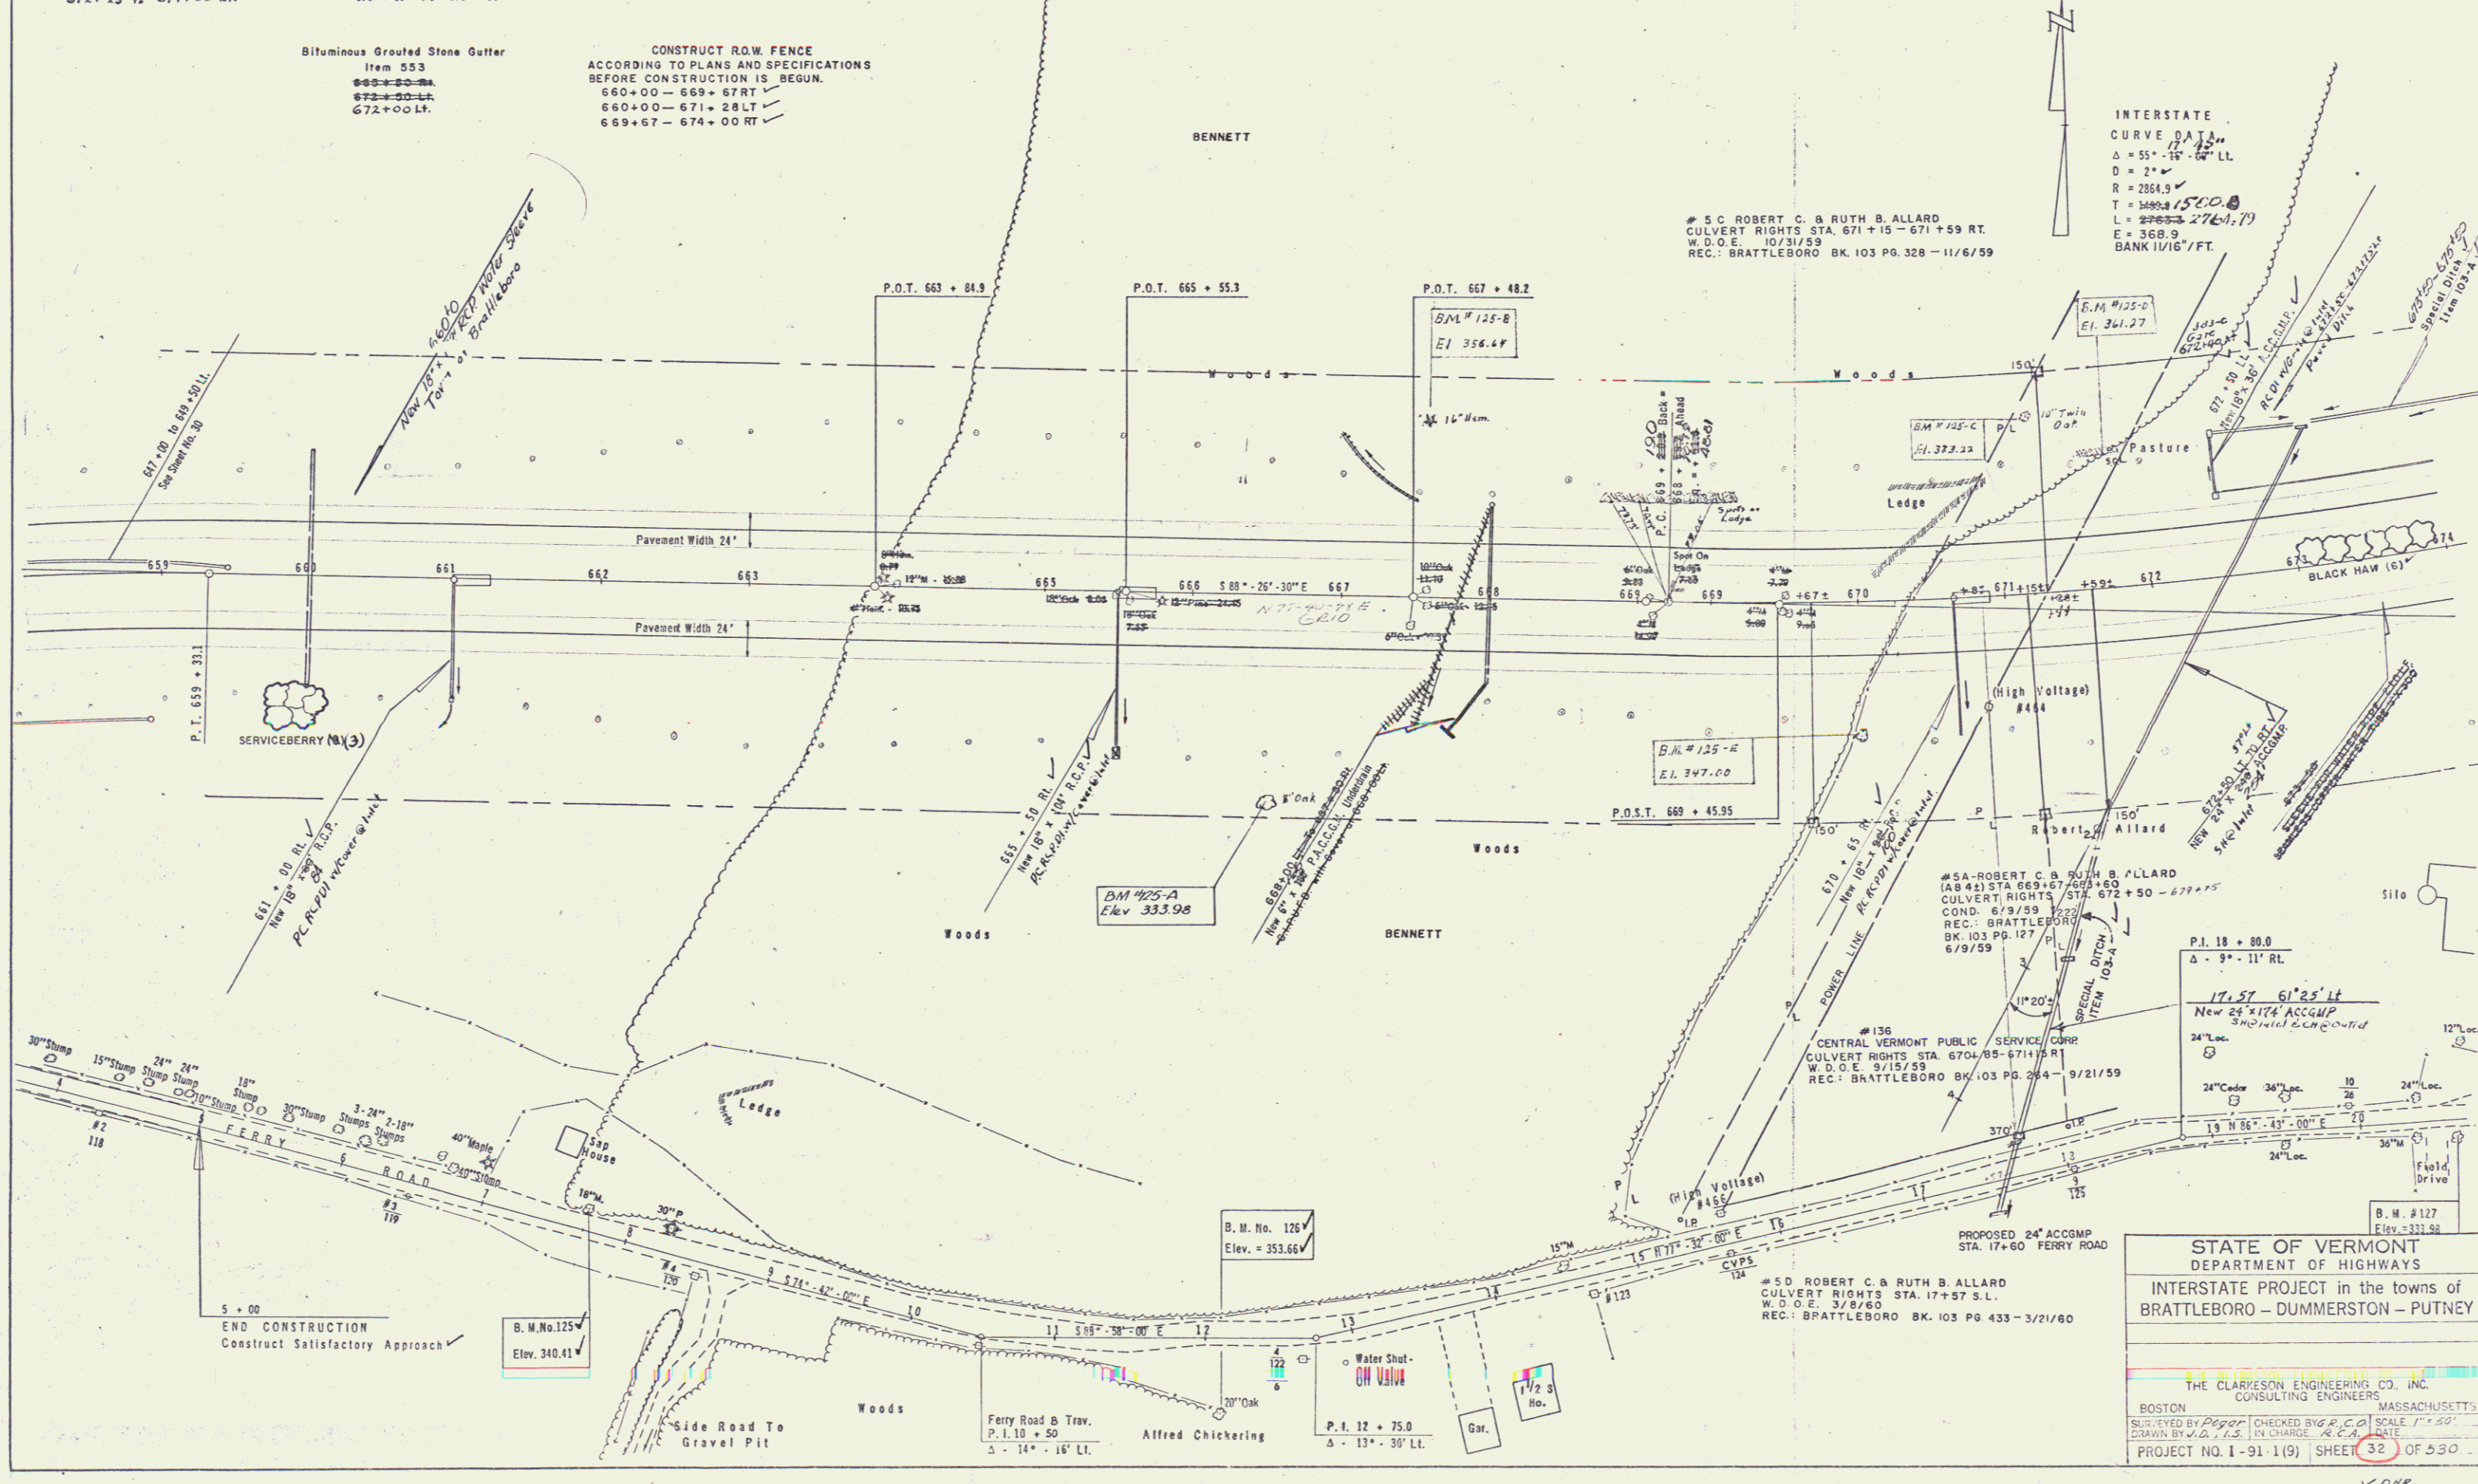

STATE OF VERMONT
DEPARTMENT OF HIGHWAYS
INTERSTATE PROJECT in the towns of
BRATTLEBORO - DUMMERSTON - PUTNEY

THE CLARIFSON ENGINEERING CO. INC.
CONSULTING ENGINEERS
BOSTON MASSACHUSETTS

SCALE 1" = 50'
PROJECT NO. 1-91-1(9) SHEET 32 OF 530