

CONSTRUCT R.O.W. FENCE
 ACCORDING TO PLANS AND SPECIFICATIONS
 BEFORE CONSTRUCTION IS BEGUN
 738+00 - 746+34 LT ✓
 746+34 - 752+21 LT ✓

Property Line Fence With Steel Posts
 Item No. 583-B
 738+00 to 746+00 RL 746+00 RT ✓
 738+00 to 754+00 LL ✓
 750+85 to 754+00 RT ✓

Paved Median Gutter
 Item No. 361-B
 740+50 To 742+50 ✓
 747+55 To 747+80 ✓
 753+25 To 753+50 ✓

Bituminous Grouted Stone Gutter
 Item No. 553
 746+51 To 747+55 RT ✓
 747+55 To 748+50 RT ✓
 748+50 RT ✓

Construct Special Ditch
 Item No. 103-A
 742+85 To 744+75 RT ✓
 743+80 To 750+80 RT ✓
 745+50 To 747+10 ✓


Three Cable Guard Rail With
 Steel Posts
 738+00 To 754+00 Lt. Median ✓
 742+85 To 744+75 RT ✓
 743+80 To 750+80 RT ✓
 745+50 To 747+10 ✓

Bituminous Concrete Curb Item No. 555
 743+00 To 751+00 Lt. Median
 742+85 To 744+75 RT ✓
 743+80 To 750+80 RT ✓

PLAN NO.	STATE	ED. ADMINISTRATION	POST	DATE	TOTAL SHEETS
1	VT.	1-91-1(9)	WAR	42	530

Curve Data For Left Lane
 $\Delta = 3^{\circ}35'41''$ R ✓
 $D = 0^{\circ}33'00''$ V ✓
 $R = 10,417.50'$ ✓
 $L = 656.77'$ ✓
 $T = 328.50'$ ✓
 $E = 5.18'$ ✓
 BANK 1/4" PER FT ✓

NOTE: Location of Underdrain to be determined by the Engineer

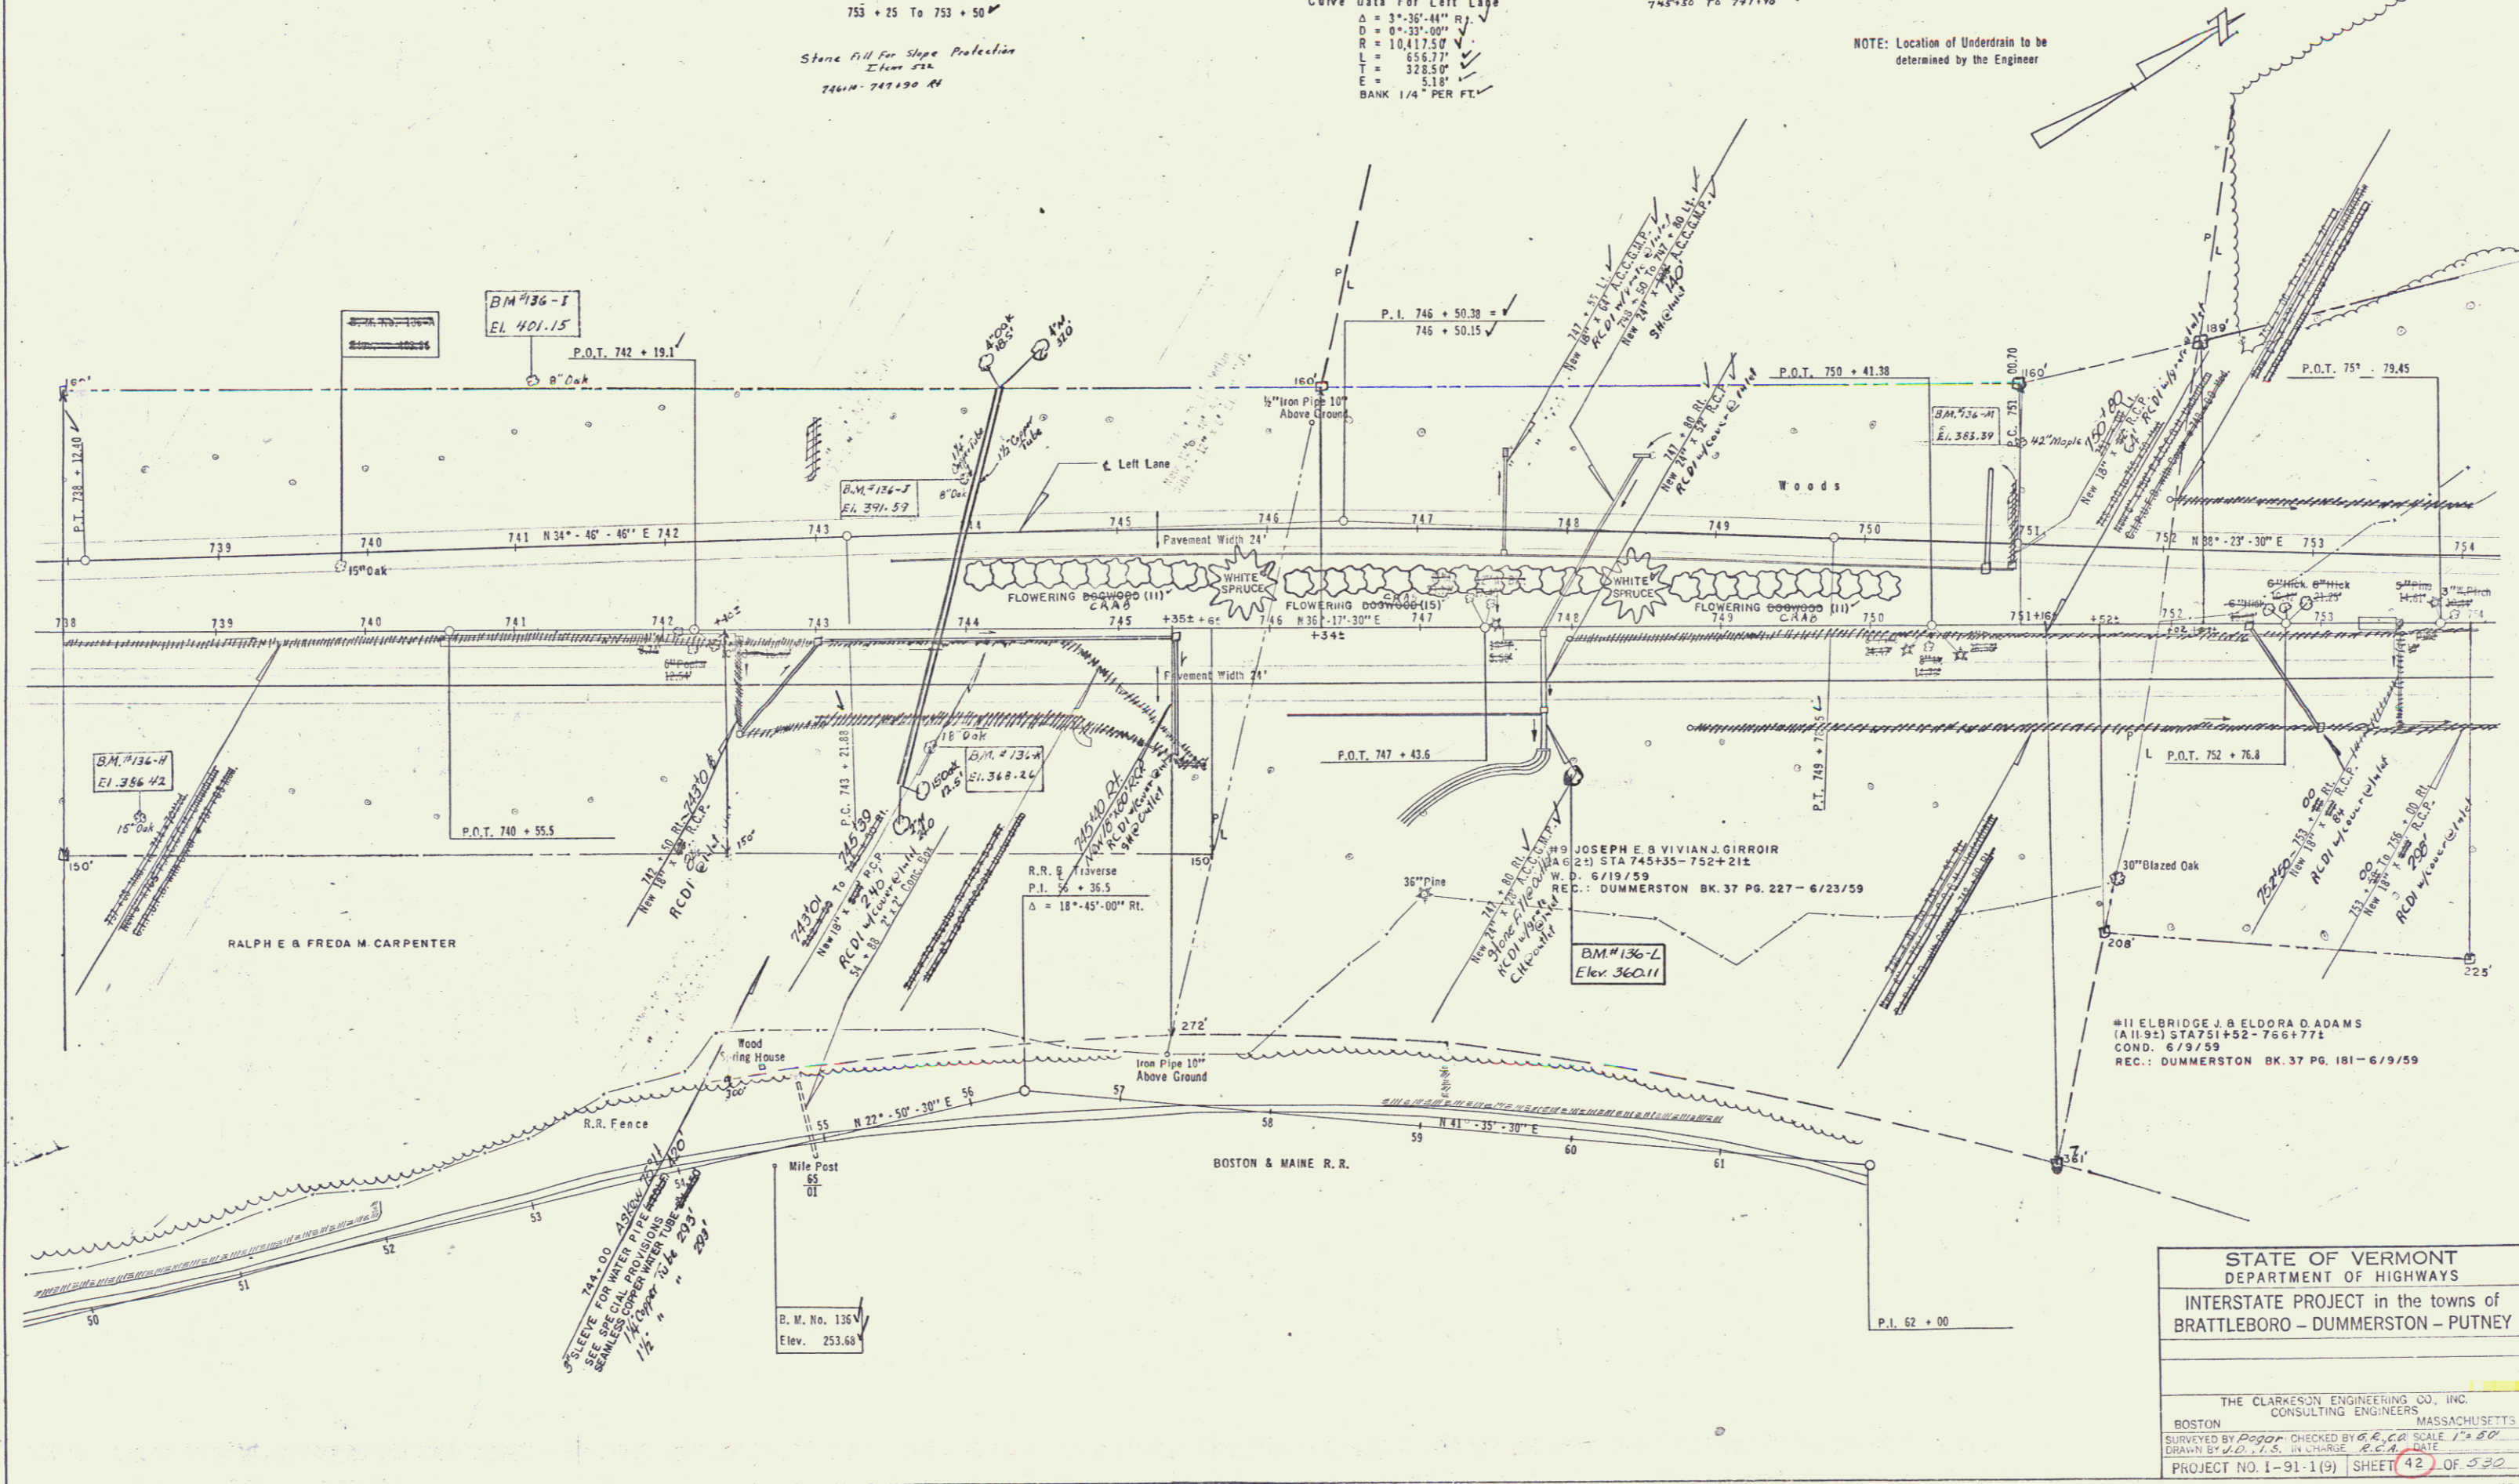

STATE OF VERMONT
 DEPARTMENT OF HIGHWAYS
 INTERSTATE PROJECT in the towns of
 BRATTLEBORO - DUMMERSTON - PUTNEY

THE CLARKSON ENGINEERING CO., INC.
 CONSULTING ENGINEERS
 BOSTON MASSACHUSETTS
 SURVEYED BY *Rogor* CHECKED BY *E.C.G.* SCALE 1" = 80'
 DRAWN BY *W.D.* IN CHARGE *E.C.G.* DATE
 PROJECT NO. 1-91-1(9) SHEET 42 OF 530