


ACQUIRED FROM ALFRED W. & ANNA K. SMITH
 BY CONDEMNATION 9-25-1956 RECORDED IN
 BK. 33 PGS. 349-365 ON 10-19-1956

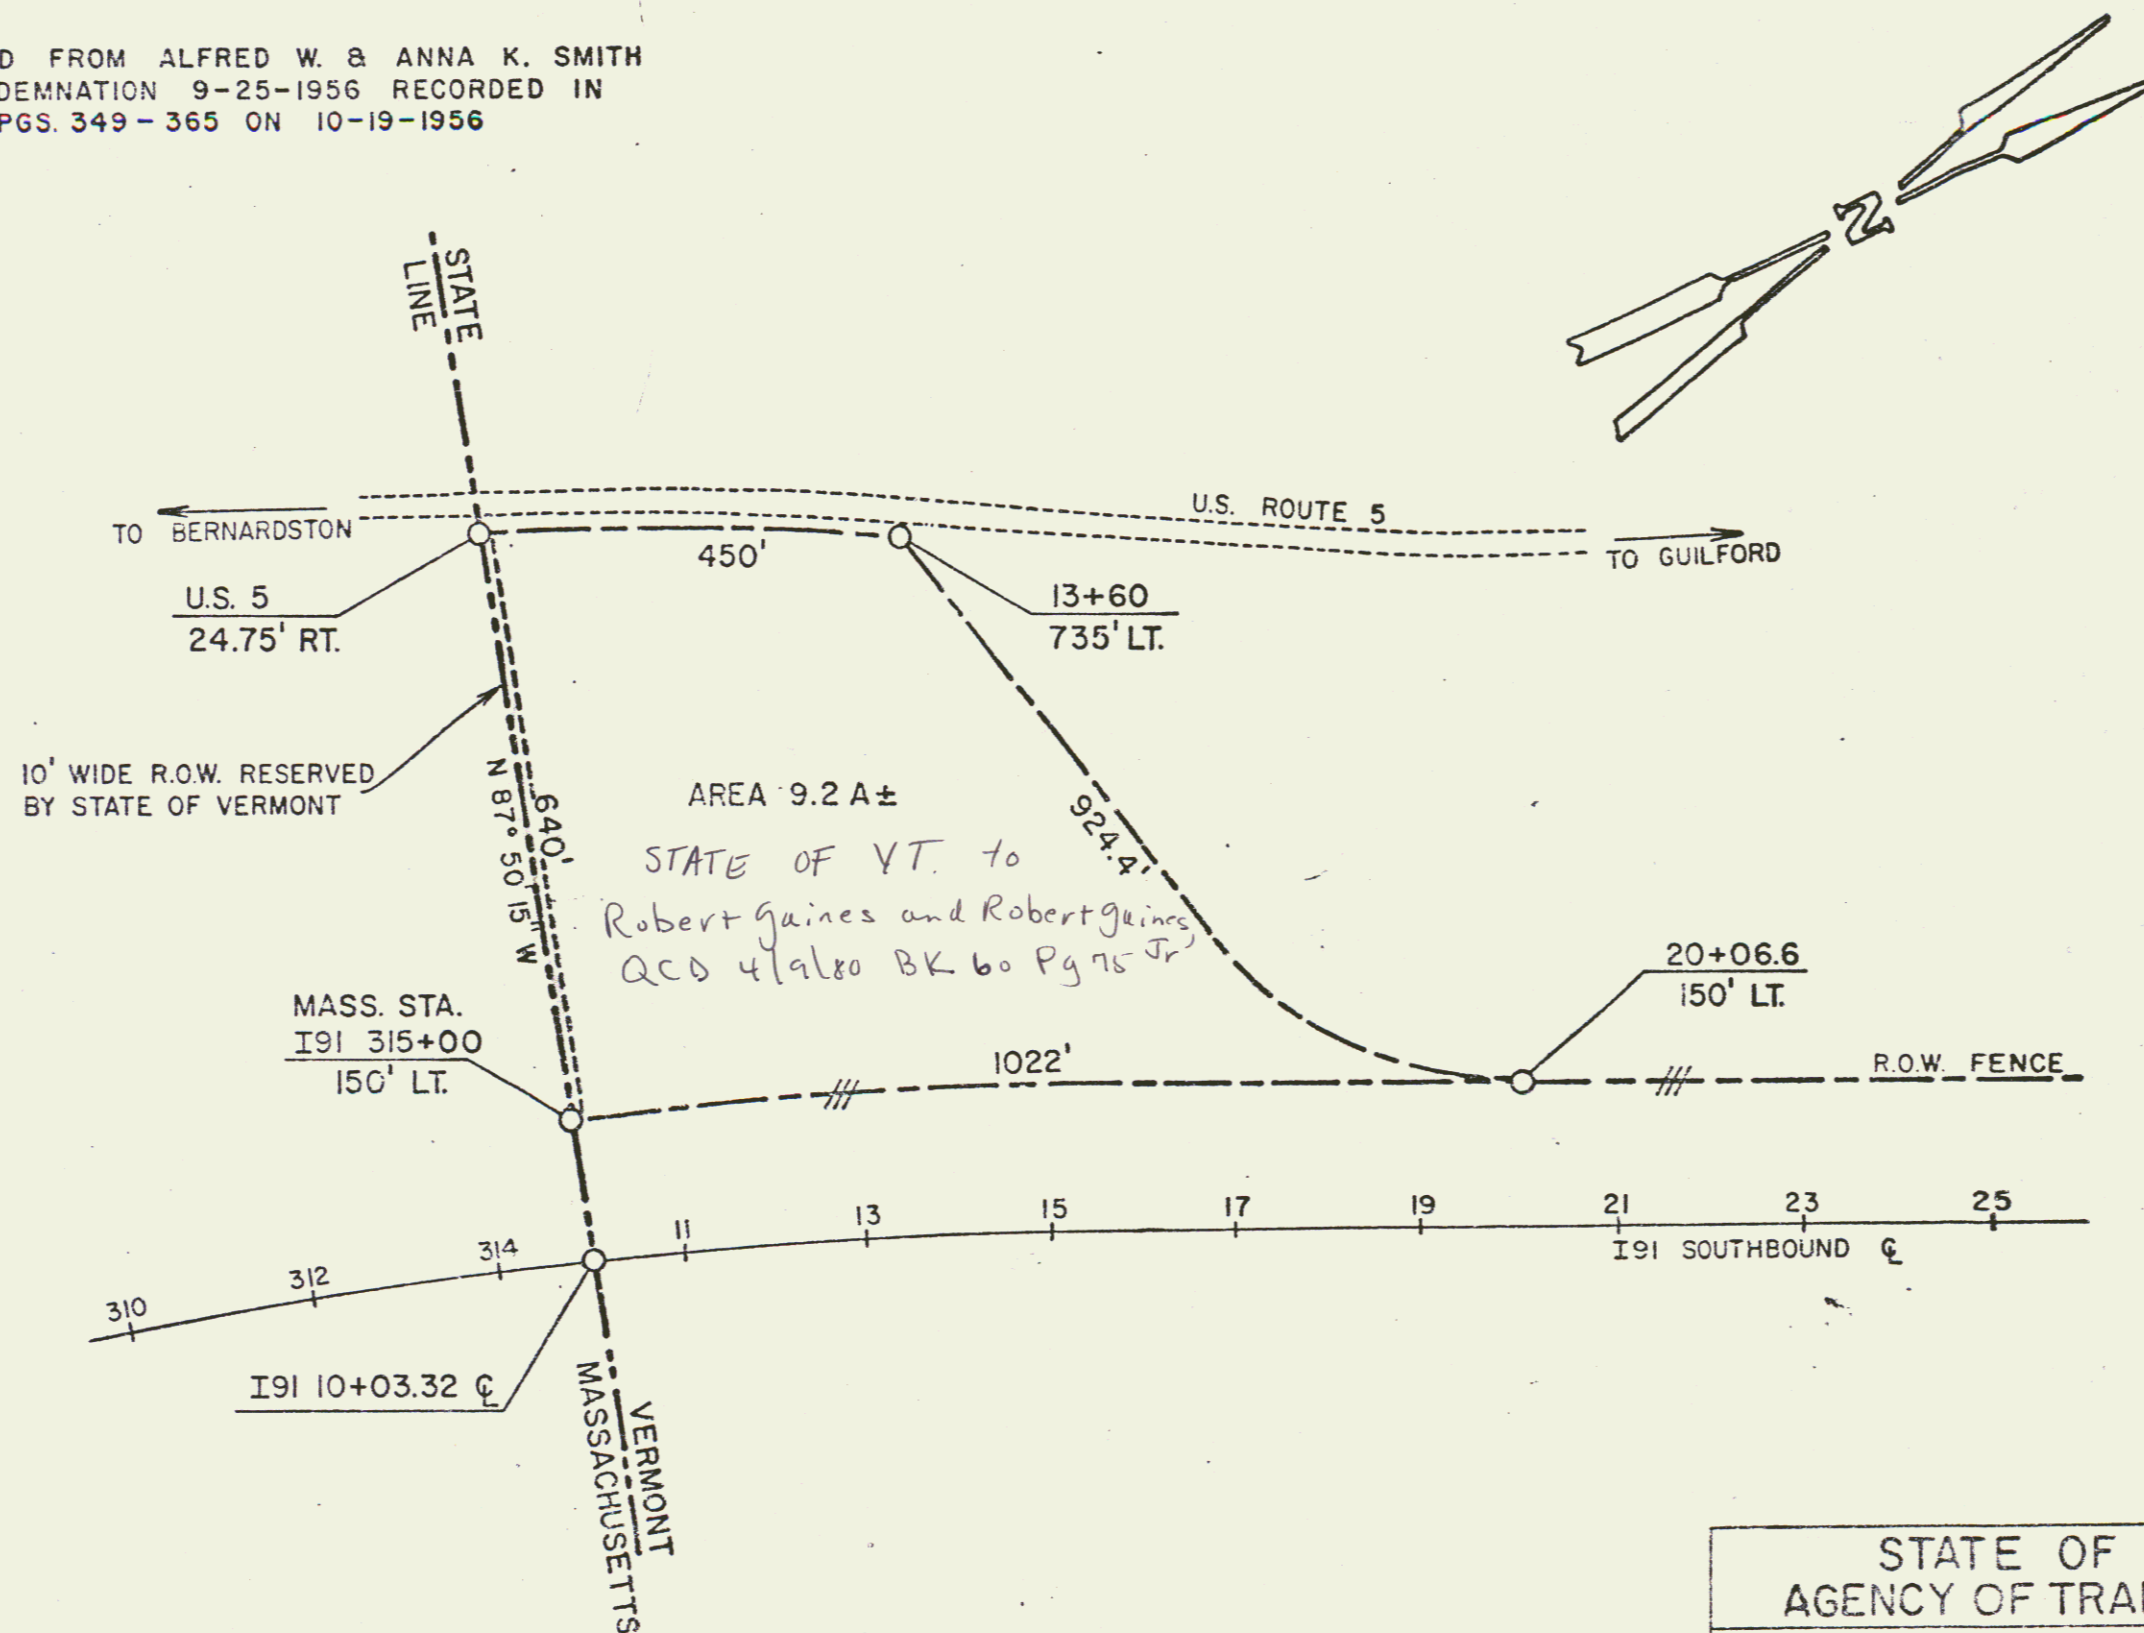

STATE OF VERMONT
 AGENCY OF TRANSPORTATION
 TOWN OF GUILFORD
 PROJECT FI-IN-001-1
 APPROX. SCALE = 200' DATE 1/11/80 DRAWN BY B.A.M.

REV. 4/1/80

18A