


PLAN  
 TO  
 POSITION  
 CHECKED  
 DATE  
 5/15/73  
 644-838  
 NO. 3 414  
 798

PLAN  
 TO  
 POSITION  
 CHECKED  
 DATE  
 5/15/73  
 644-838  
 NO. 3 414  
 798

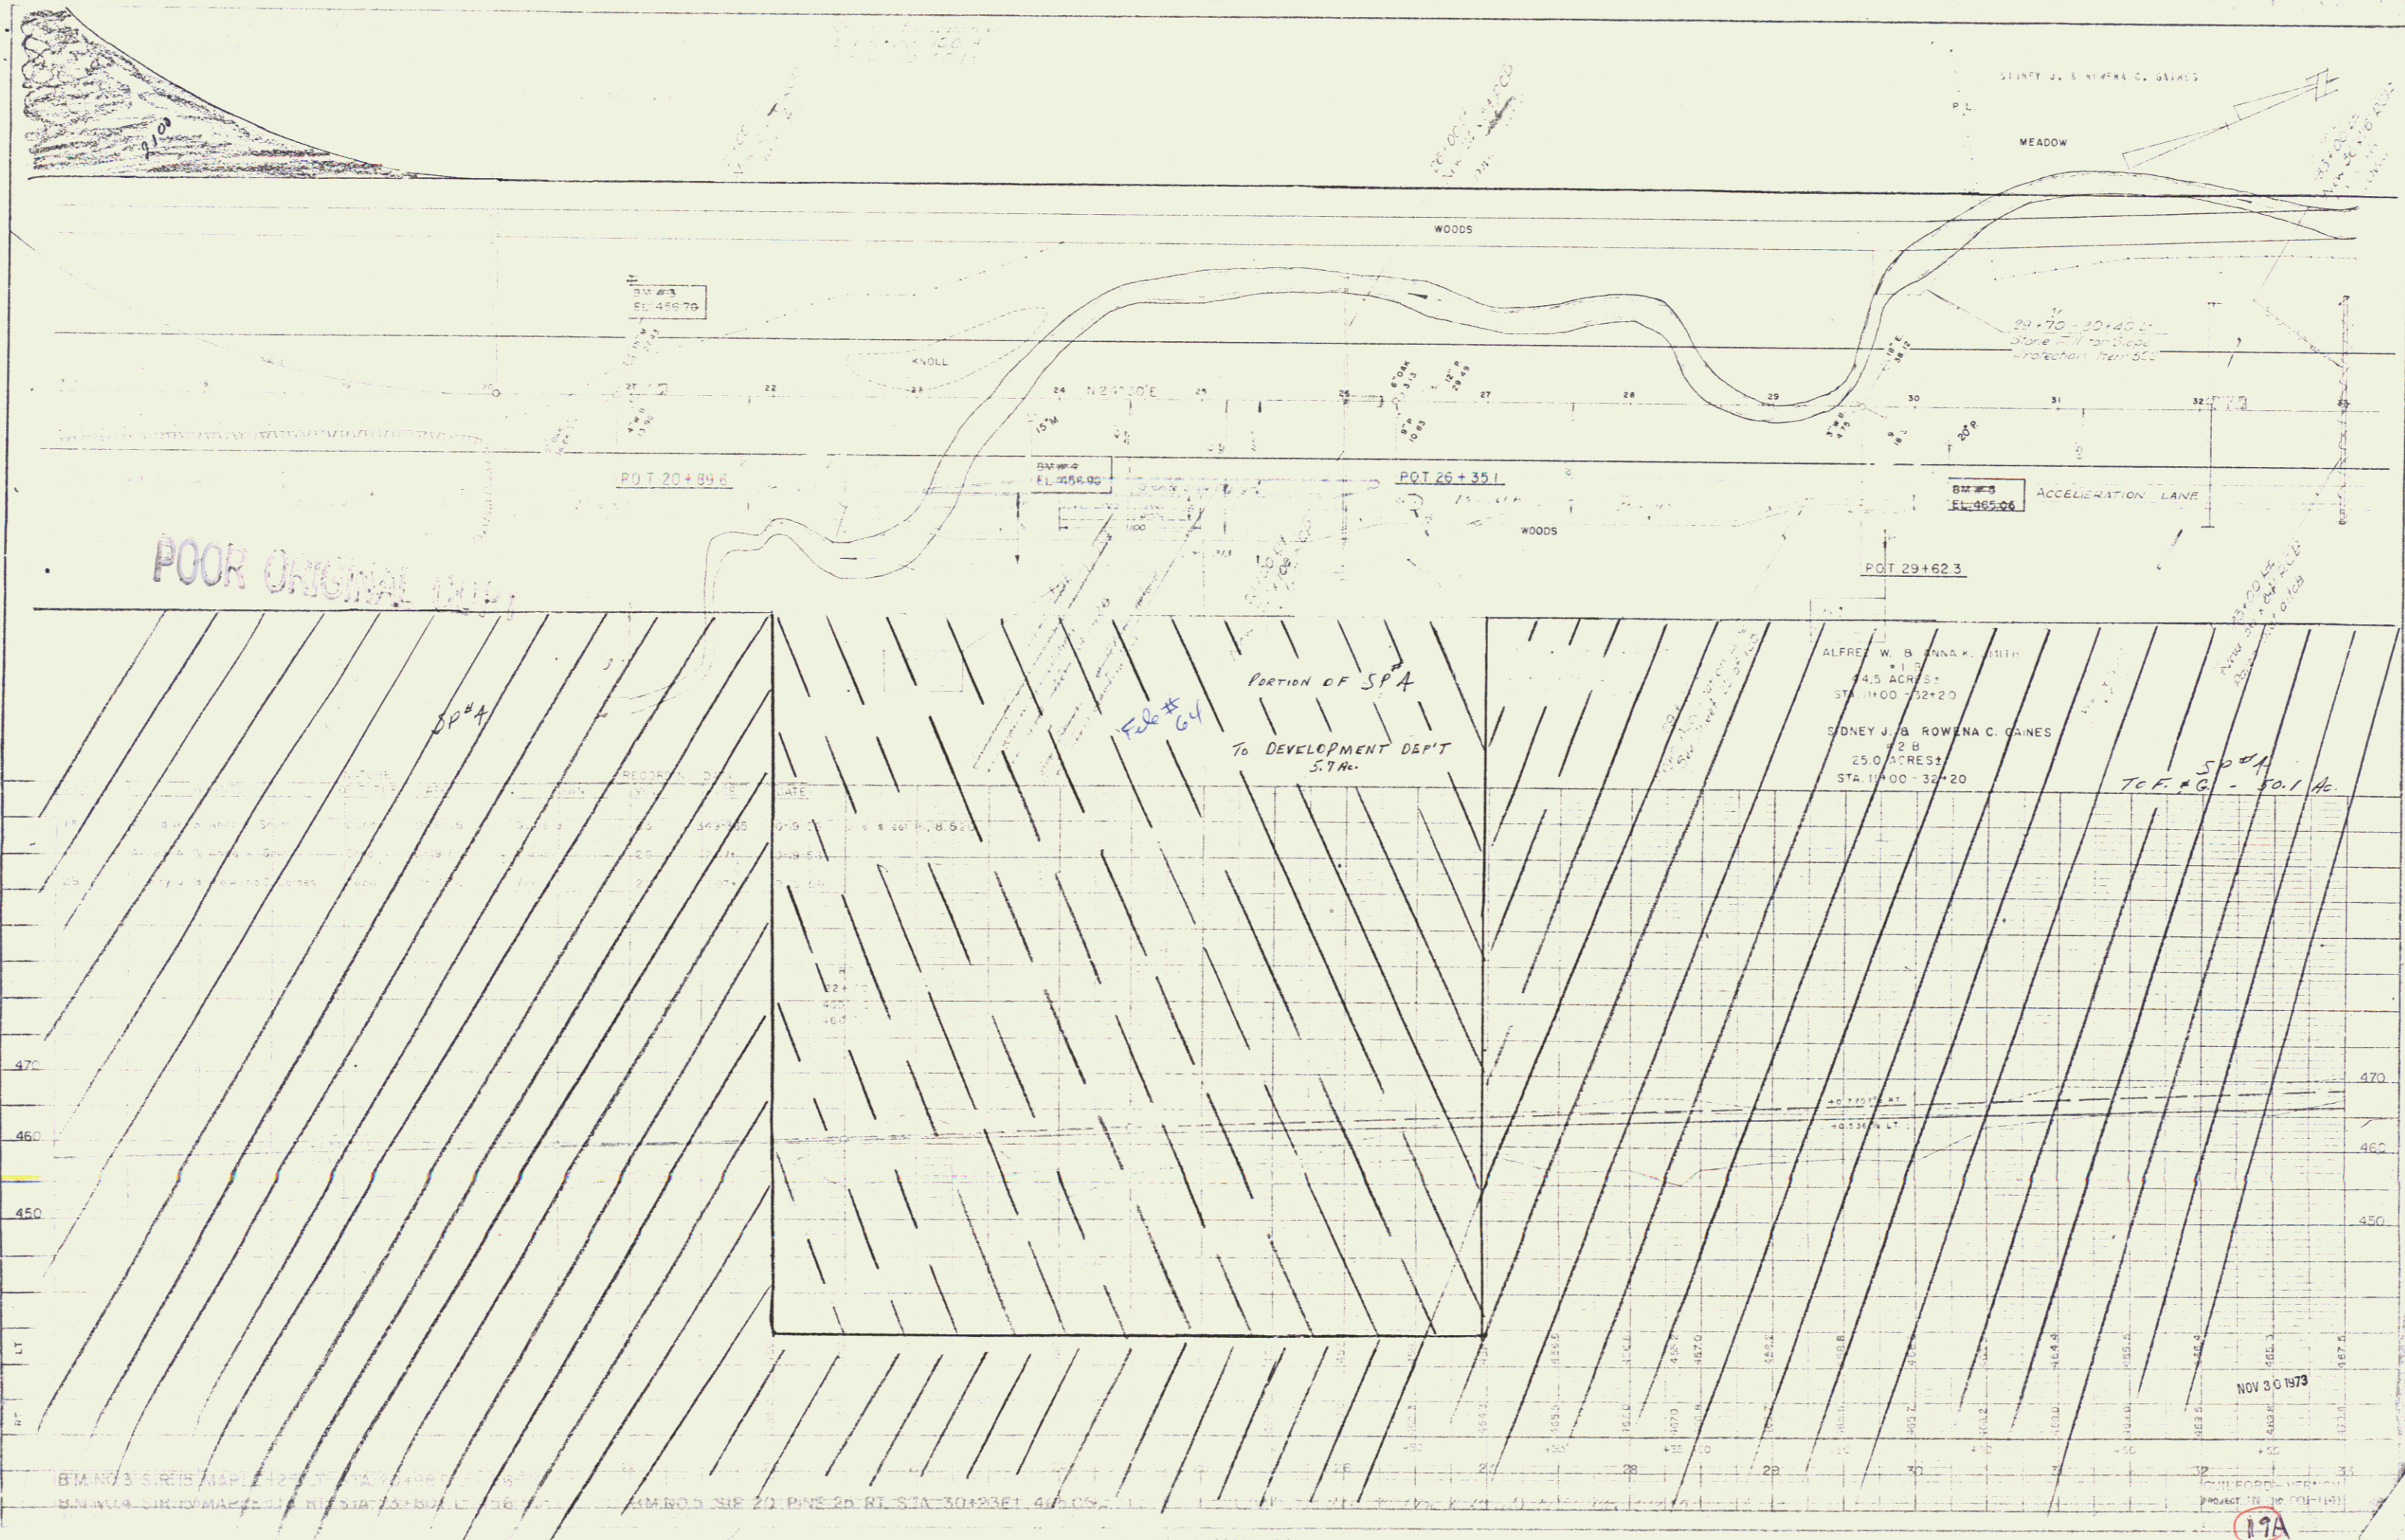

POOR ORIGINAL Dwg.

CP#4

File # 64

PORTION OF SPA  
 TO DEVELOPMENT DEPT  
 5.7 AC.

ALFRED W. B. ANNA K. SMITH  
 14.5 ACRES  
 STA 1+00 - 52+20

SIDNEY J. & ROWENA C. GAINES  
 25.0 ACRES  
 STA 1+00 - 32+20

SP#4  
 T.C.F. # G. - 50.1 AC.

NOV 30 1973

17A

7