


PLAN
 DATE: 3/75
 DRAWN BY: J.A.S.
 CHECKED BY: J.A.S.
 NO. 17/85

NOTE BOOK
 GRADE CHECKED
 STRUCTURE SET AS CLASS

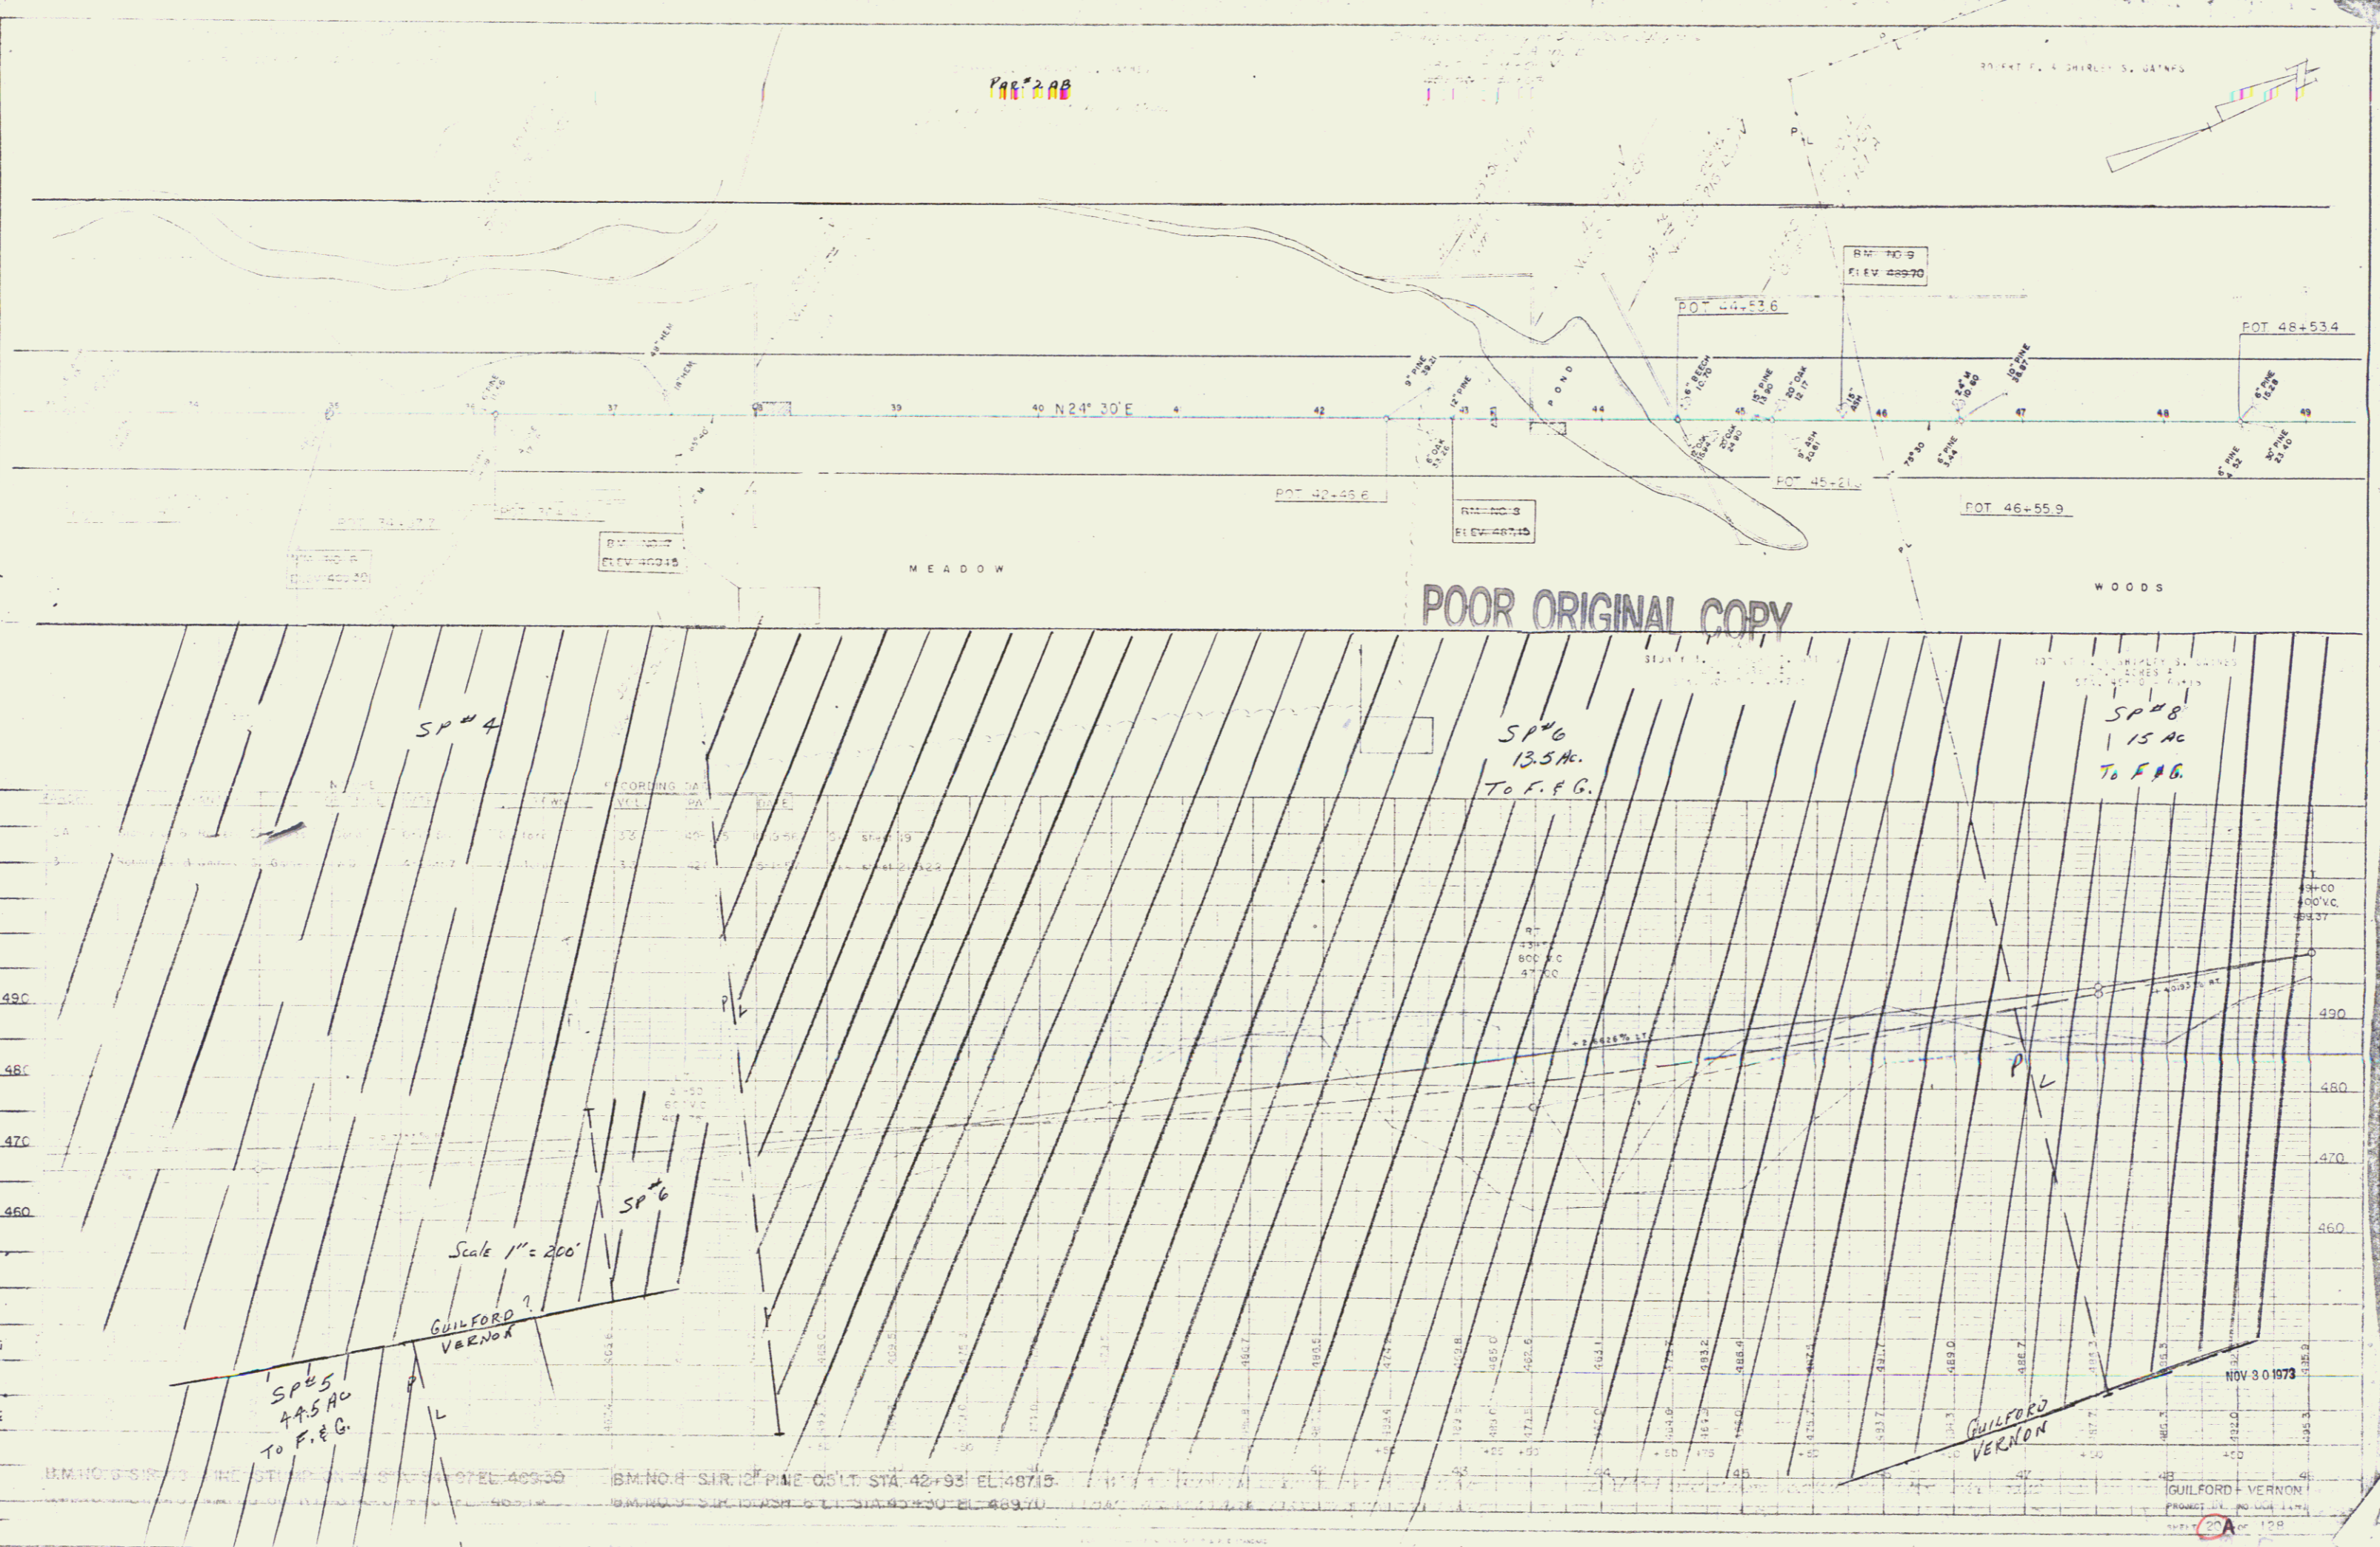

B.M. NO. 3 S.S. 73 IN STATION 42+30 EL. 469.35
 B.M. NO. 4 S.S. 12 PINE C&L STA. 42+93 EL. 487.15
 B.M. NO. 5 S.S. 12 PINE C&L STA. 43+30 EL. 489.70

NOV 30 1973
 GUILFORD VERNON
 PROJECT NO. 10000 1474
 SHEET 108