


PLAN
 DATE 4/23/88
 DRAWN BY J. A. B. JR.
 CHECKED BY [Signature]
 TRACED BY [Signature]

NOTE BOOK NO. 12
 DATE 4/23/88
 DRAWN BY J. A. B. JR.
 CHECKED BY [Signature]
 TRACED BY [Signature]

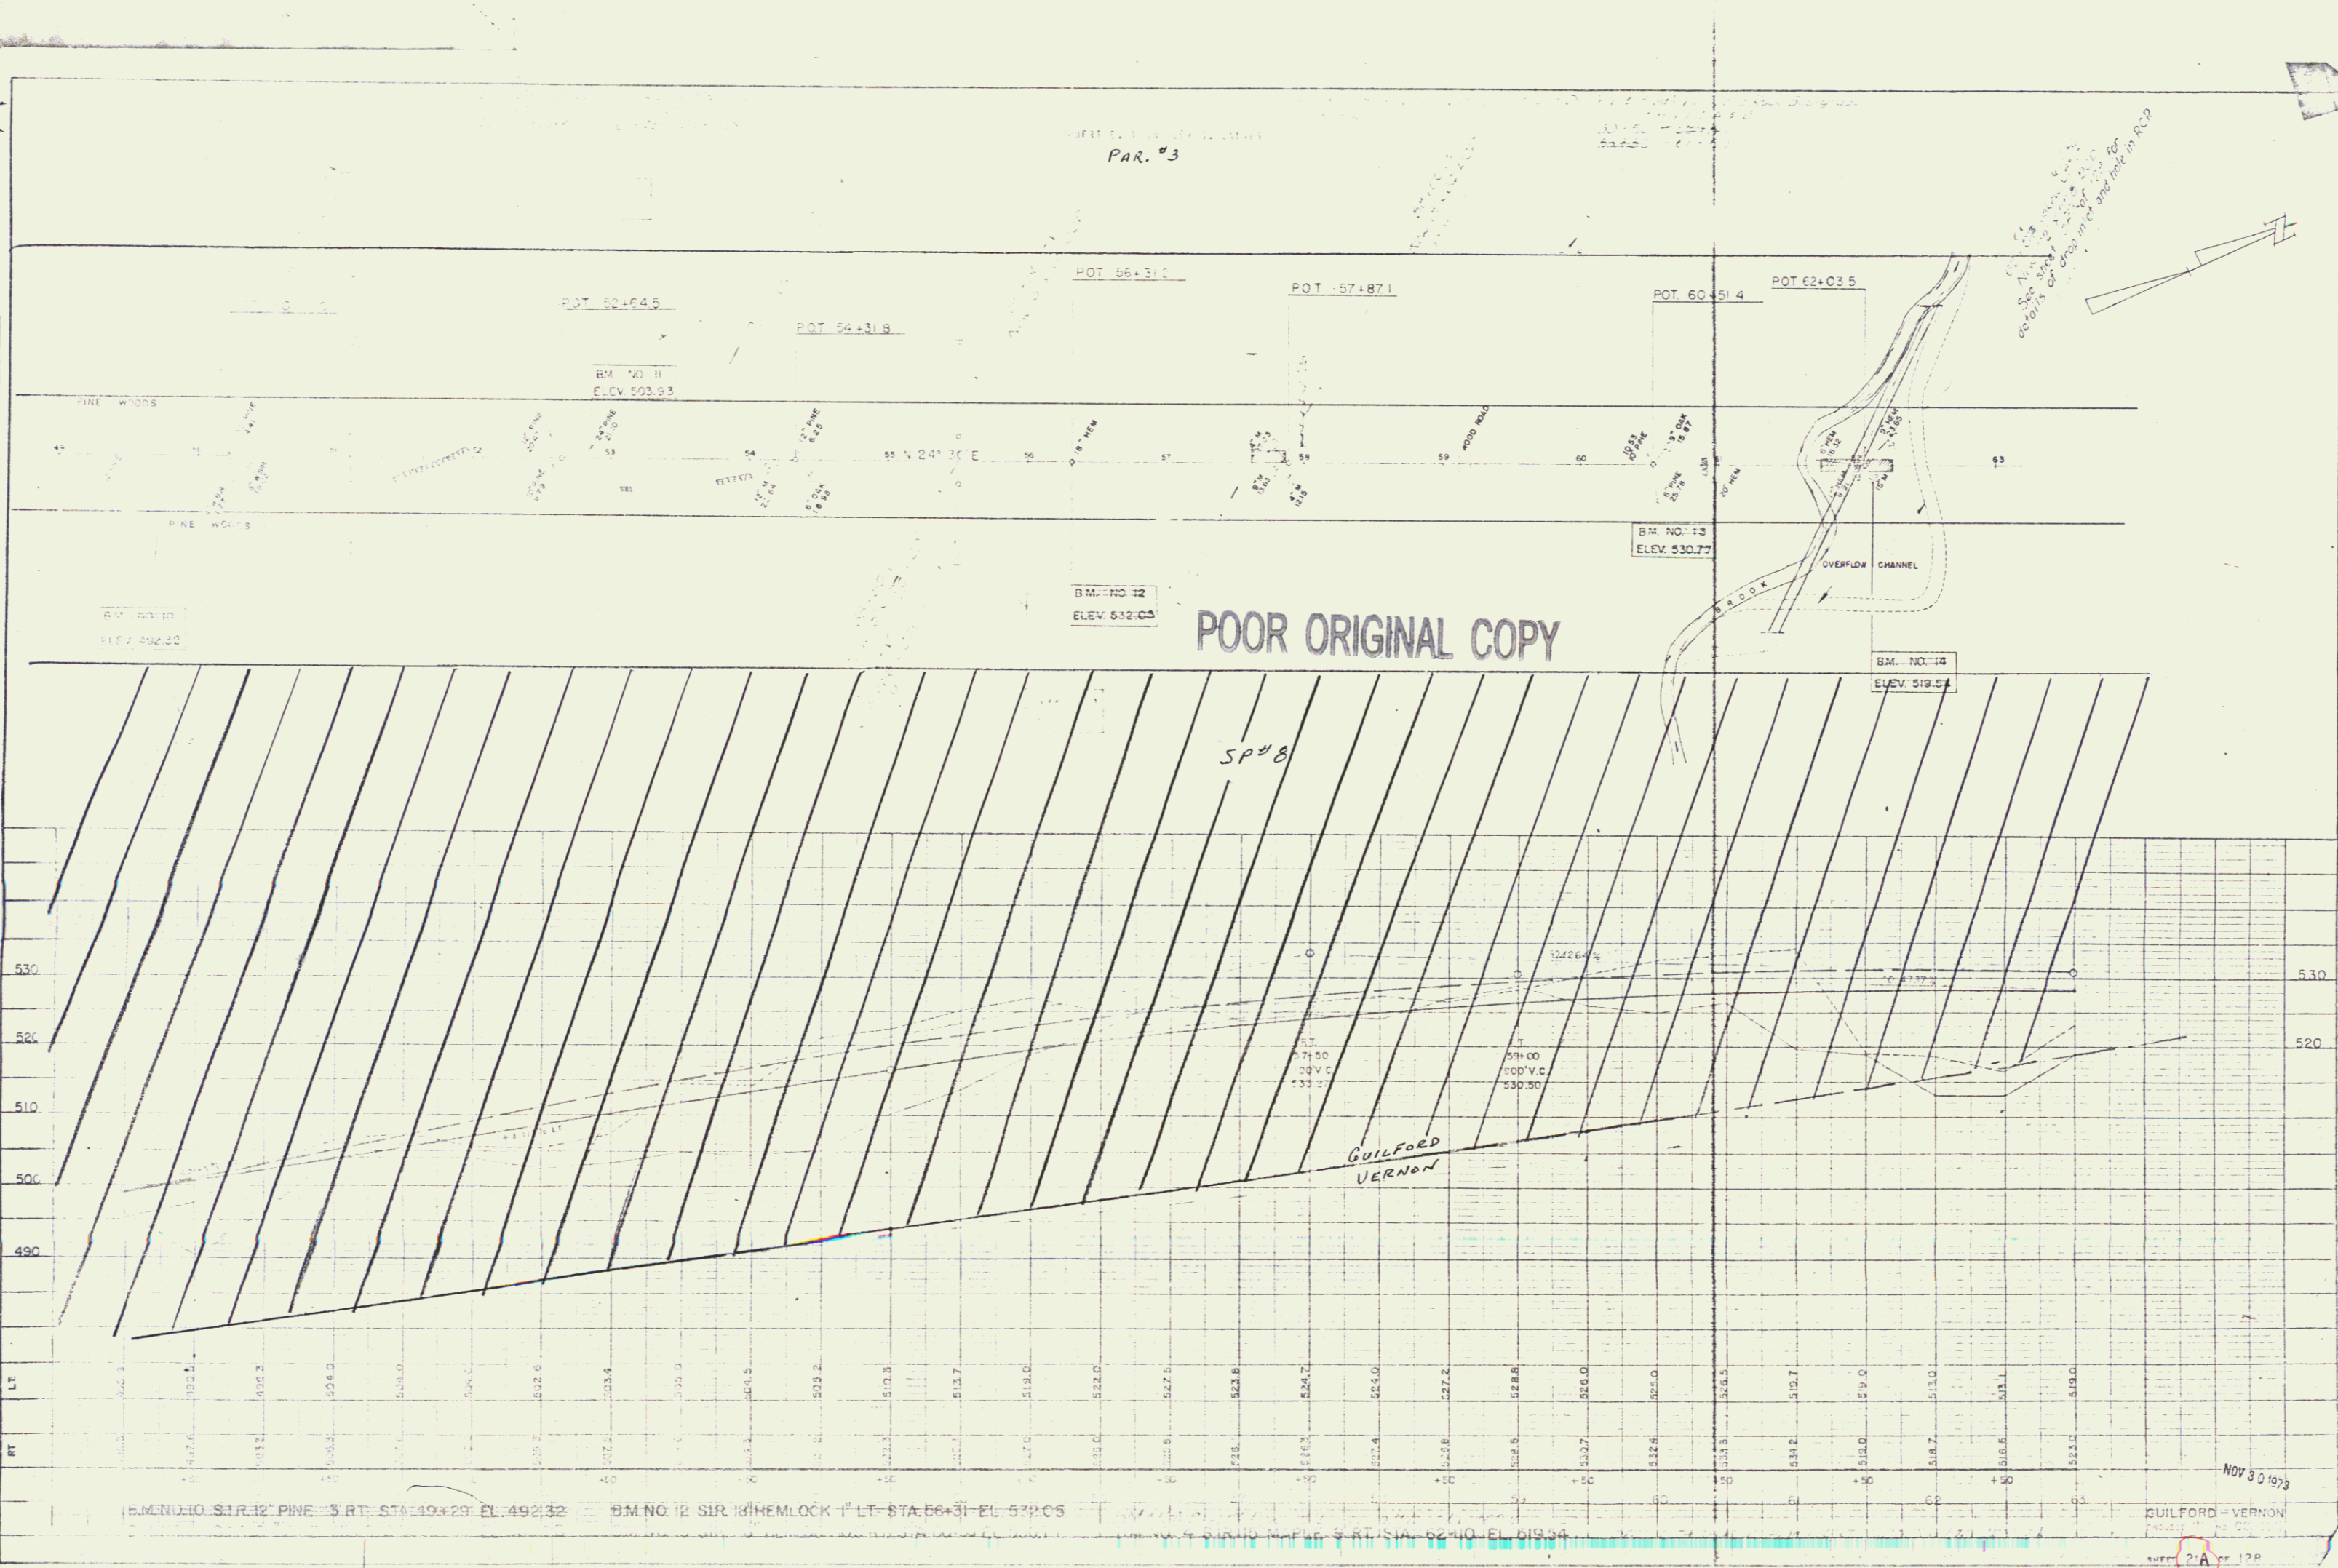

BM NO. 10 SIR. 12 PINE 5 RT STA. 49+29 EL. 492.32
 BM NO. 12 SIR. 18 HEMLOCK 1 LT STA. 56+31 EL. 512.05
 BM NO. 13 SIR. 18 PINE 5 RT STA. 52+40 EL. 519.94
 GUILFORD - VERNON
 NOV 8 0 AM '88