

Drilling and Blasting of Solid Rock Subgrade


2-1/2" Items 114, 115  
65'50" - 67'50"  
70'50" - 72'50"  
67'20" - 74'10"

Permanently E. Gabel Marker in Station  
PC Sta. 63+15.1


Gates for Property Line Fence  
72+56 - 72+68, E.T.

Blank Court Road w/Point 1 from SA-B  
6A+50 LL

PLAN OF REST AREAS 73+00 - 76+20 RT. B 174+00 - 177+20 LT.

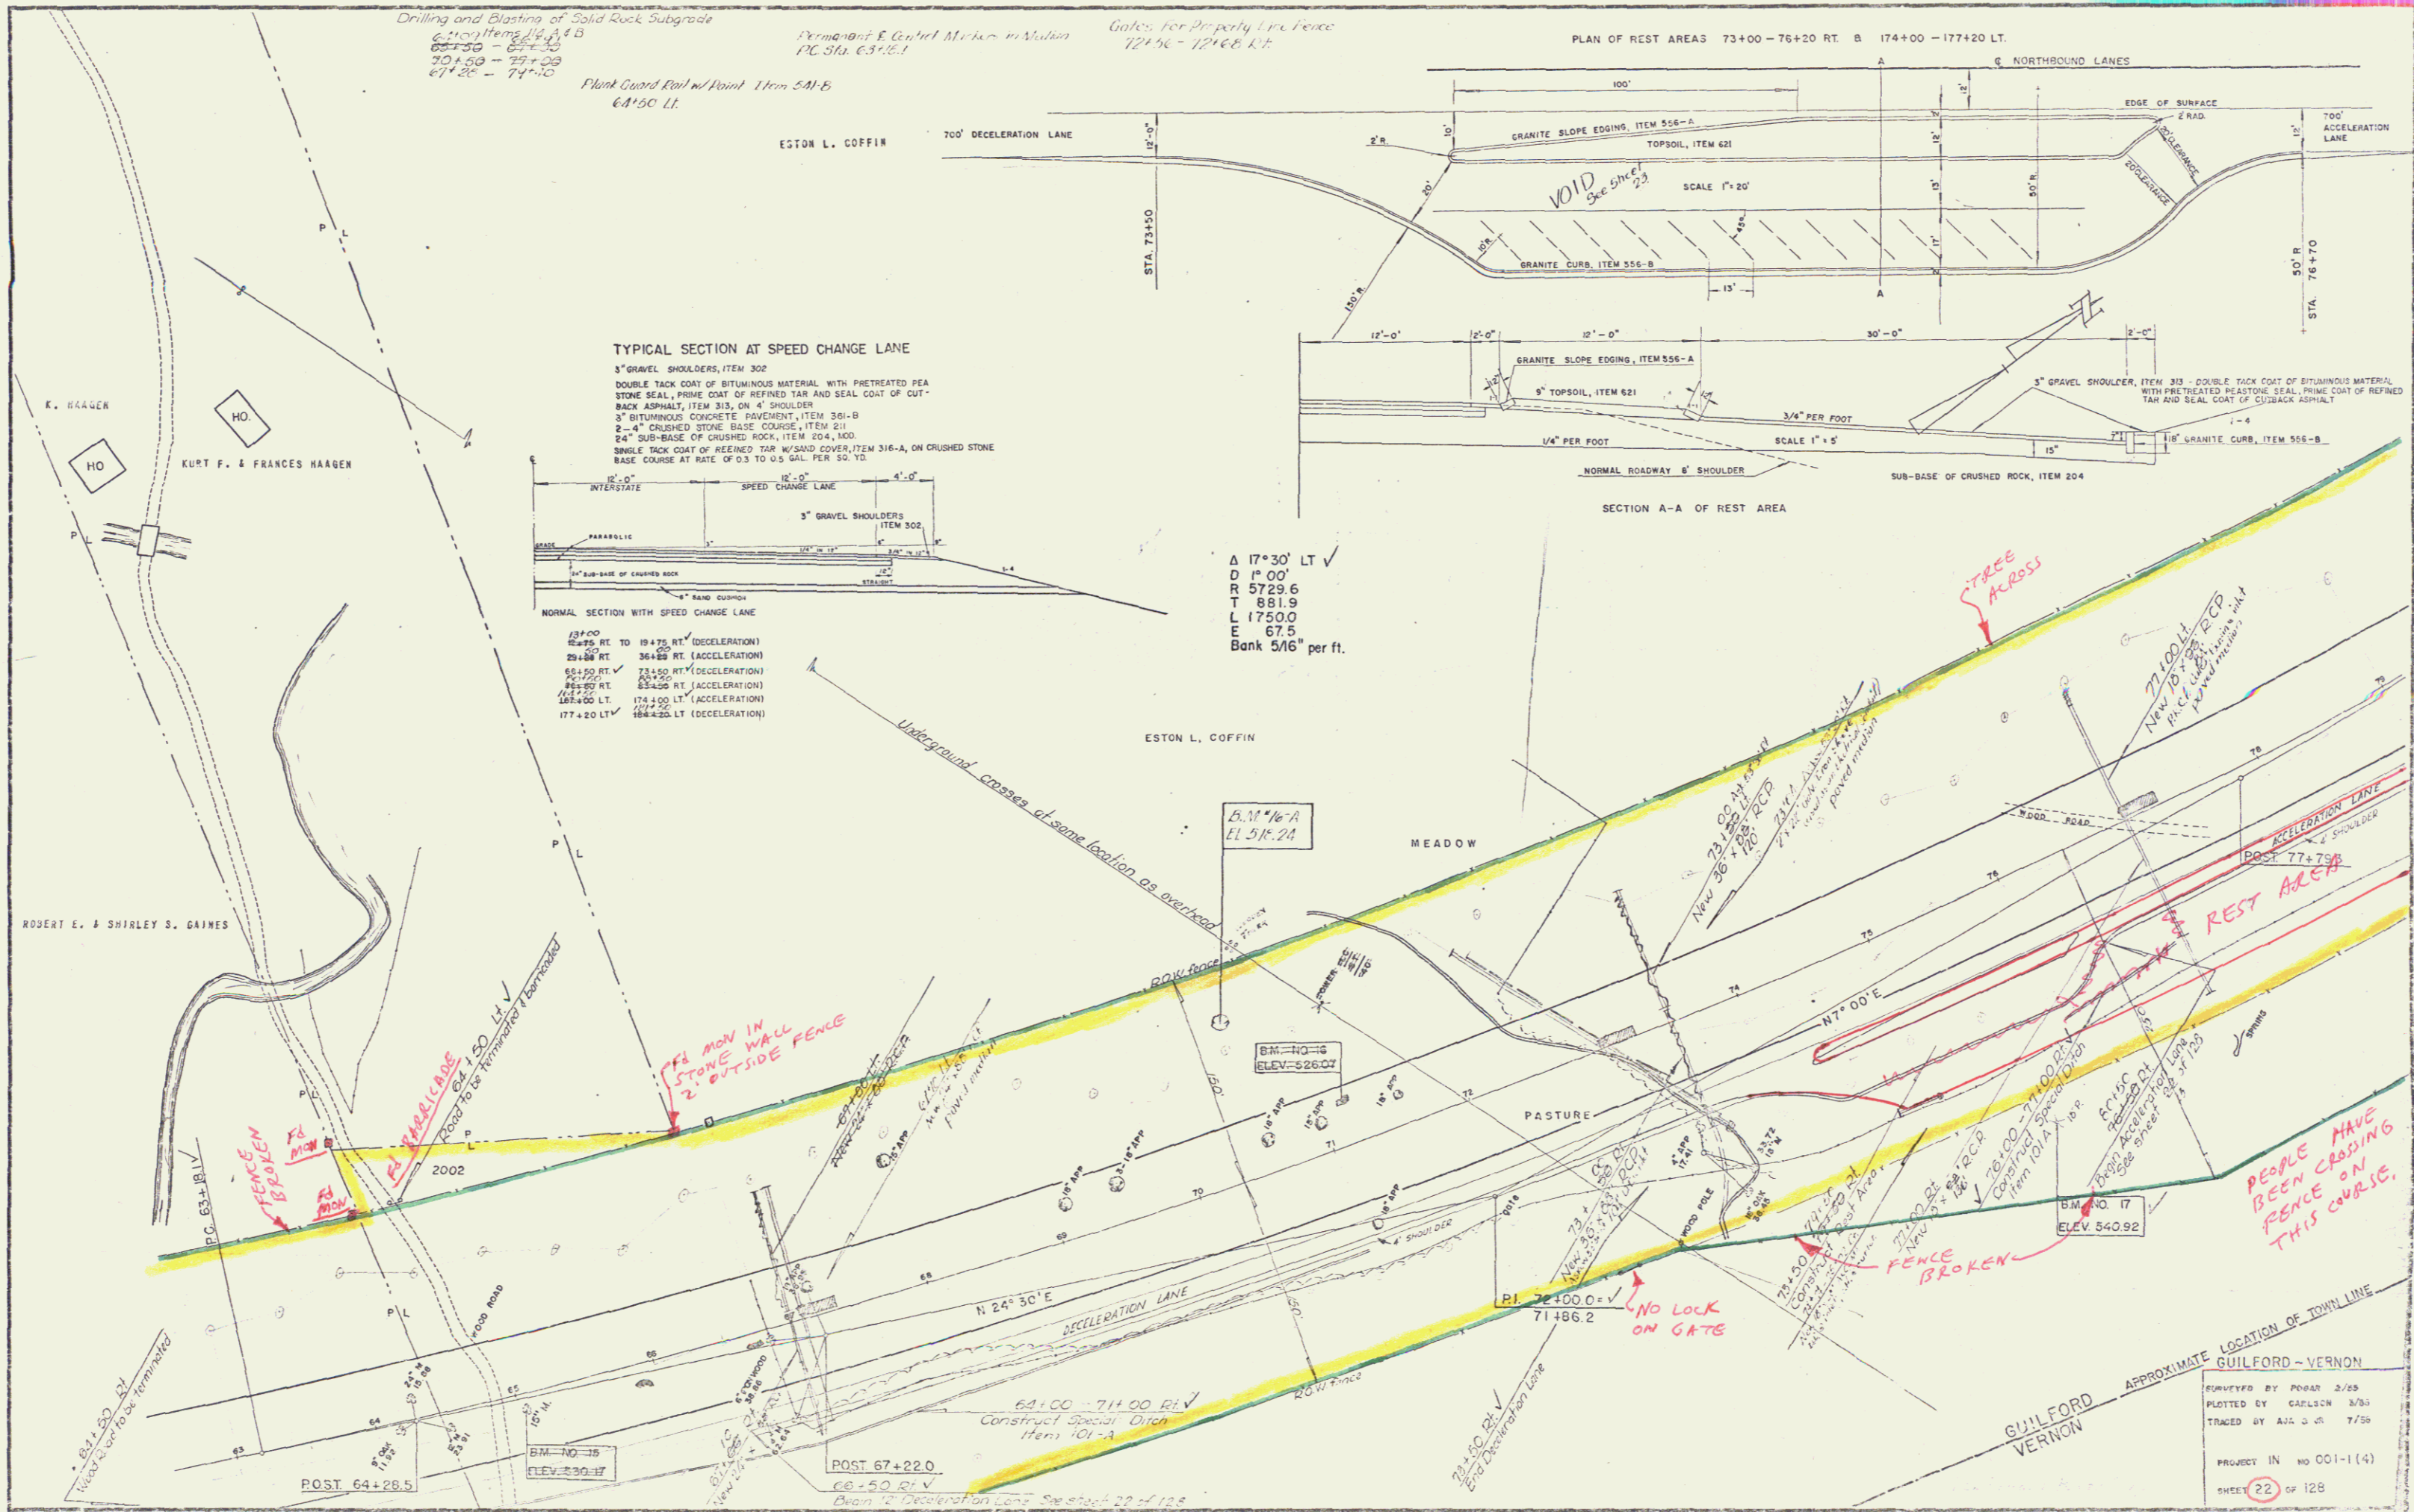

TYPICAL SECTION AT SPEED CHANGE LANE

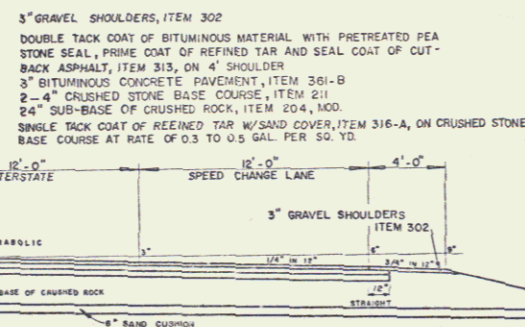

NORMAL SECTION WITH SPEED CHANGE LANE

134+00	RT	19+75	RT	(DECELERATION)
29+84	RT	36+88	RT	(ACCELERATION)
61+20	RT	73+50	RT	(DECELERATION)
81+20	RT	83+00	RT	(ACCELERATION)
167+00	LT	172+50	LT	(DECELERATION)
188+00	LT	177+20	LT	(DECELERATION)

Δ 17°30' LT V  
D 17'00"  
R 5729.6  
T 881.9  
L 1750.0  
E 67.5  
Bank 5/16" per ft.

APPROXIMATE LOCATION OF TOWN LINE  
GUILFORD - VERNON  
FORWARDED BY PERAR 3/25  
PLOTTED BY CARLSON 3/25  
TRACED BY A.J. 7/59  
PROJECT IN NO 001-1(4)  
SHEET 22 OF 128