



PLAN
 P.C. CARLSON
 7/58
 A.A. & J.F.

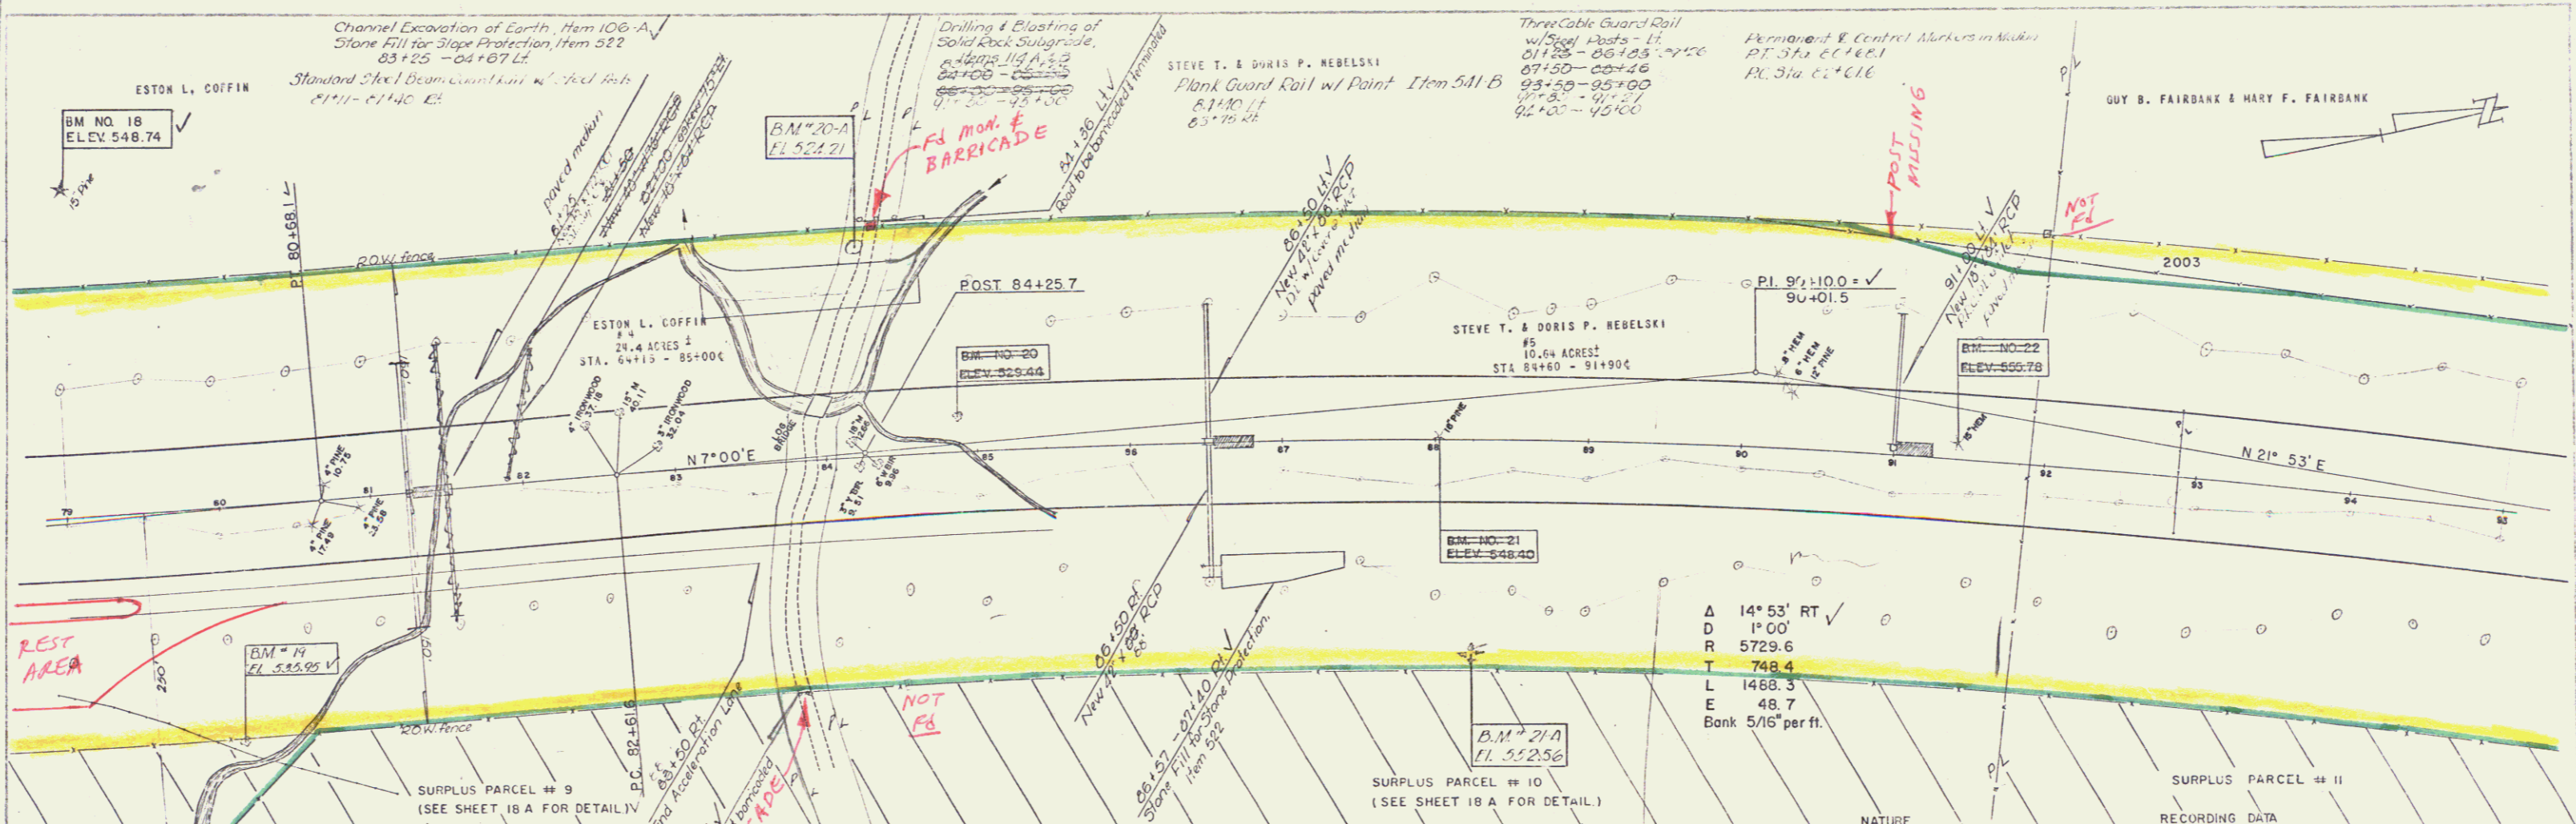

PARCEL	GRANTOR	NATURE OF TITLE	DATE	TOWN	RECORDING DATA	DATE
4	Eston L. Coffin	W.D.	4-22-57	Guilford	33 424	5-1-57 See sheet 22
5	Steve T. & Doris P. Nebelski	Cond	10-19-56	Guilford	33 349-365	10-19-56

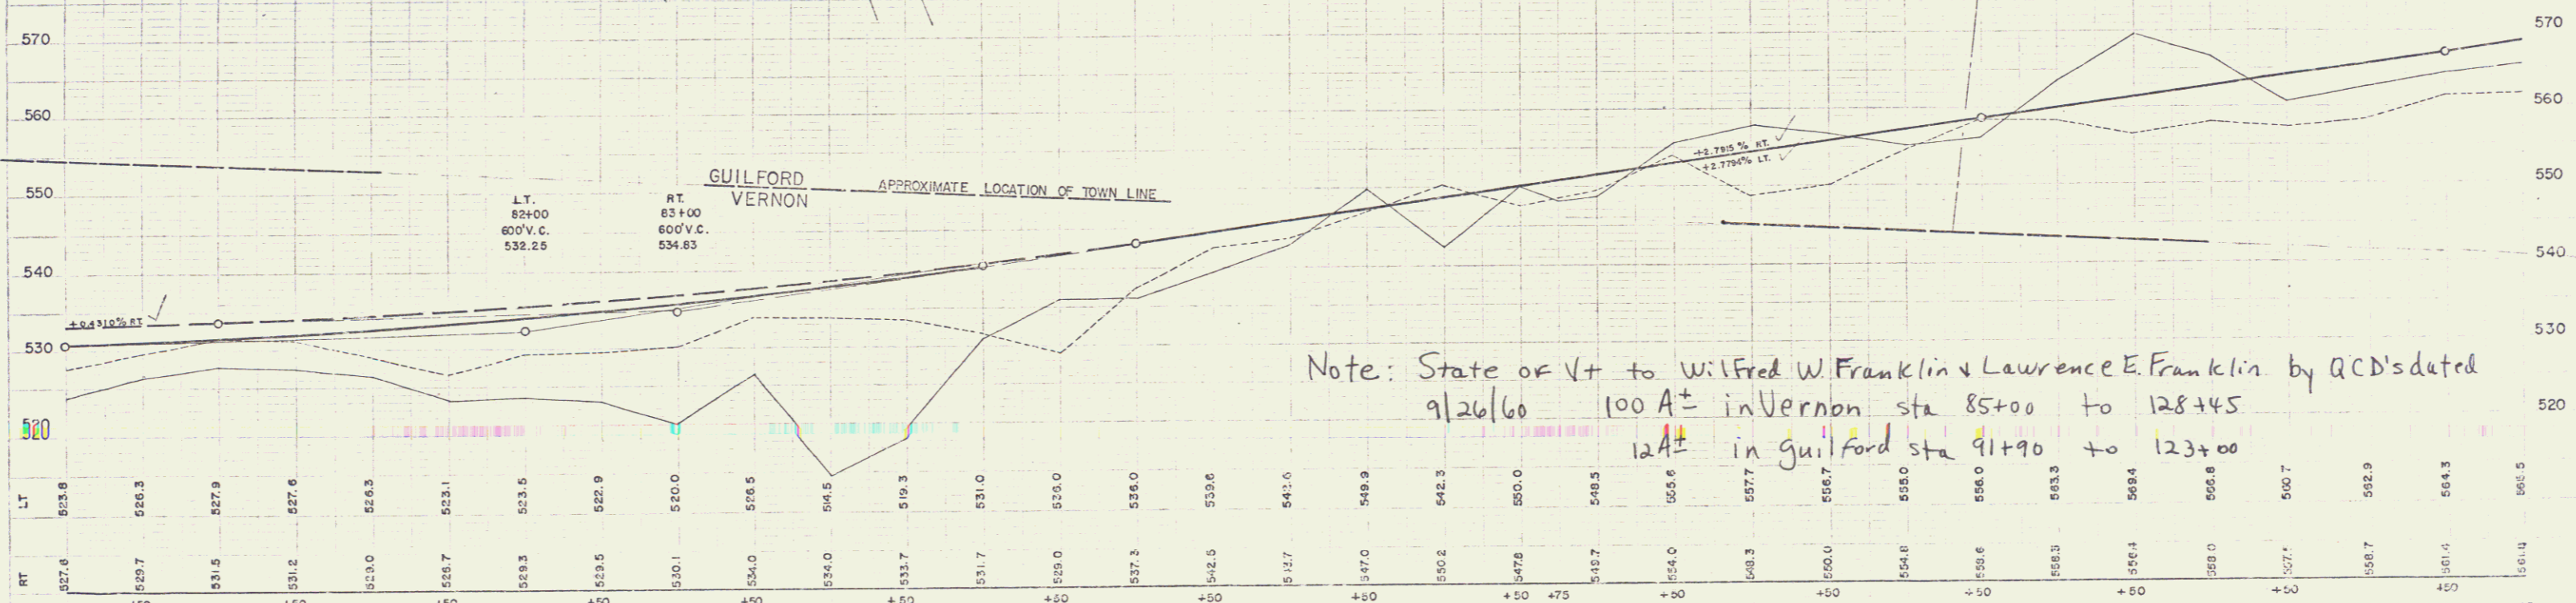

79 BM.NO.18 S.I.T. 15" PINE 215' RT. STA. 79+05 EL. 548.74
 80 BM.NO.19 S.I.T. 18" MAPLE 155' RT. STA. 80+00 EL. 535.95
 81
 82
 83 BM.NO.20 S.I.T. 24" MAPLE 22' LT. STA. 81+67 EL. 529.14
 84 BM.NO.21 S.I.T. 18" PINE 3' LT. STA. 89+02 EL. 548.40
 85
 86
 87
 88 BM.NO.22 S.I.T. 15" HEMLOCK 10' LT. STA. 91+41 EL. 555.78
 89
 90
 91
 92
 93
 94
 95
 GUILFORD - VERNON
 PRODUCT III NO. 001-1(4)
 SHEET 20 OF 128