

BM NO. 18
ELEV 548.74

POST 84+25.7

BM NO. 20
ELEV 529.44



PI 30+10.0
30+01.6

BM NO. 22
ELEV 555.78

BM NO. 21
ELEV 548.40

Δ 14° 53' RT
D 1° 00'
R 5729.6
T 748.4

POOR ORIGINAL COPY

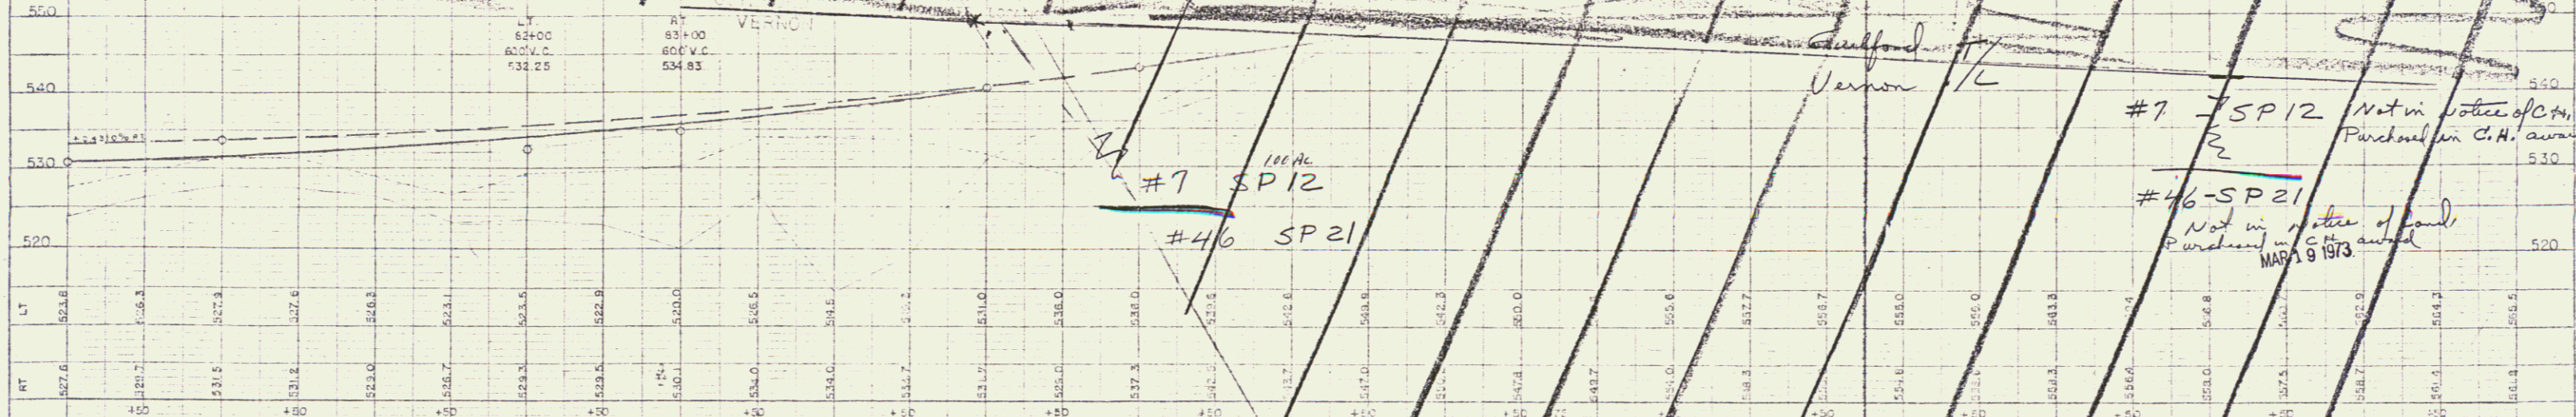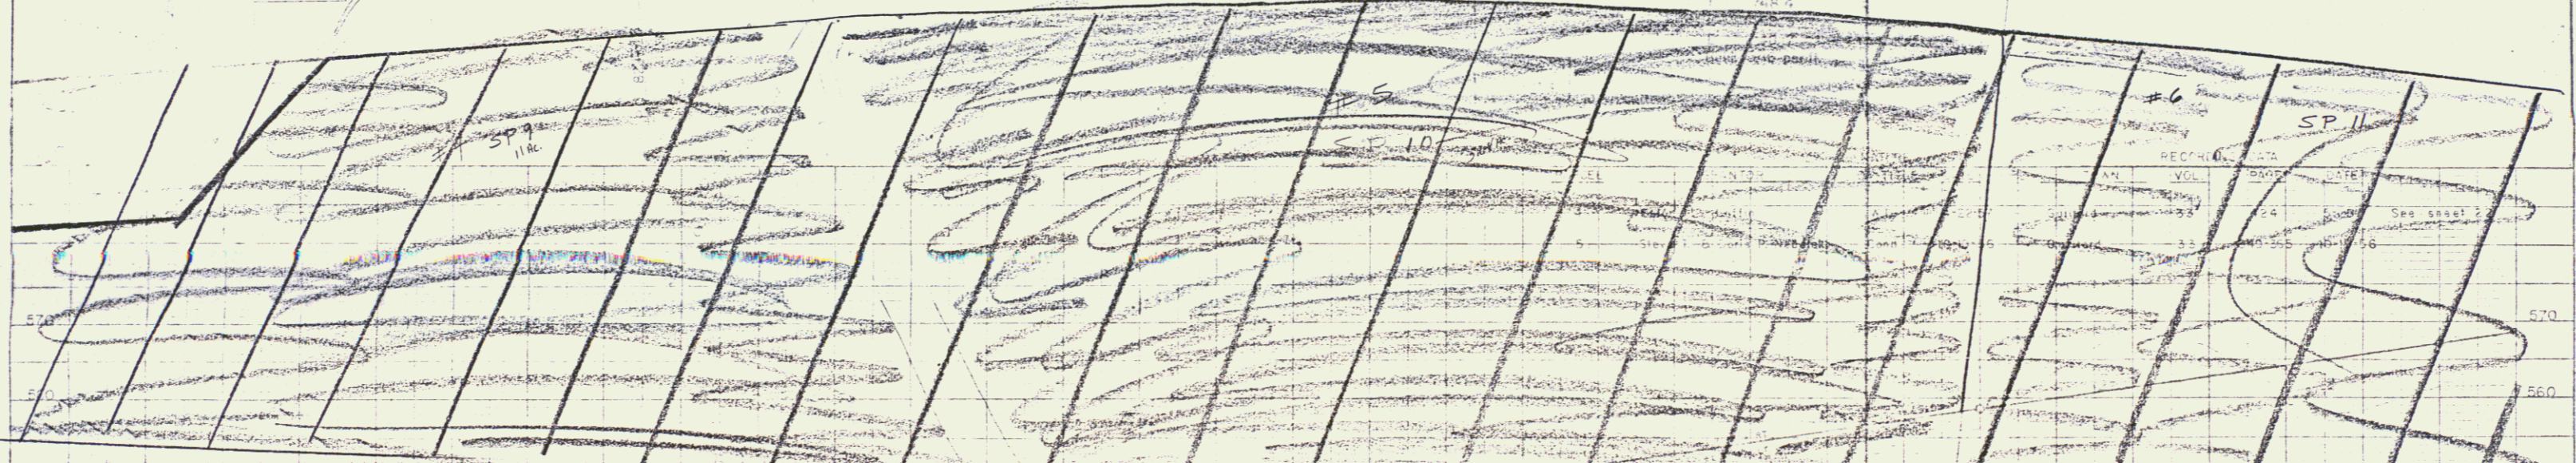

BM NO. 18 SIT 15' PINE 215' RT STA 79+05 EL 548.74
 BM NO. 19 SIT 18' MAPLE 155' RT STA 80+00 EL 535.95
 BM NO. 20 SIT 24' MAPLE 201' ST 84+82 EL 529.44
 BM NO. 21 SIT 18' PINE 13' LT STA 88+02 EL 548.40

#7 SP12
#46 SP21

#7 SP12 Not in notice of C.A.
Purchased in C.A. award
#46-SP21 Not in notice of C.A.
Purchased in C.A. award
MAY 9 1973

Ruilford
Vernon VT

RUILFORD-VERNON
Product 101 po 001114
1973