


100' 120' 130' 140' 600'



POOR ORIGINAL COPY

PLAN
 DATE
 DRAWN BY
 CHECKED BY
 TRACED BY
 A.S. 9' 11" 7/53

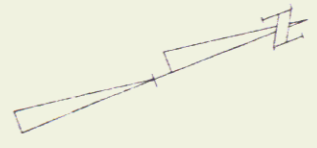