


PLAN
 DRAWN BY
 CHECKED BY
 DATE
 1/58

DATE
 DRAWN BY
 CHECKED BY

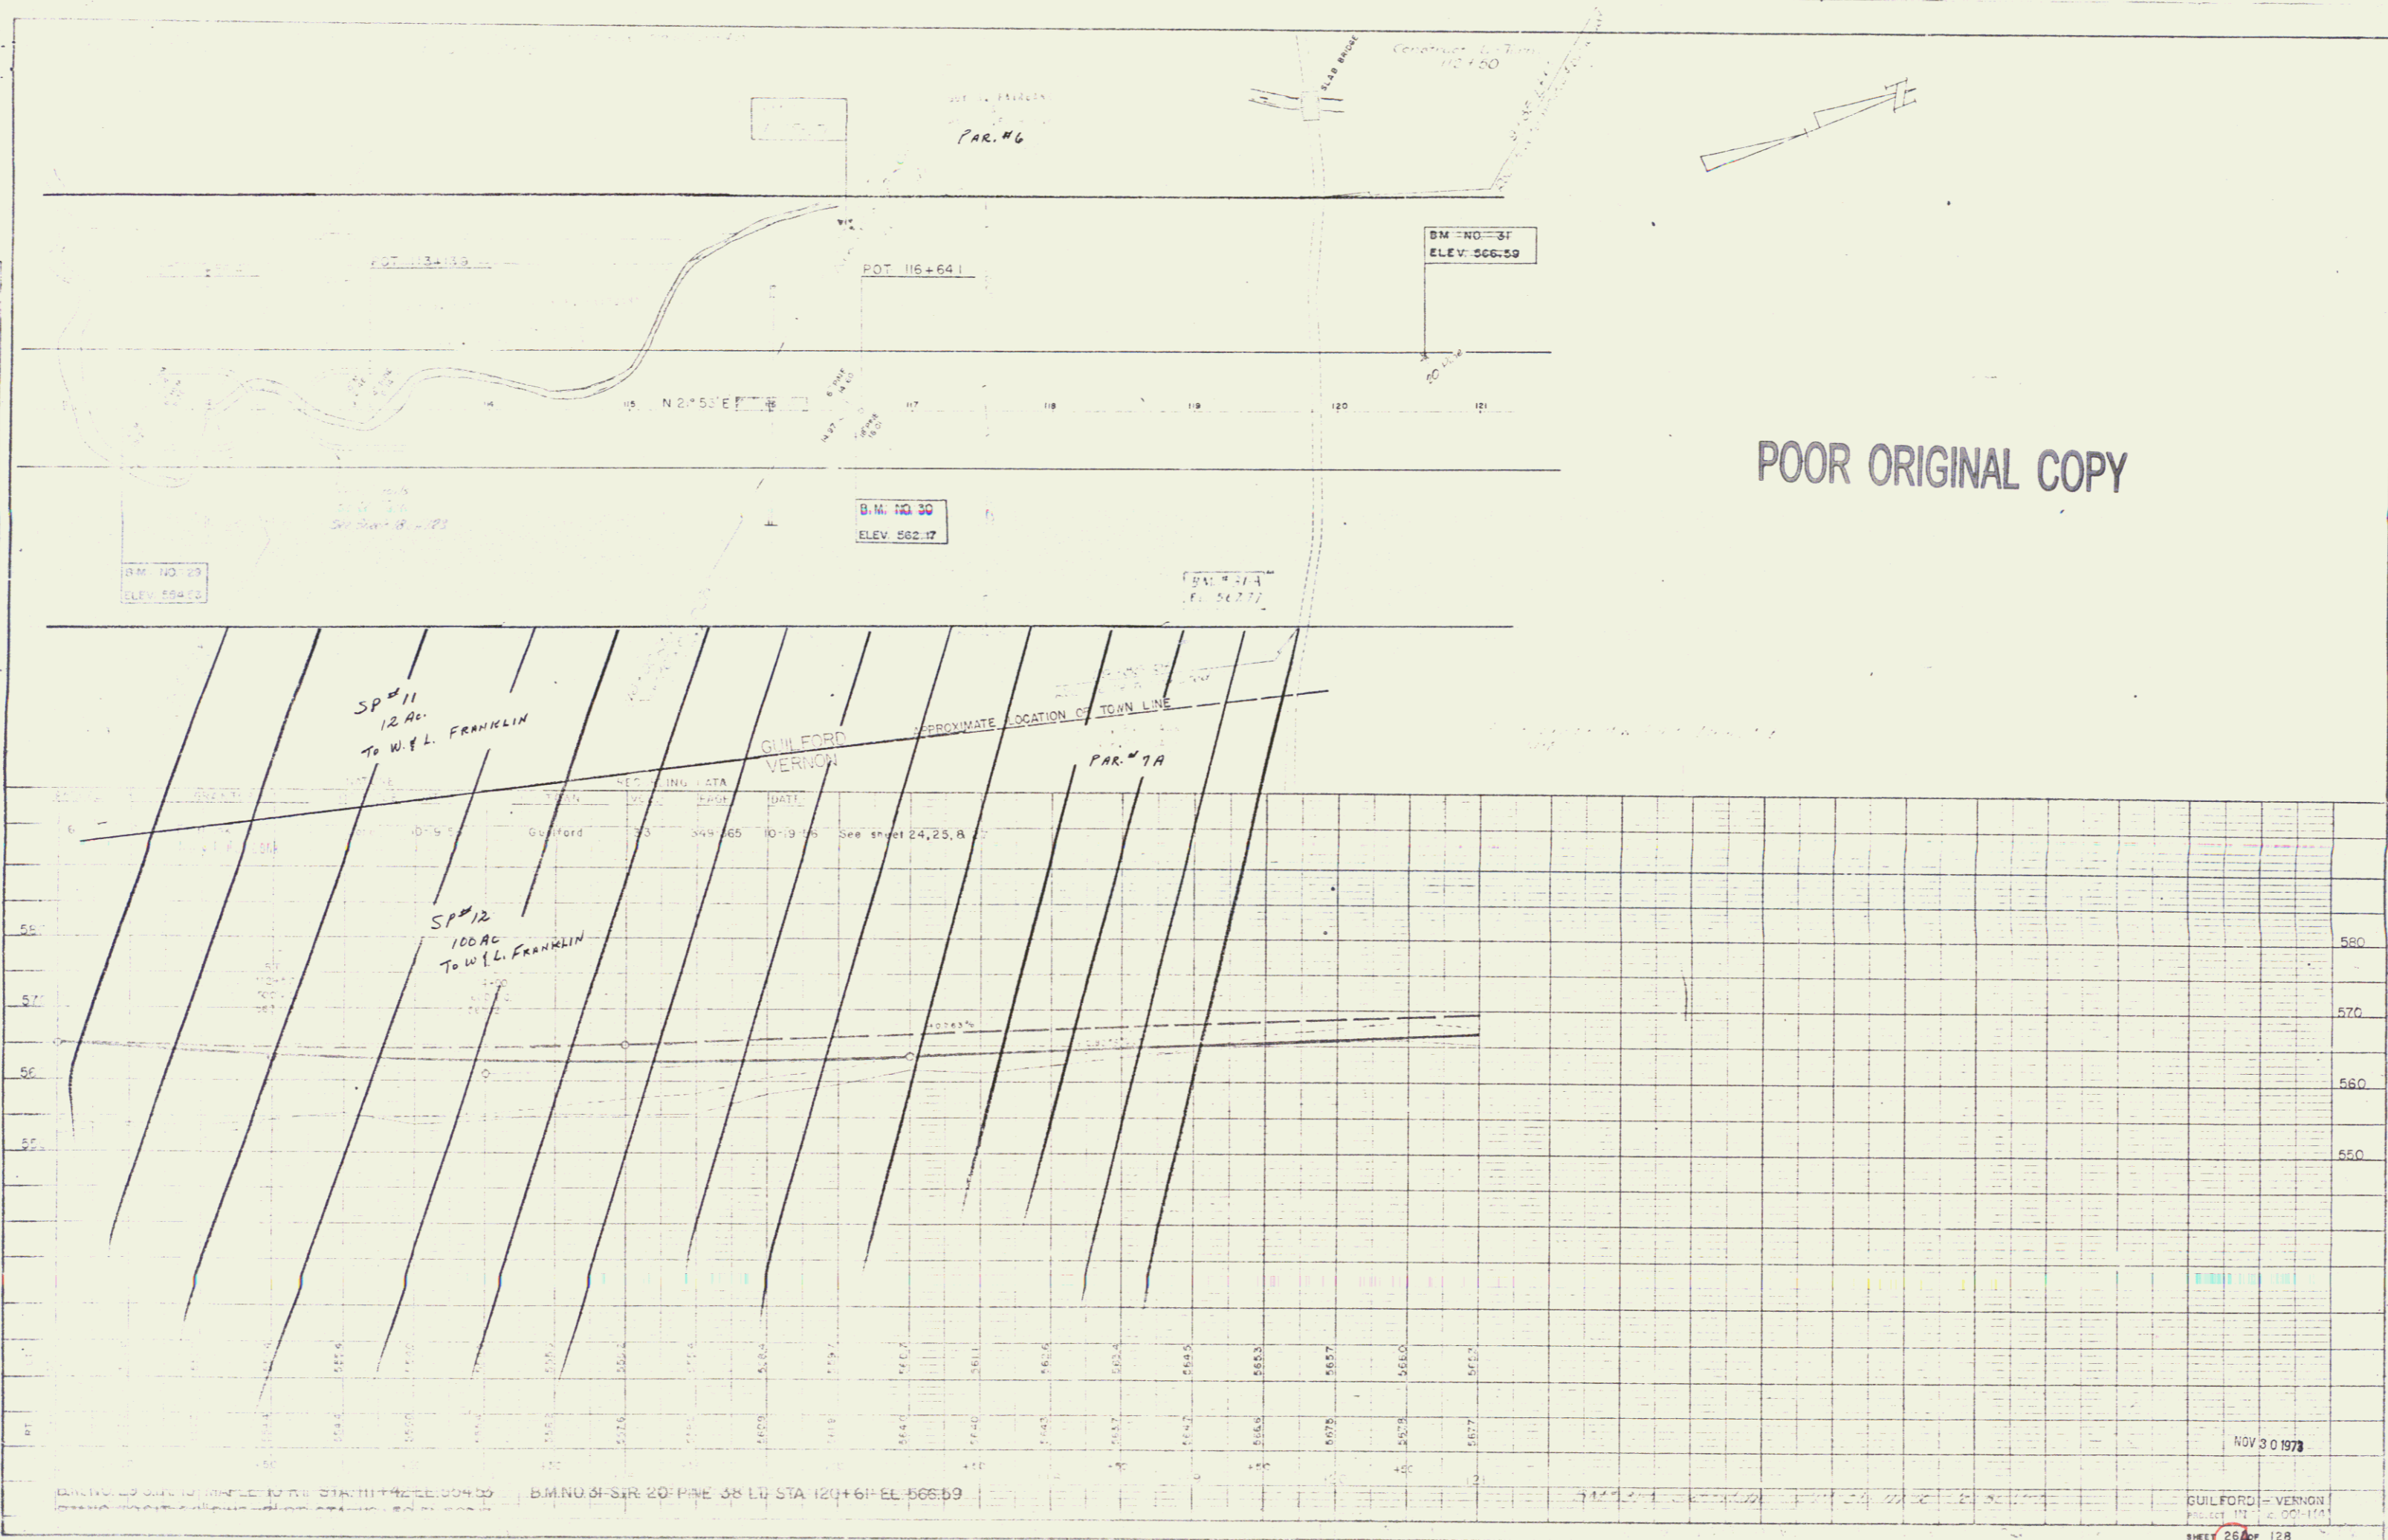

POOR ORIGINAL COPY

NOV 30 1978
 GUILFORD - VERNON
 SHEET 26 OF 128

22