


PARCEL	GRANTOR	NATURE OF TITLE	DATE	TOWN	VOL	PAGE	DATE
7A&B	Guy B. Fairbank & Leon P. Fairbank	Cond.	10-19-56	Vernon	26	207	10-19-56
8A	Ludwig V. & Anna Beinhauer	Cond.	10-19-56	Guilford	33	349-355	10-19-56
8B	Ludwig V. & Anna Beinhauer	Cond.	10-19-56	Vernon	26	207	10-19-56
46	Clarence E. & Leila G. Shaw	Cond.	10-19-56	Vernon	26	207	10-19-56

QCD to Guy R. Severance
 9/26/60 BK? Pg?
 40 A±

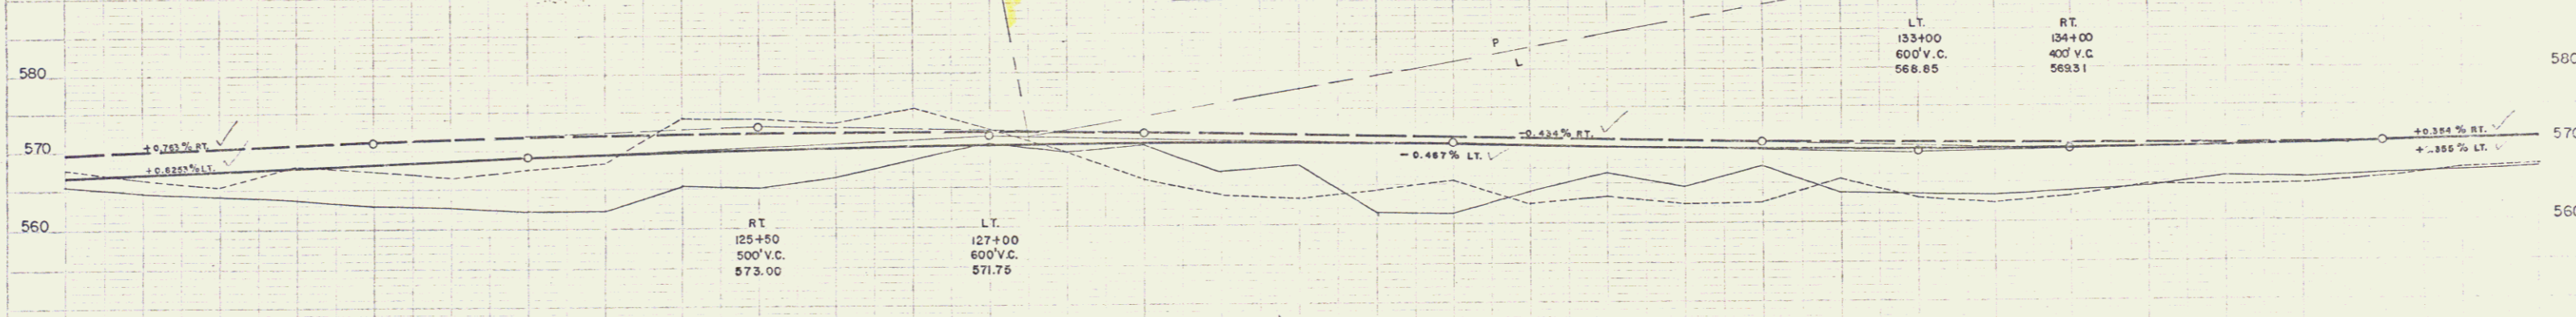

Note: State of VT to Wilfred W. Franklin Lawrence E. Franklin by QCD's
 dated 9/26/60
 100A± in Vernon sta 85+00 to 128+45
 12A± in Guilford 91+90 to 123+00

STATION	ELEVATION
121	563.3
122	564.6
123	564.2
124	563.7
125	562.9
126	562.8
127	562.3
128	562.2
129	565.6
130	565.0
131	566.4
132	568.7
133	570.6
134	569.3
135	570.4
136	566.8
137	567.7

PLAN
 POSSESSOR
 CARLEON
 A. J. & M. J.
 7/1956