


Drilling and Blasting of Solid Rock Subgrade
Items 143+00 to 151+00


LUDWIG V. & ANNA BEINHÄUER

Permanent & Control Markers in Median
P.T. Sta 137+59.2

PLAN
DESIGNED BY
CHECKED BY
DATE
SCALE
PROJECT NO.
SHEET NO.

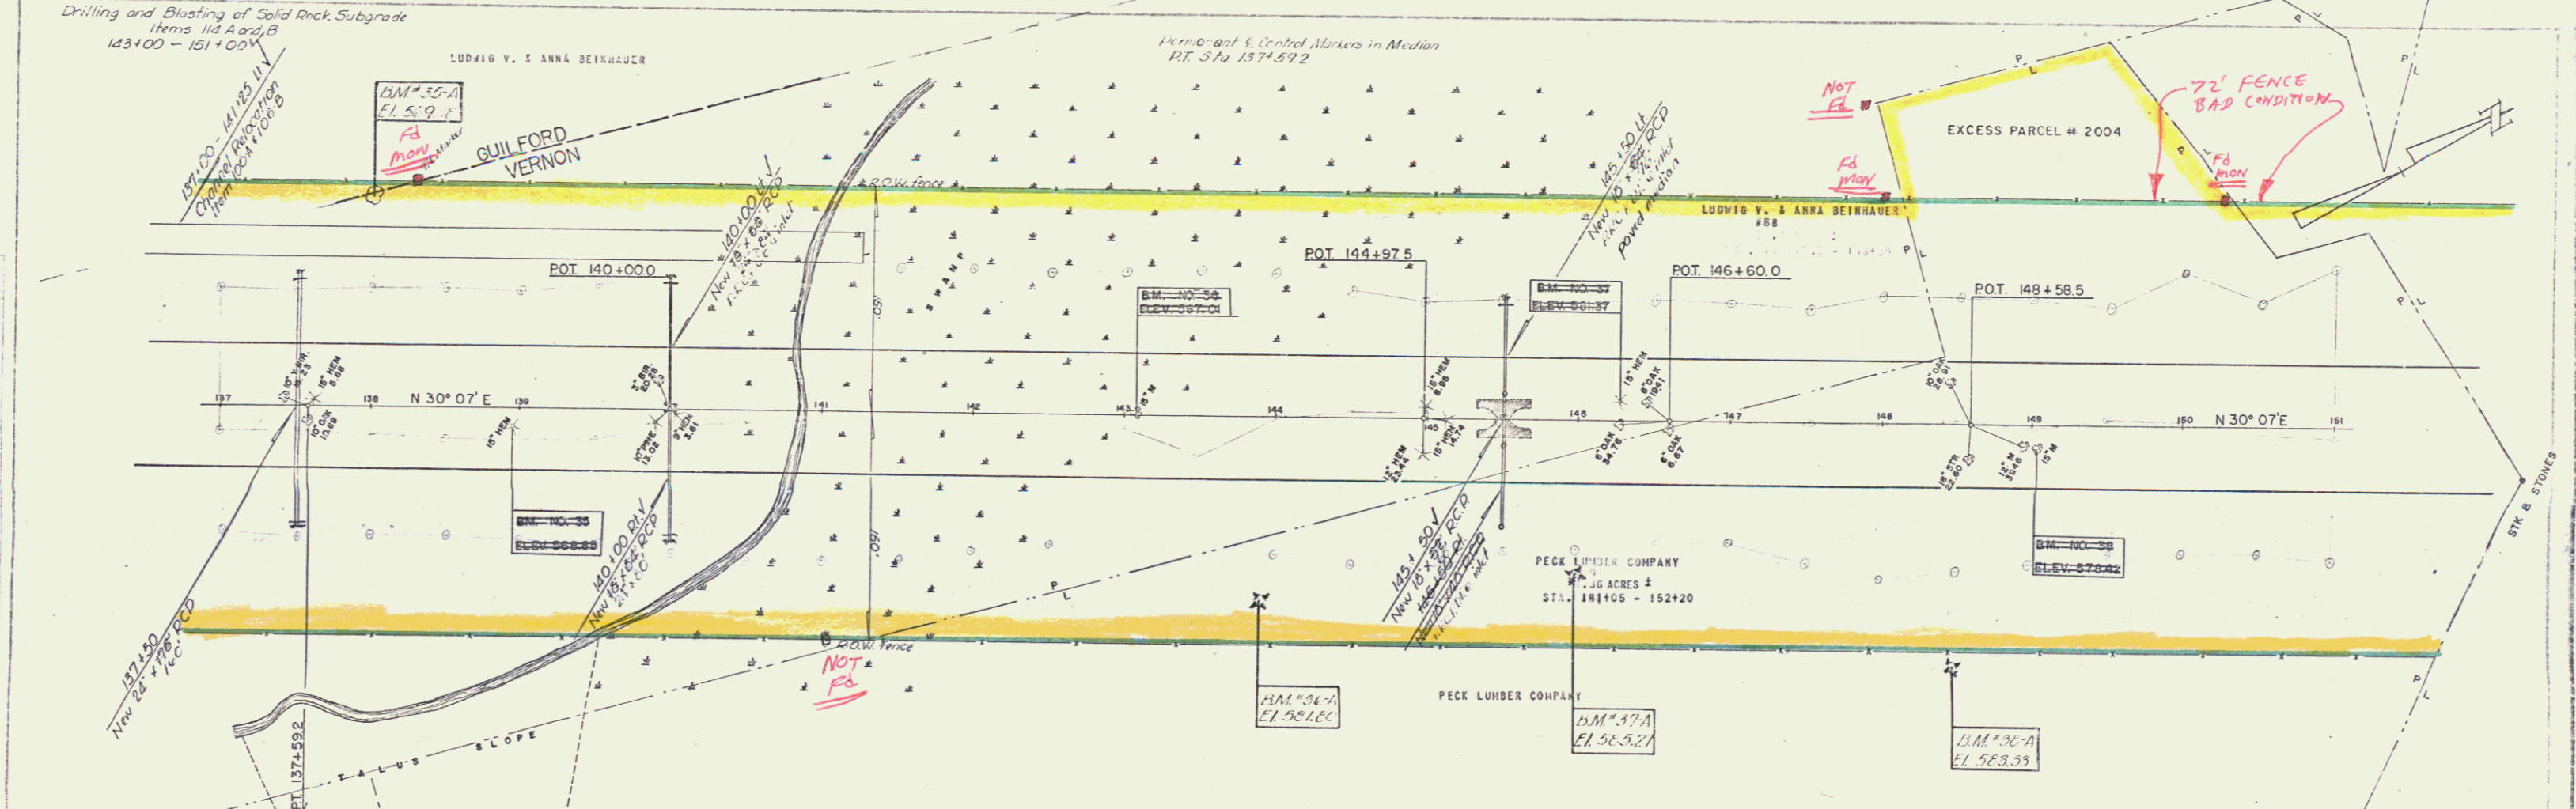

PARCEL	GRANTOR	NATURE OF TITLE	DATE	TOWN	VOL.	PAGE	DATE
9	Peck Lumber Company	Judgment	2-12-57	Vernon	24	379-380	4-30-57 See sheet 29

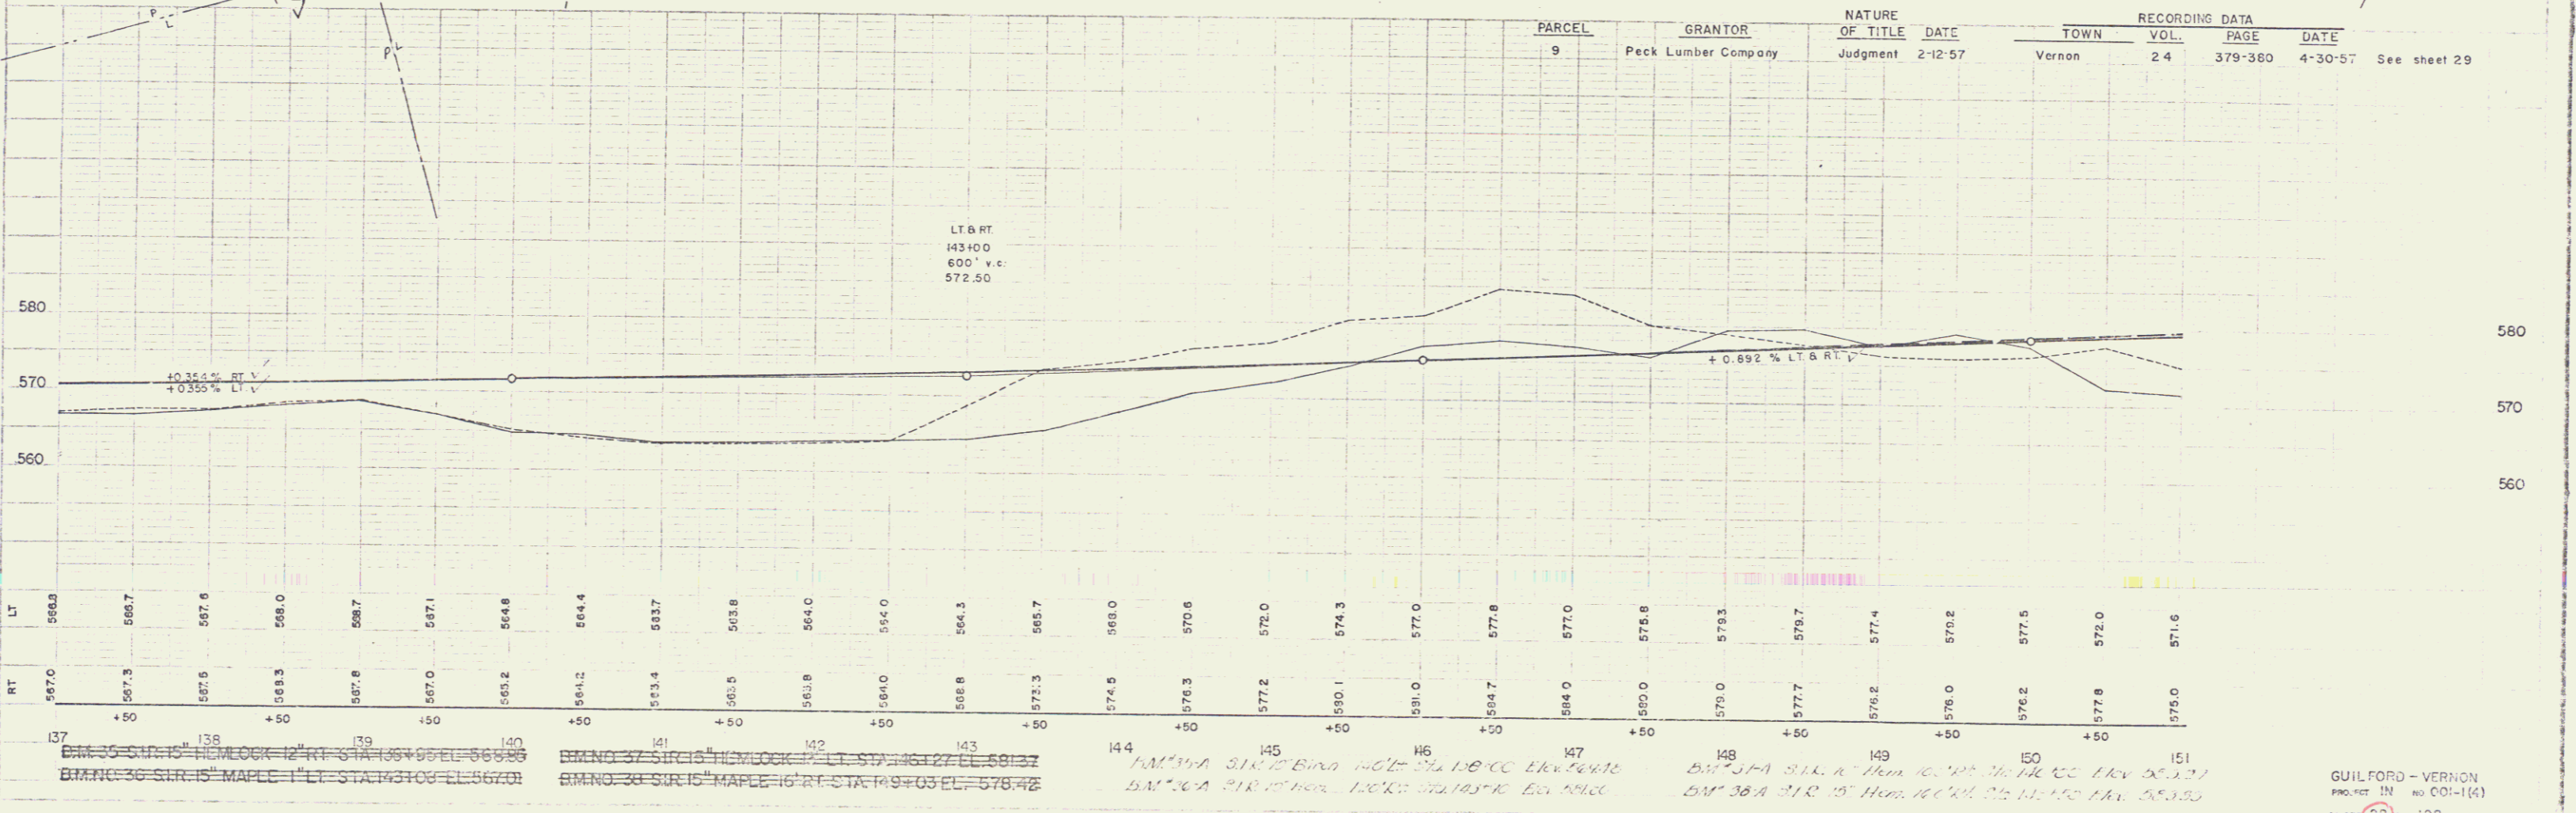

GUILFORD - VERNON
PROJECT IN NO 001-1(4)
SHEET 28 OF 128

25