



Drilling & Blasting of Solid Rock Subgrade
 Plans A & B
 173+60 - 176+20

Plank Guard Rail as Item 5.11-B
 167+5 8' LT
 172+35 8' LT
 176+20 8' LT

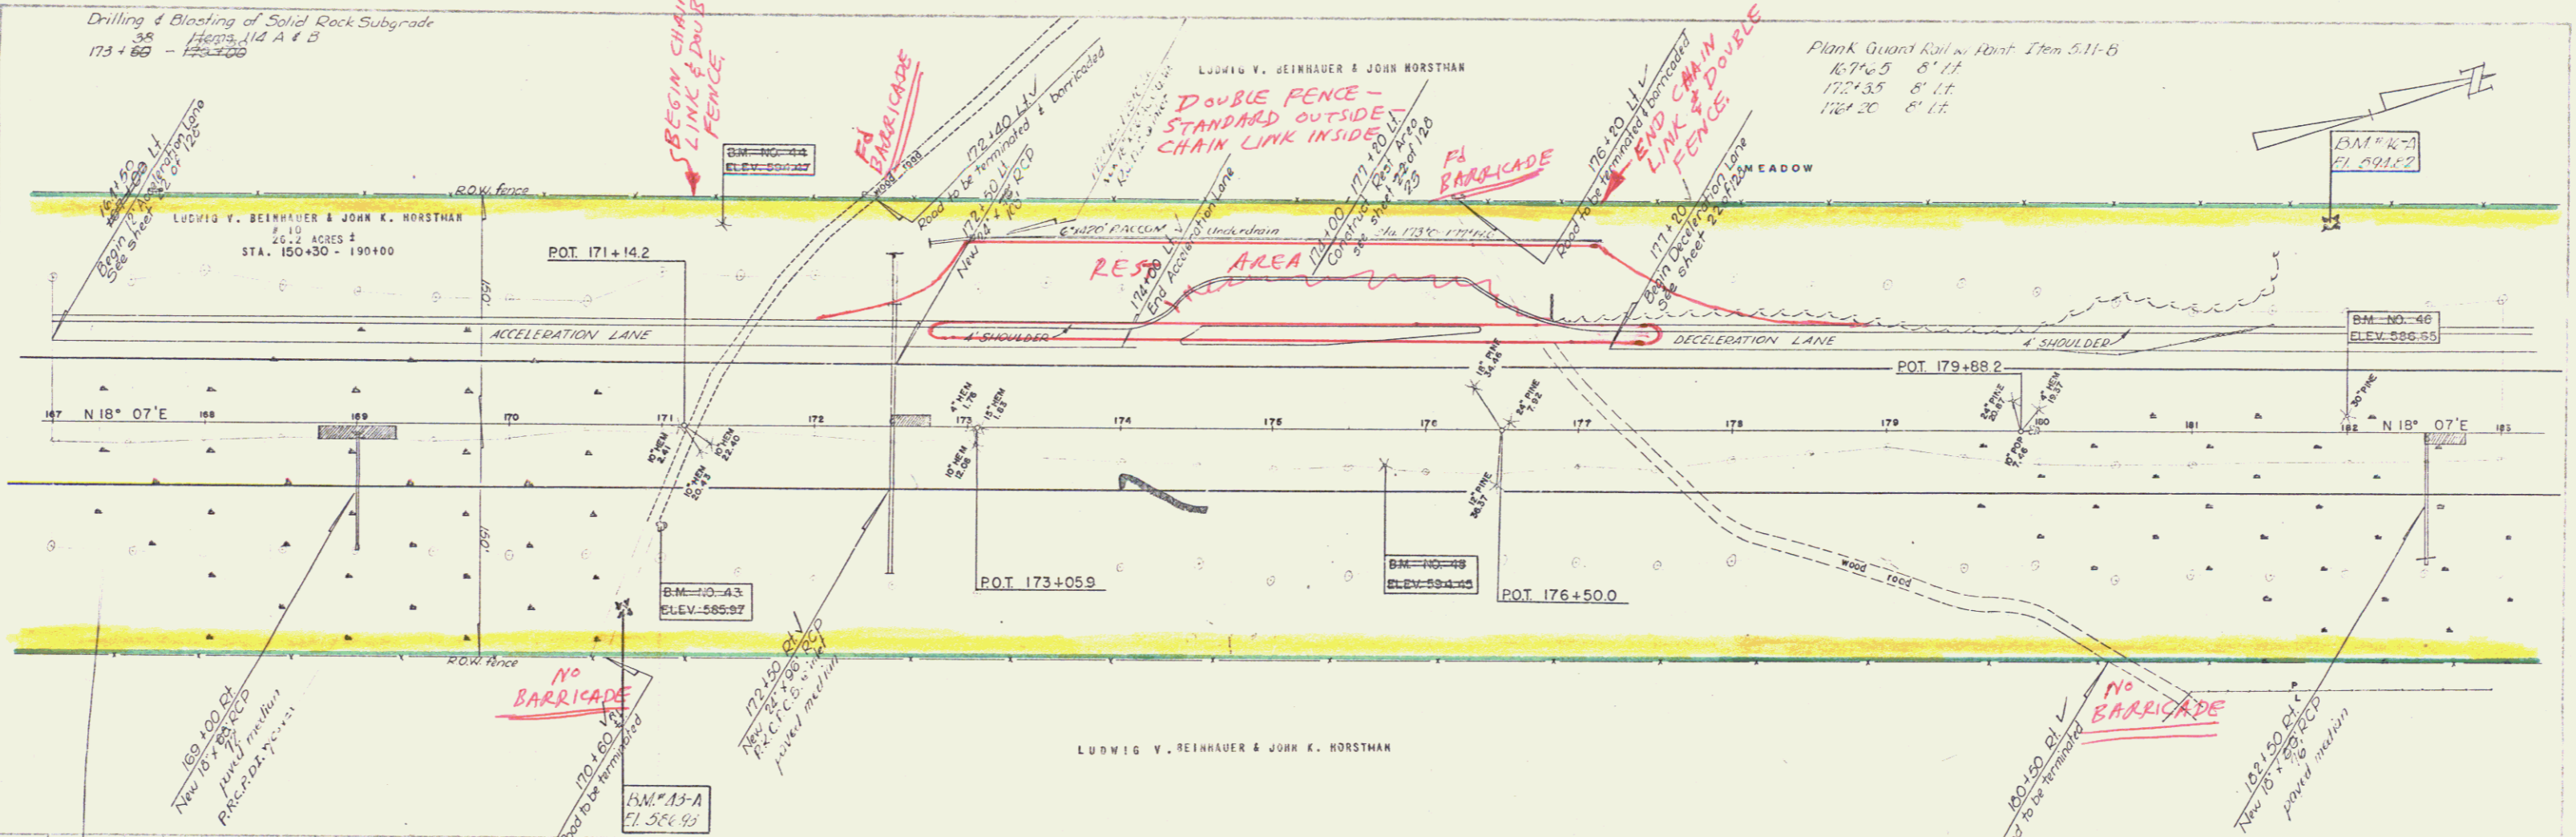

PARCEL	GRANTOR	NATURE OF TITLE	DATE	TOWN	VOL.	PAGE	DATE
10	Ludwig V. Reinhauser & John K. Horstman	Cond.	10-19-56	Vernon	26	207+	10-19-56 See sheet 29 & 31

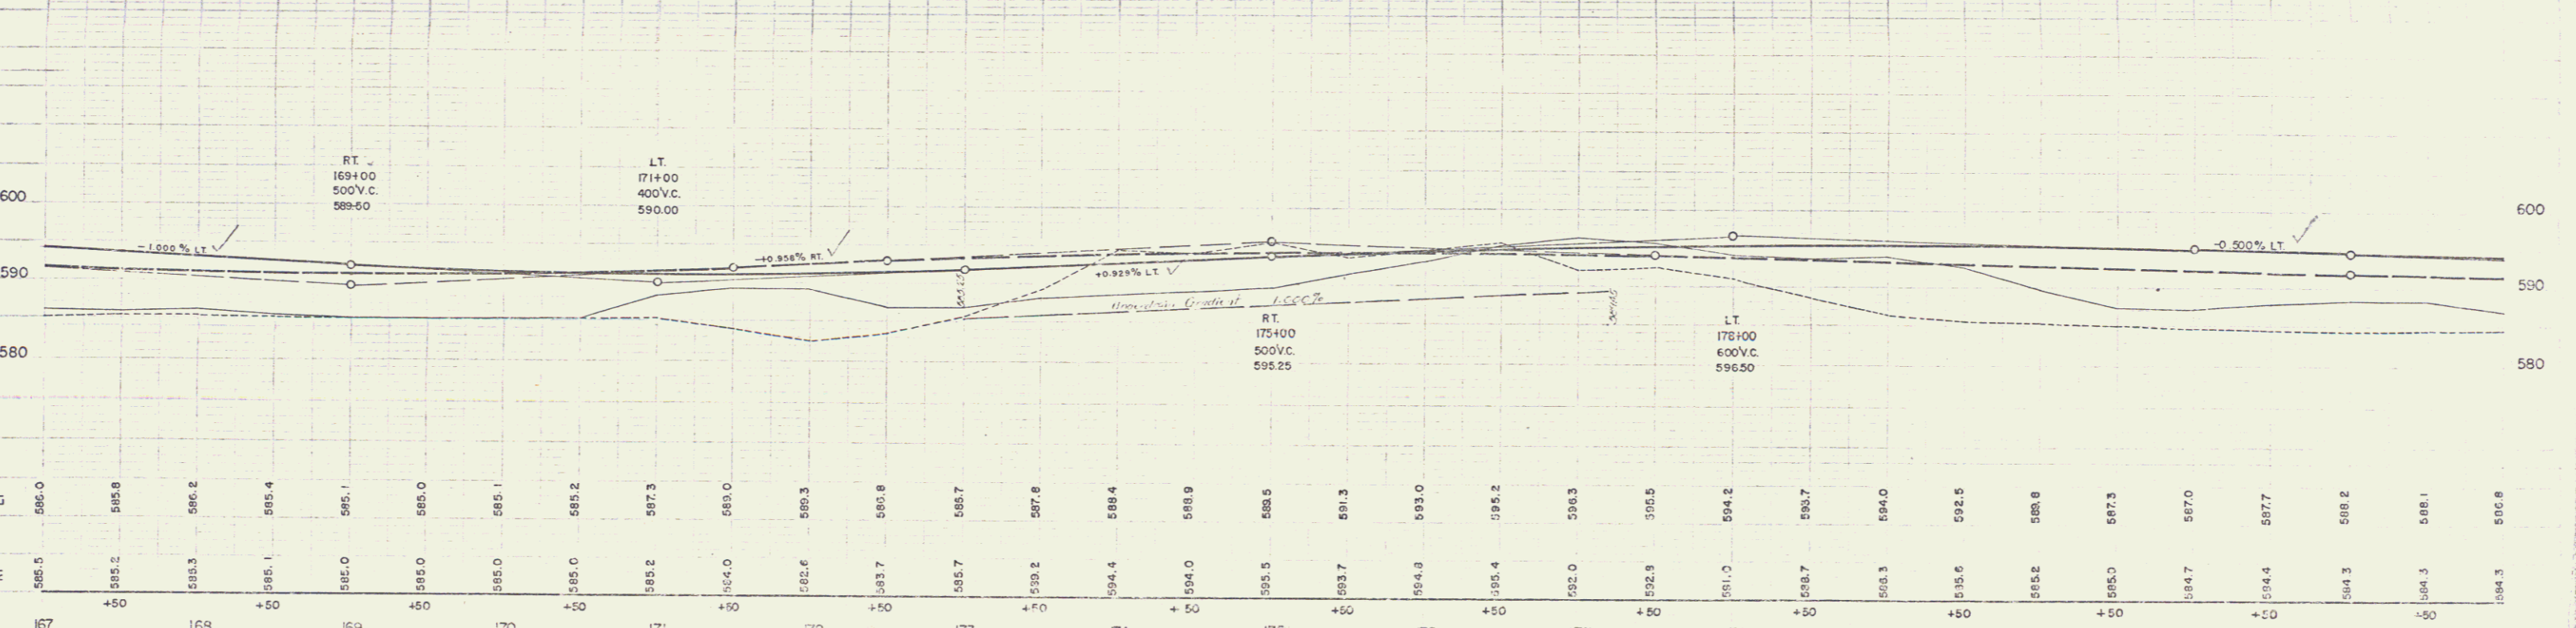

B.M. NO. 43 - SIR 12 CHERRY - C6 RT - STA. 171+00 - EL. 588.97
 B.M. NO. 44 - SIR 24 PINE - 12 LT - STA. 171+38 - EL. 594.41
 B.M. NO. 45 - SIR 10 CHERRY - 22 RT - STA. 175+73 - EL. 594.48
 B.M. NO. 46 - SIR 30 PINE - 12 LT - STA. 182+00 - EL. 586.65
 B.M. NO. 47 - SIR 10 CHERRY - 12 RT - STA. 175+00 - EL. 595.25
 B.M. NO. 48 - SIR 10 CHERRY - 12 RT - STA. 176+00 - EL. 596.50