
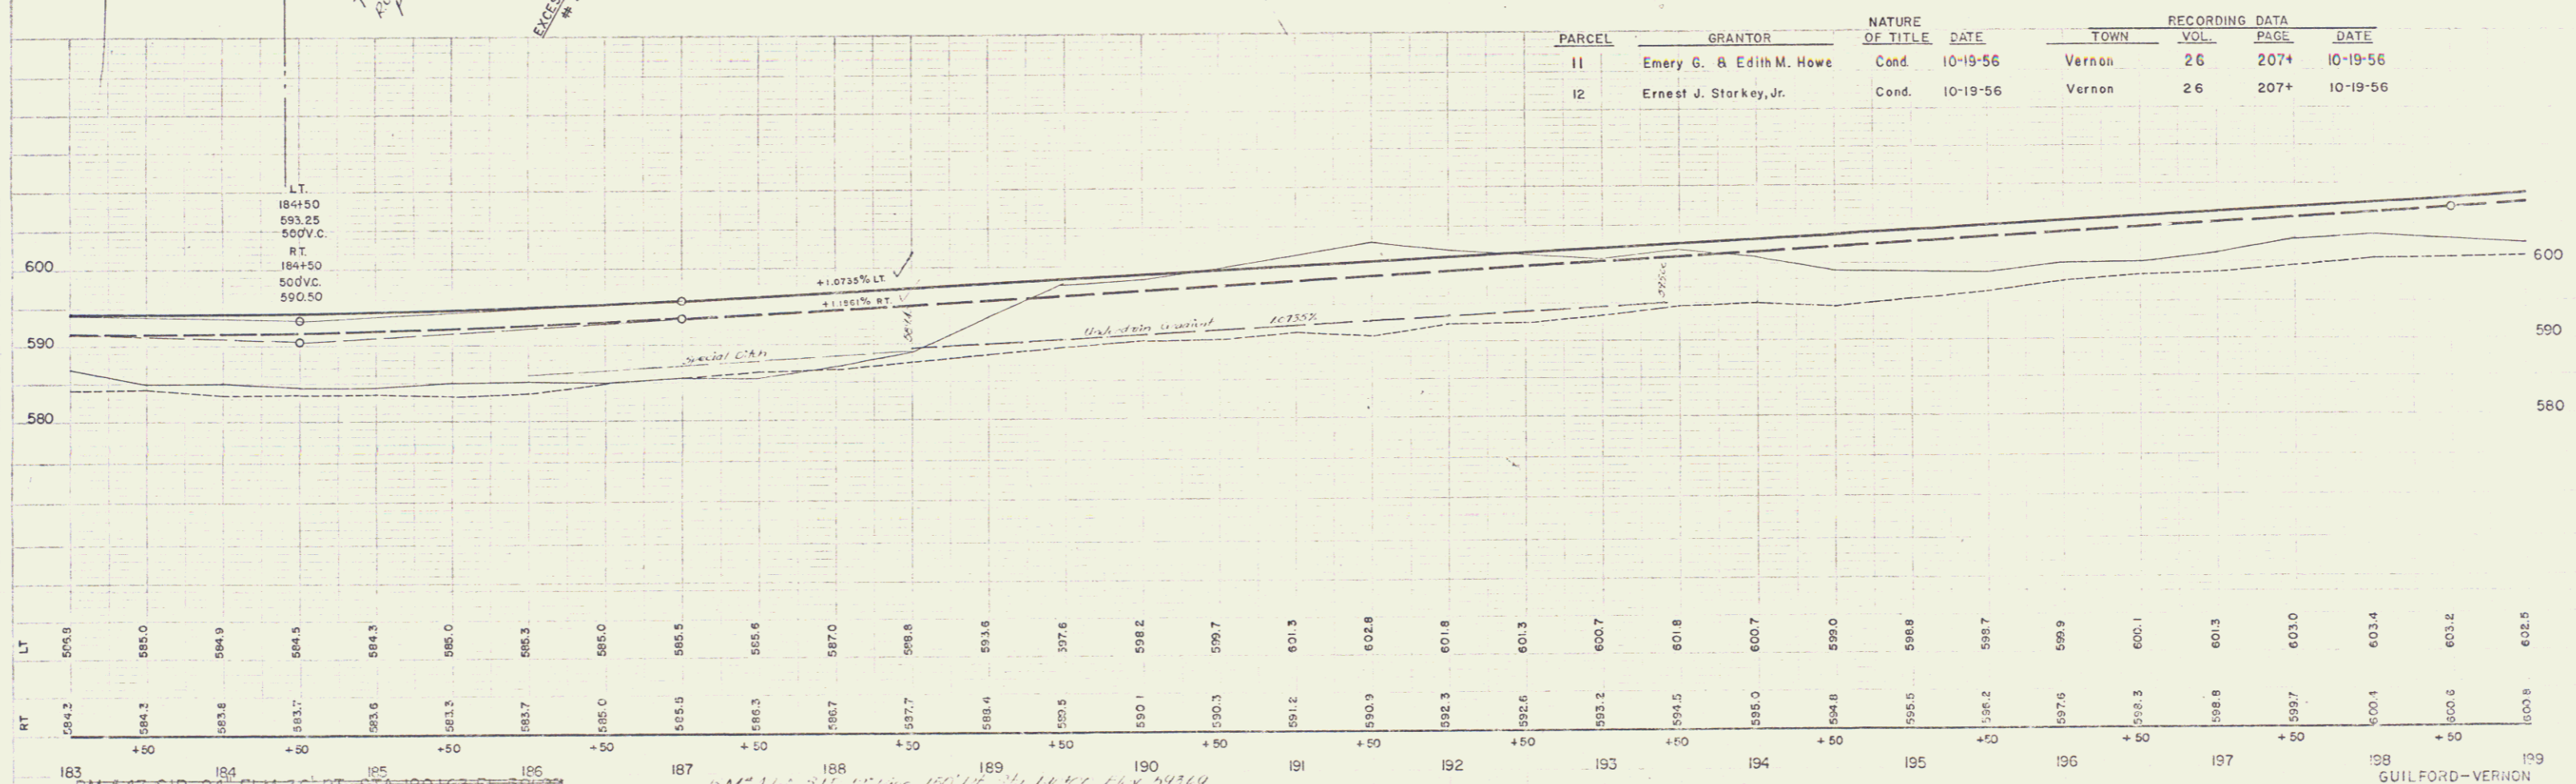


PLAN
 DATE 5/22
 DRAWN BY A.J.A. & J.C.
 CHECKED BY
 SCALE 1" = 40'
 PROJECT NO. 100-100-100
 SHEET NO. 51 OF 128

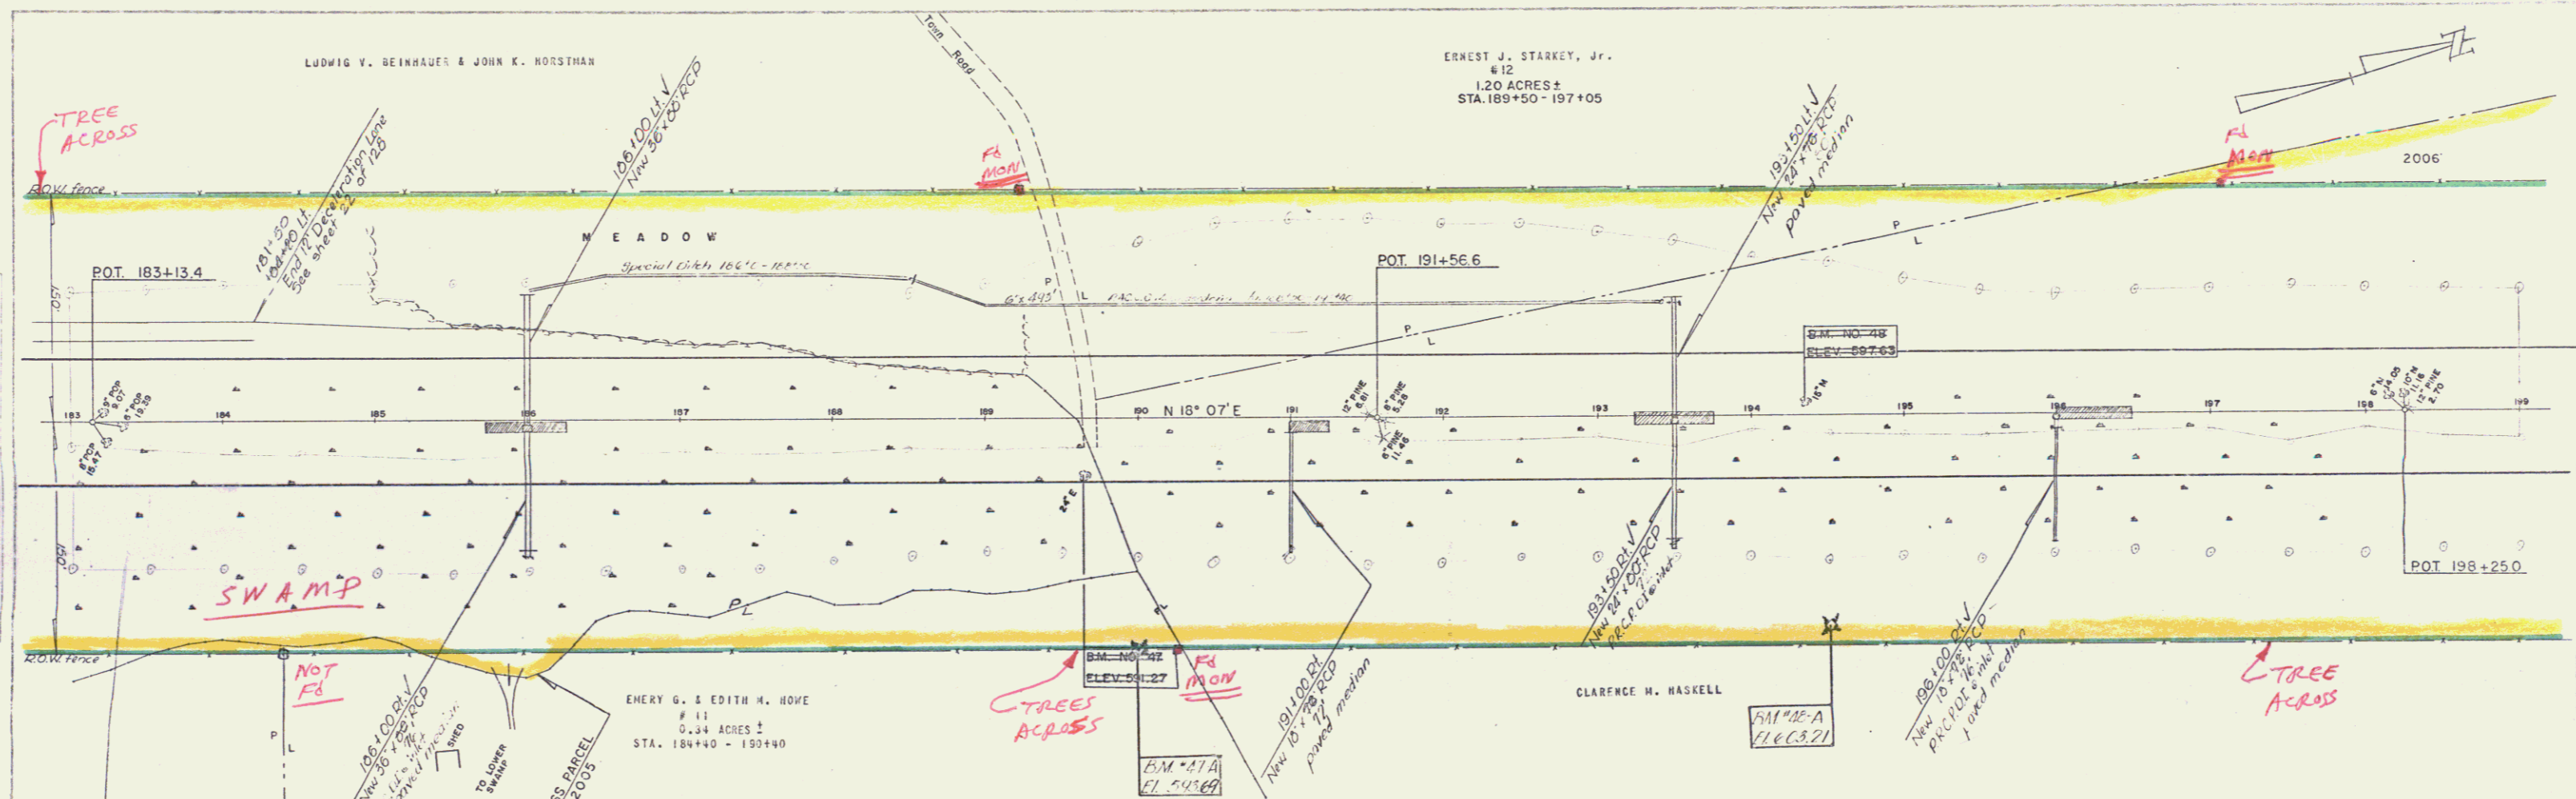

PARCEL	GRANTOR	NATURE OF TITLE	DATE	TOWN	RECORDING VOL.	DATA PAGE	DATE
11	Emery G. & Edith M. Howe	Cond.	10-19-56	Vernon	26	207+	10-19-56
12	Ernest J. Starkey, Jr.	Cond.	10-19-56	Vernon	26	207+	10-19-56

183 B.M. #47 S.I.R. 24' E.L.M. 36' RT STA 189+63 E.L. 597.27
 184
 185 B.M. #48 S.I.L. 15' MAPLE O.L.T. STA 194+34 E.L. 597.63
 186
 187
 199