



PLAN
 DATE 2/18/88
 DRAWN BY A.J.A. & J.R.
 CHECKED BY
 SCALE 1" = 40'

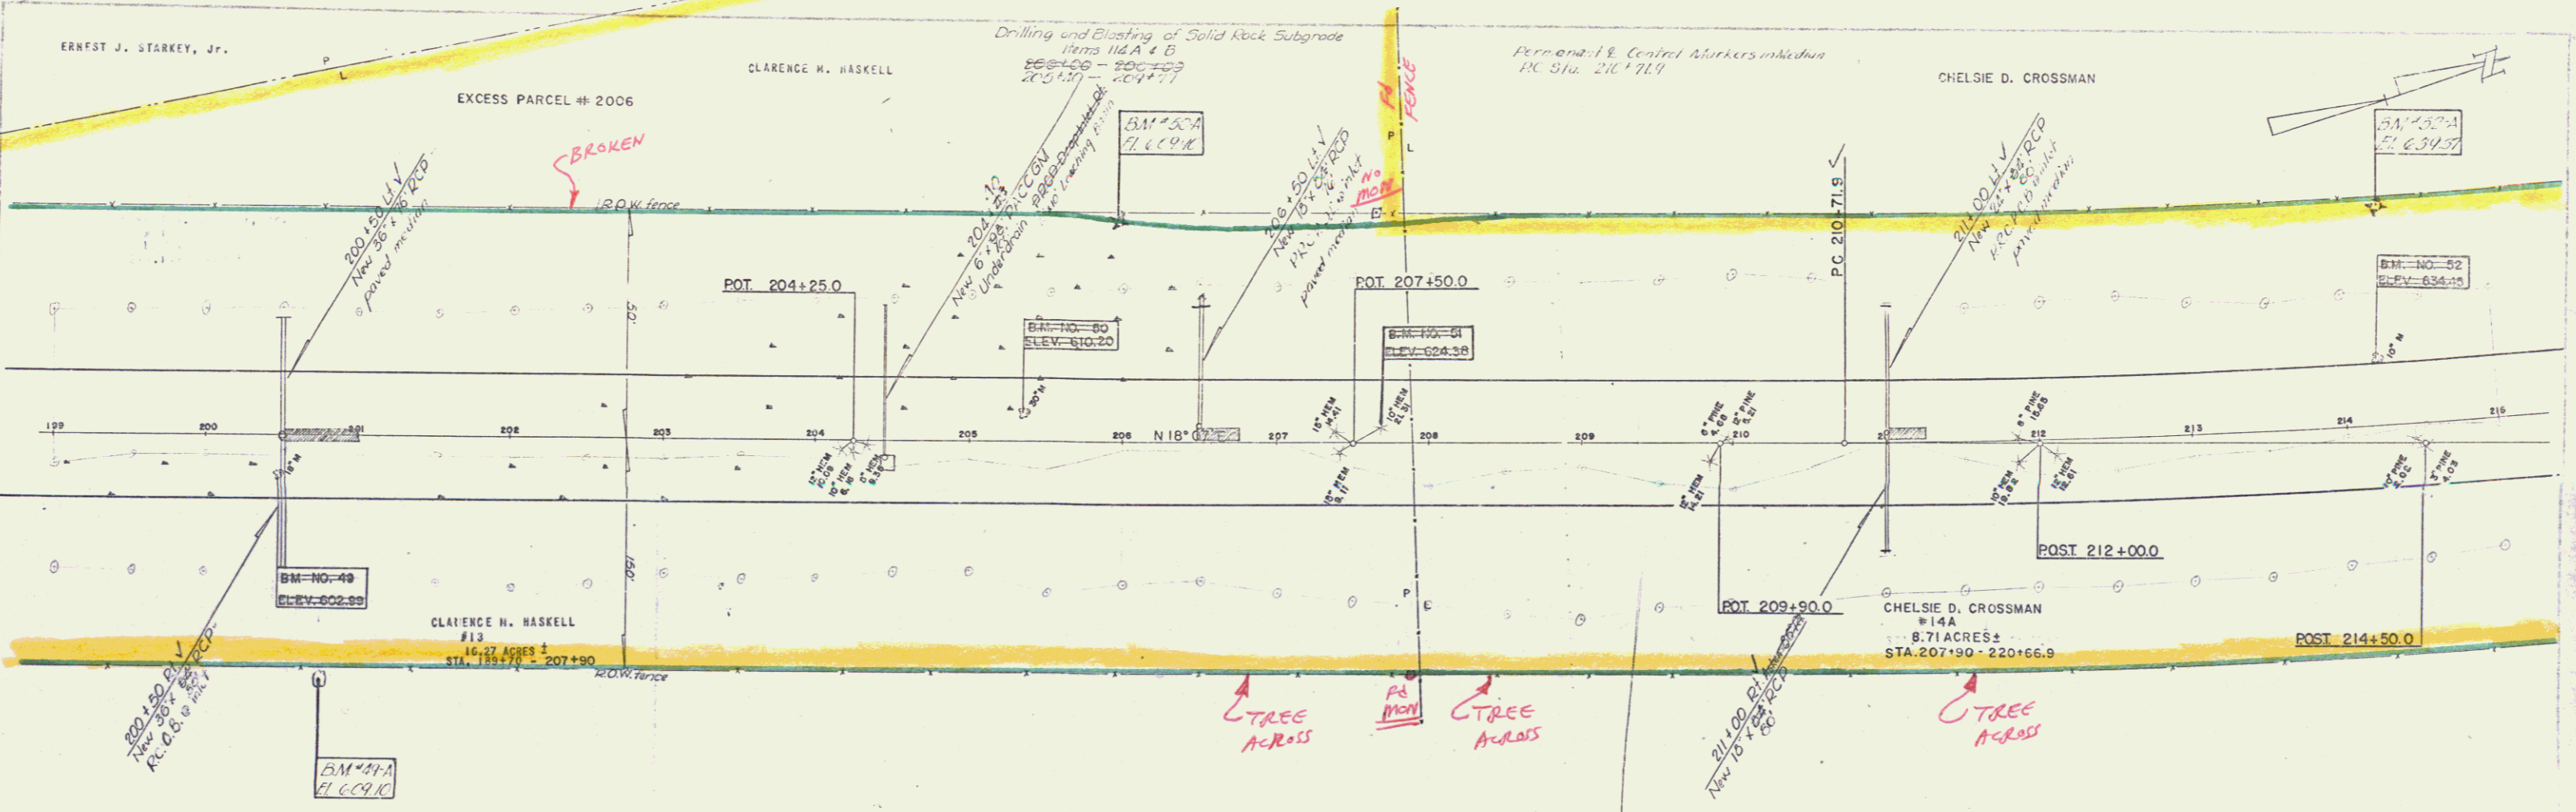

PARCEL	GRANTOR	NATURE OF TITLE	DATE	RECORDING DATE		
				TOWN	VOL.	PAGE
13	Clarence M. Haskell	W.D.	4-22-57	Vernon	27	4
14A	Chelsie D. Crossman	W.D.	4-22-57	Vernon	27	5

See sheet 33

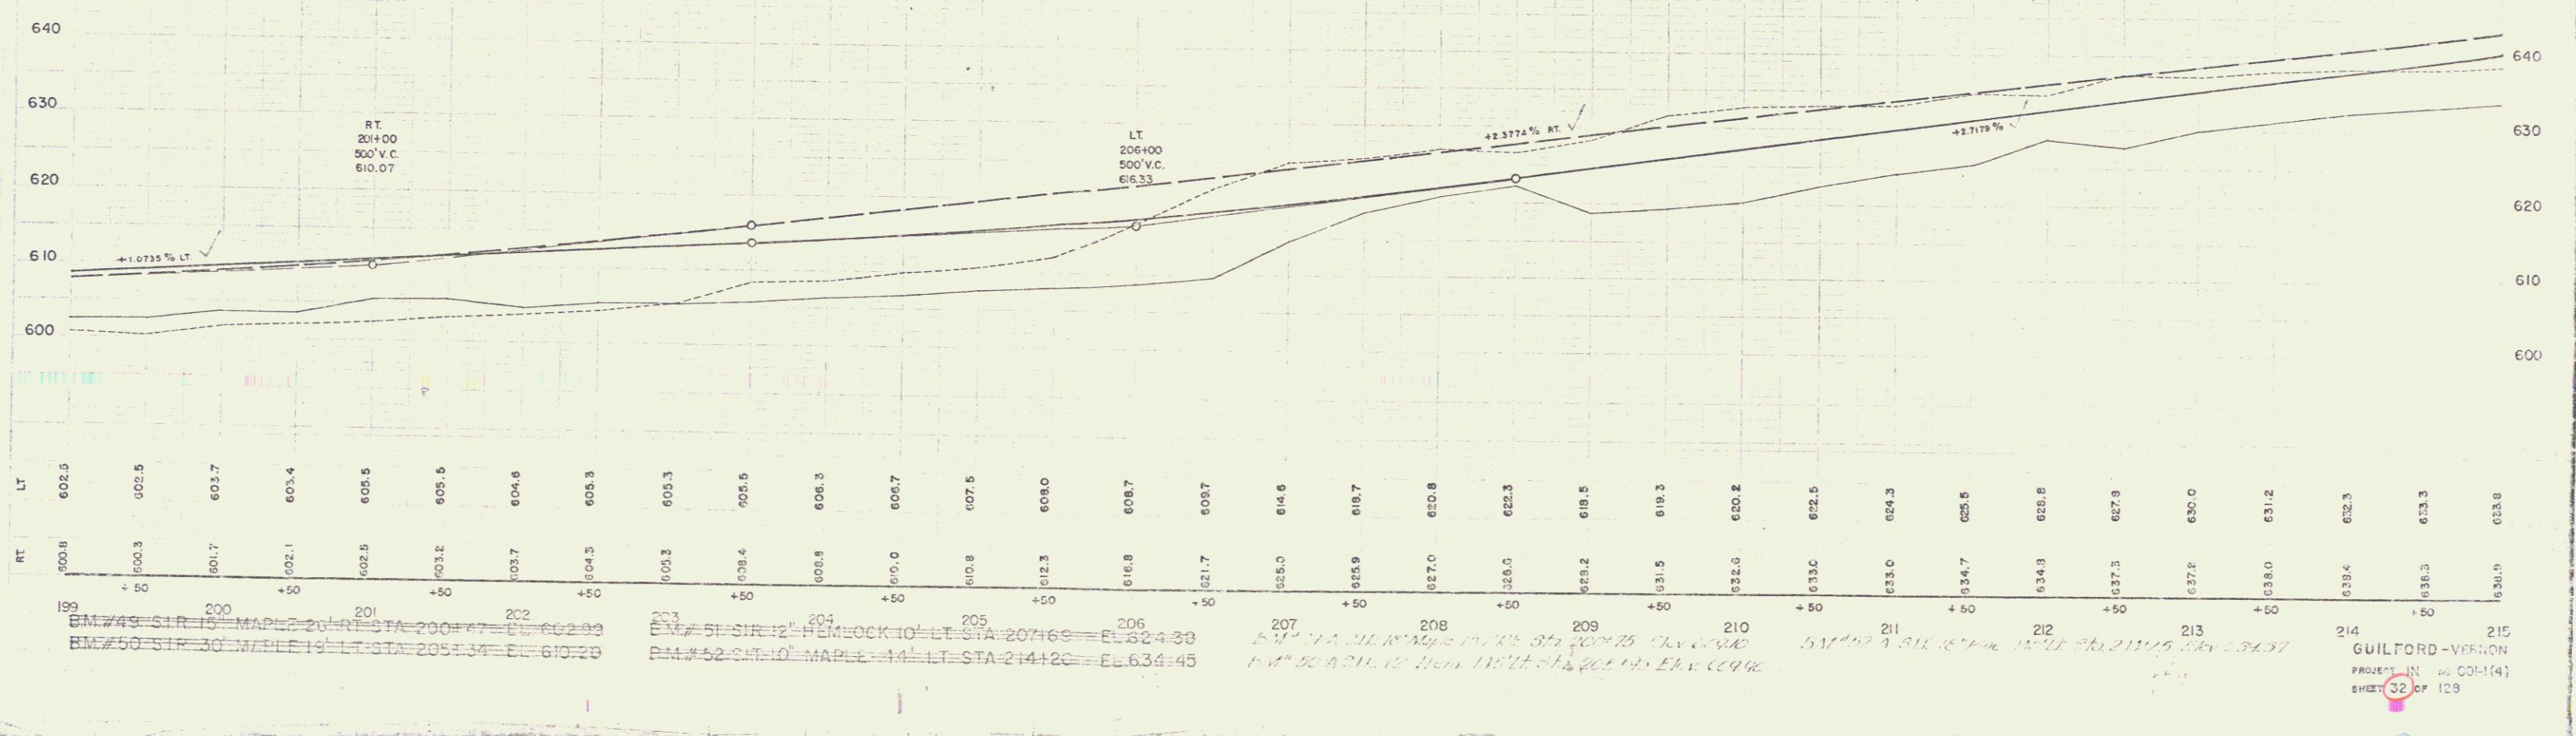

199 BM #49 STR 16 MAPLE 20' N STA 200+77 EL 624.39
 200 BM #50 STR 30 MAPLE 19' LT STA 205+34 EL 610.20
 201
 202
 203
 204 BM #51 STR 2 HEMLOCK 10' LT STA 207+66 EL 624.39
 205
 206 BM #52 STR 10 MAPLE 14' LT STA 214+20 EL 634.45
 207
 208
 209
 210
 211
 212
 213
 214
 215