

Brattleboro 1-30-10  
Station 422 to 629 635700



INDEX OF SHEETS

1	GENERAL
2	PLANNING
3	ALIGNED
4	PROFILES
5	CONSTRUCTION
6	CONVENTIONAL SIGNS
7	RIGHT-OF-WAY
8	CONSTRUCTION PLANS
9	CONSTRUCTION PLANS
STATE OF VERMONT  
DEPARTMENT OF HIGHWAYS  
Proposed Improvement  
INTERSTATE PROJECT  
**TOWN OF BRATTLEBORO**  
COUNTY OF WINDHAM  
**INTERSTATE ROUTE 91**  
GUILFORD-BELLOWS FALLS ROAD

BEGINS AT A POINT 7.821 MILES NORTH OF THE MASS-VT STATE LINE AND EXTENDS NORTHERLY 3.918 MILES  
LENGTH OF ROADWAY (URBAN) 8,729.3 FEET = 1.658 MILES  
LENGTH OF ROADWAY (RURAL) 13,114.9 FEET = 2.464 MILES  
LENGTH OF BRIDGES 1,844.4 FEET = 0.349 MILE  
LENGTH OF PROJECT 20,688.6 FEET = 3.918 MILES

Pin # 99R0390  
629/100

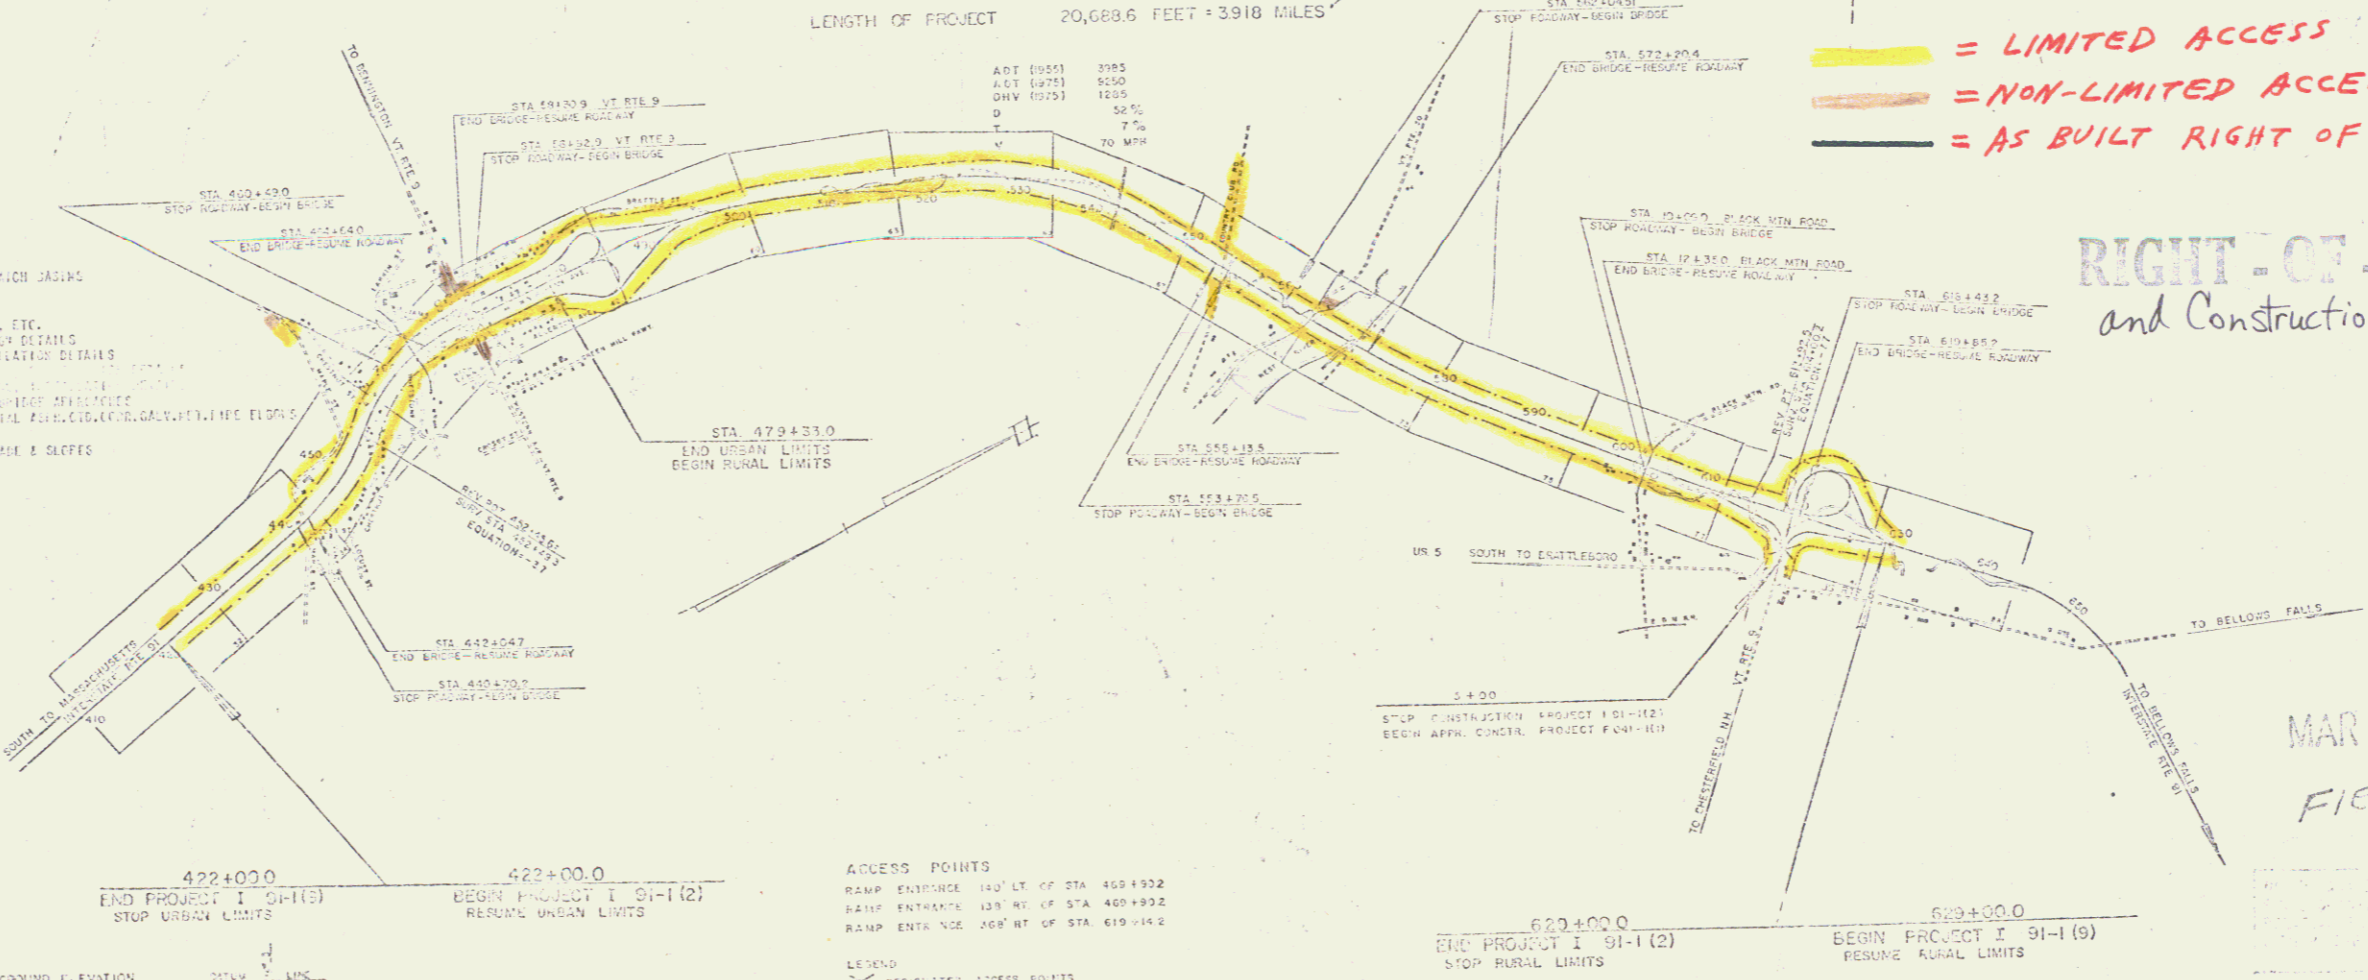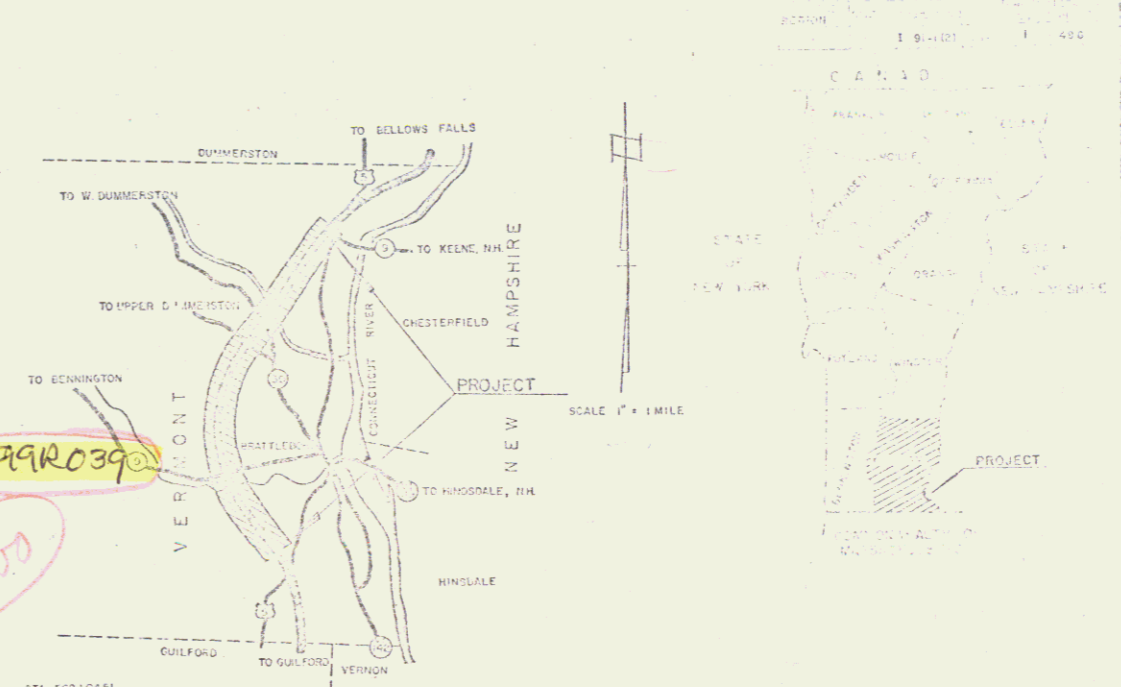

**= LIMITED ACCESS PURCHASE.**  
**= NON-LIMITED ACCESS PURCHASE.**  
**= AS BUILT RIGHT OF WAY FENCE.**

RIGHT-OF-WAY  
and Construction Plans

CONVENTIONAL SIGNS

1	ROAD NAME
2	ROAD NAME
3	ROAD NAME
GROUND ELEVATION

1	ROAD NAME
2	ROAD NAME
3	ROAD NAME
ADDRESS POINTS  
RAMP ENTRANCE 100 FT. OF STA 455+932  
RAMP ENTRANCE 125 FT. OF STA 448+932  
RAMP ENTRANCE 200 FT. OF STA 459+142

POOR ORIGINAL COPY

THIS DRAWING IS SUBJECT TO THE GENERAL CONDITIONS OF CONTRACT FOR THE CONSTRUCTION OF HIGHWAYS  
AND BRIDGES IN VERMONT AND TO THE SPECIFICATIONS FOR HIGHWAY AND BRIDGE  
CONSTRUCTION IN VERMONT AS SUBMITTED TO THE BOARD OF  
PUBLIC WORKS AND HIGHWAYS OF THE STATE OF VERMONT  
PROJECTS ARE IDENTIFIED WITH THE PLANS

MAR 10 1974  
FIELD SET

June 12, 1958  
STEARN'S R. JENKINS