


THREE CABLE GUARD RAIL WITH STEEL POSTS
 LT. Median 440+83 - 440+83
 RT. 433+97 - 440+75
 435+89 - 440+75
 R+Median 440+00 - 440+40

DRILLING AND BLASTING
 OF SOLID ROCK SUB-GRADE ITEM 114(MD)
 428+00 - 433+56 75'

PROPERTY LINE FENCE, ITEM 533-B
 LT. 428+00 - 439+63
 RT. 420+00 - 440+40
 440+89

CONSTRUCT DRIVES (MAPLE ST)
 RIGHT
 1+41

DEMOLITION & REMOVAL OF BUILDINGS- ITEM 506
 LT. Spring No. 435+80
 RT. Spring No. 437+80
 Spring No. 439+80

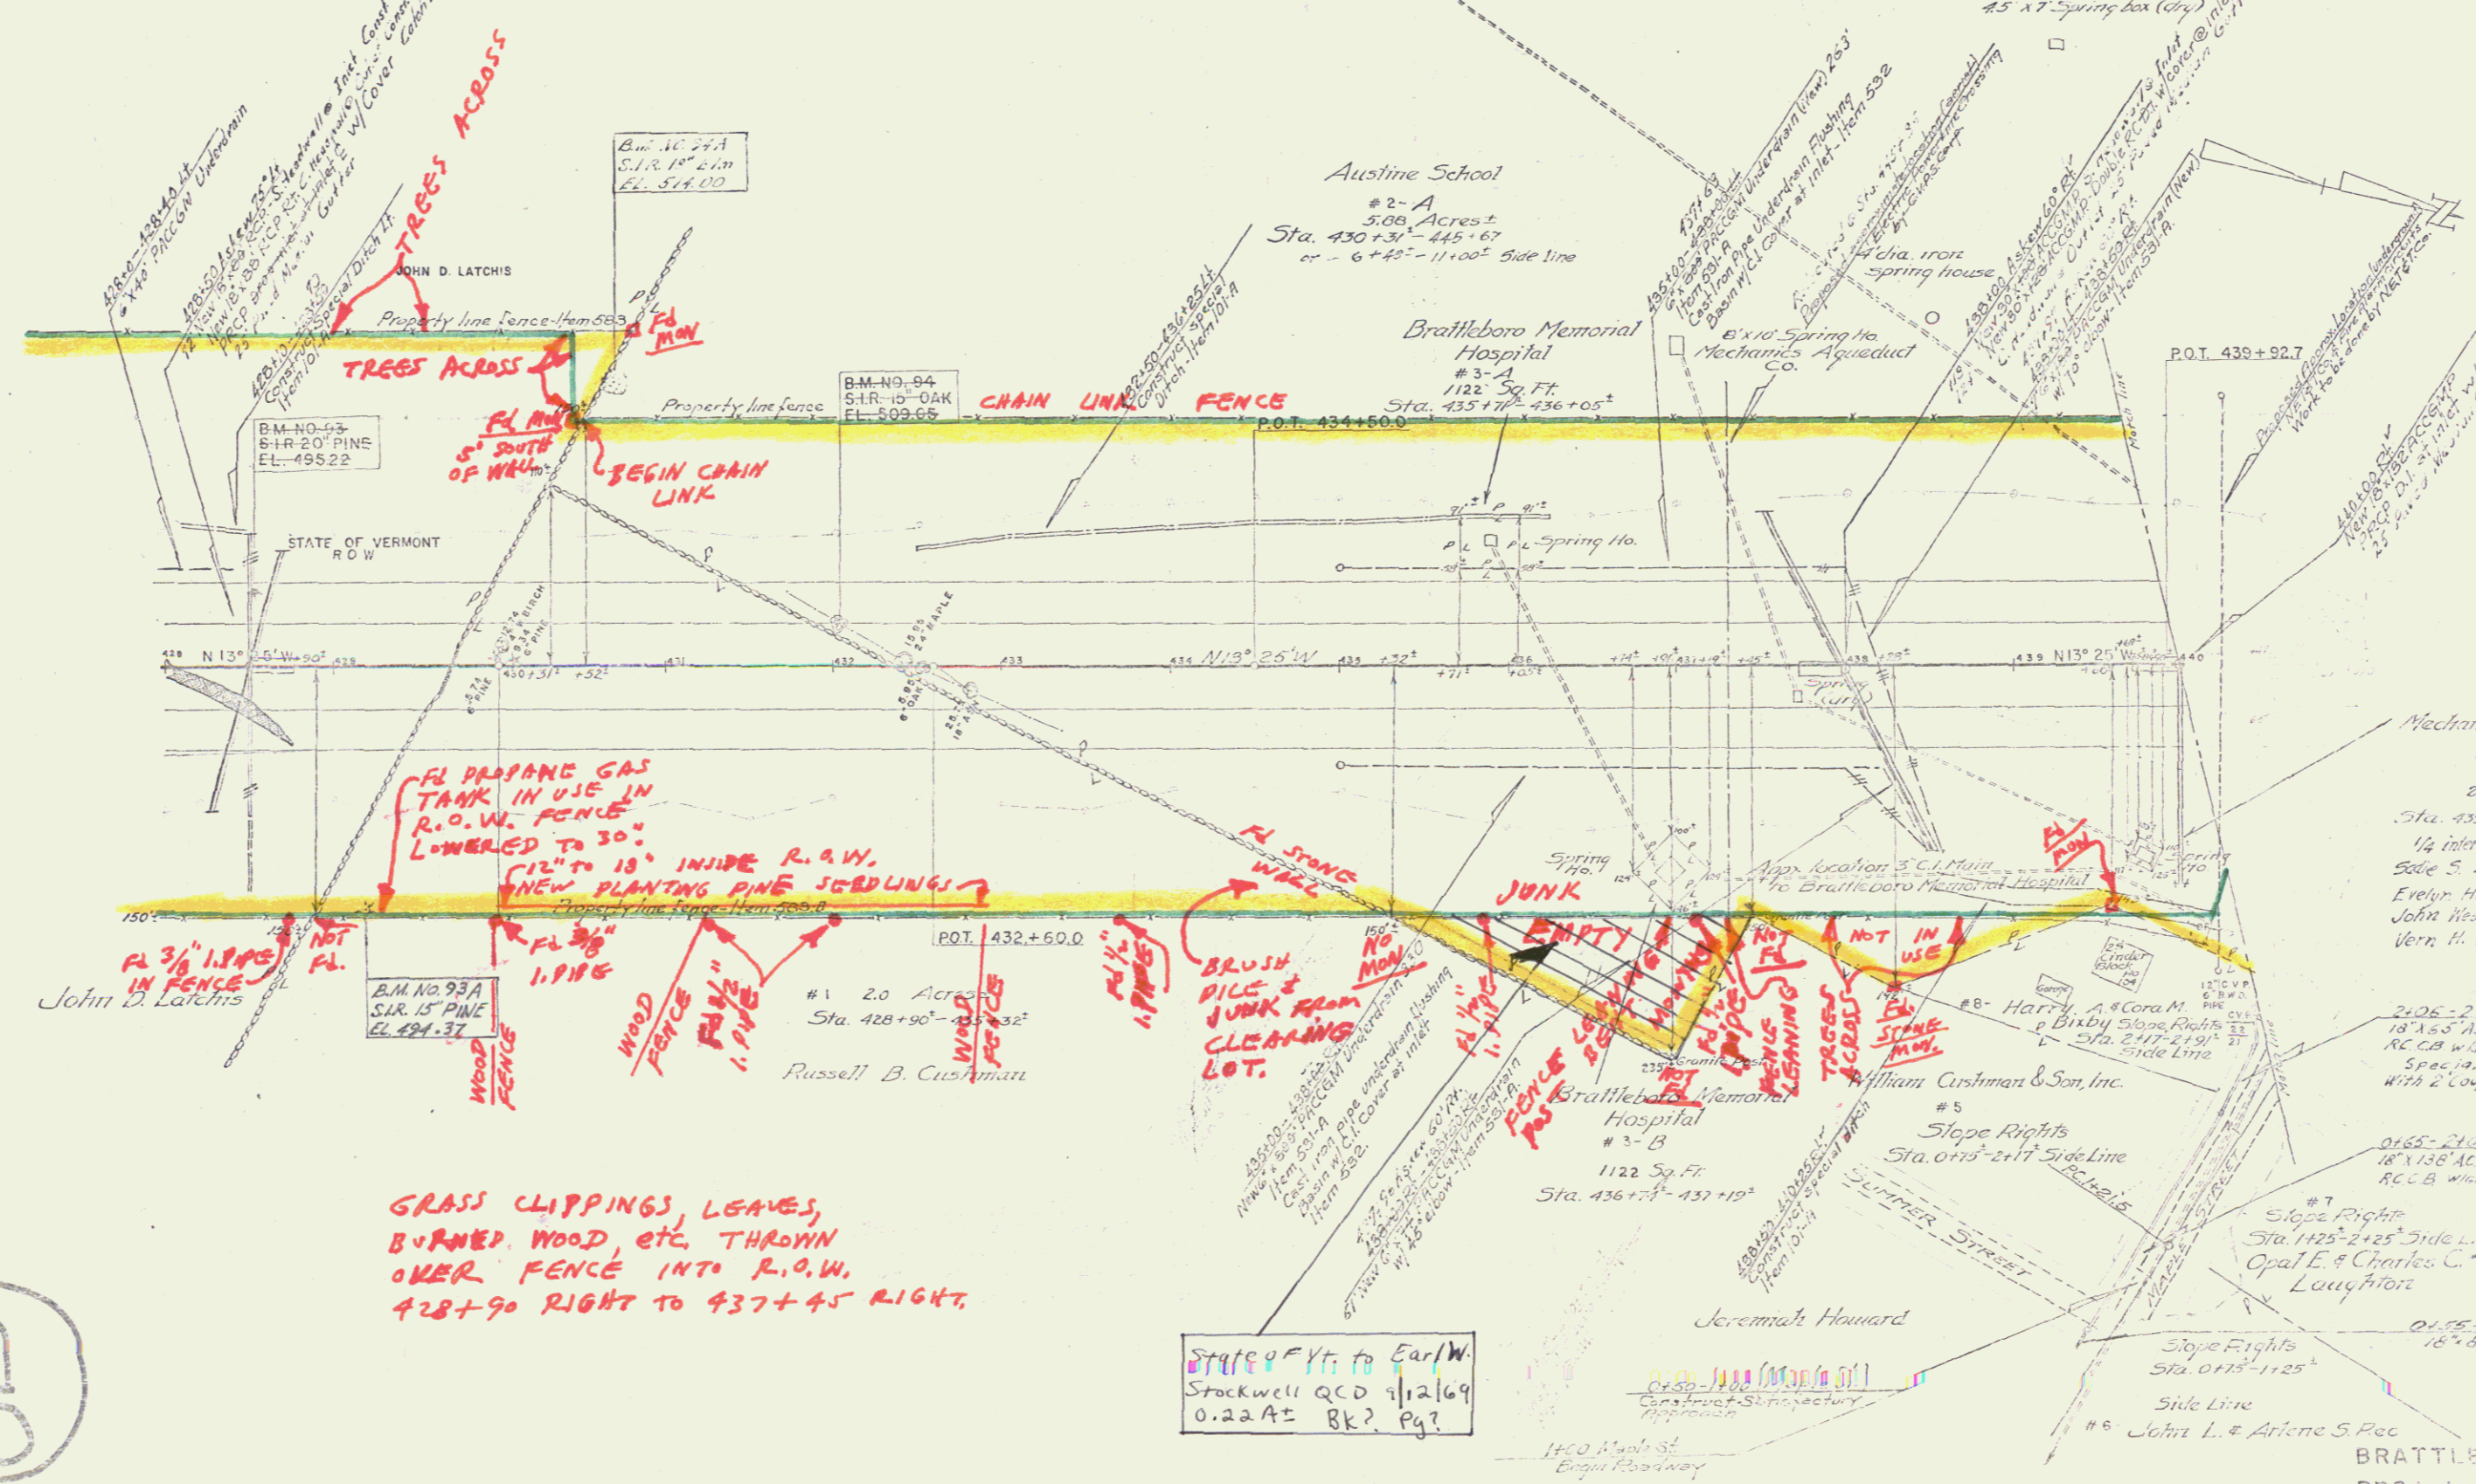

GRASS CLIPPINGS, LEAVES,
 BURNED WOOD, ETC. THROWN
 OVER FENCE INTO R.O.W.
 428+90 RIGHT TO 437+45 RIGHT.

STATE 4' Yr. to Ear/W.
 Stockwell QCD 9/12/69
 0.22 A± BK? Pg?

88

BRATTLEBORO
 PROJ. 1 NO. 91-1(2)
 SHEET 34 OF 496