


S.L. STA. 63+26 - 69+50  
66+52 - 67+17

BOUNDARY MARKERS - For Details See Field Book 14

PROPERTY LINE POSTS ITEM 583-B  
403+35-405+00 405+04-405+00

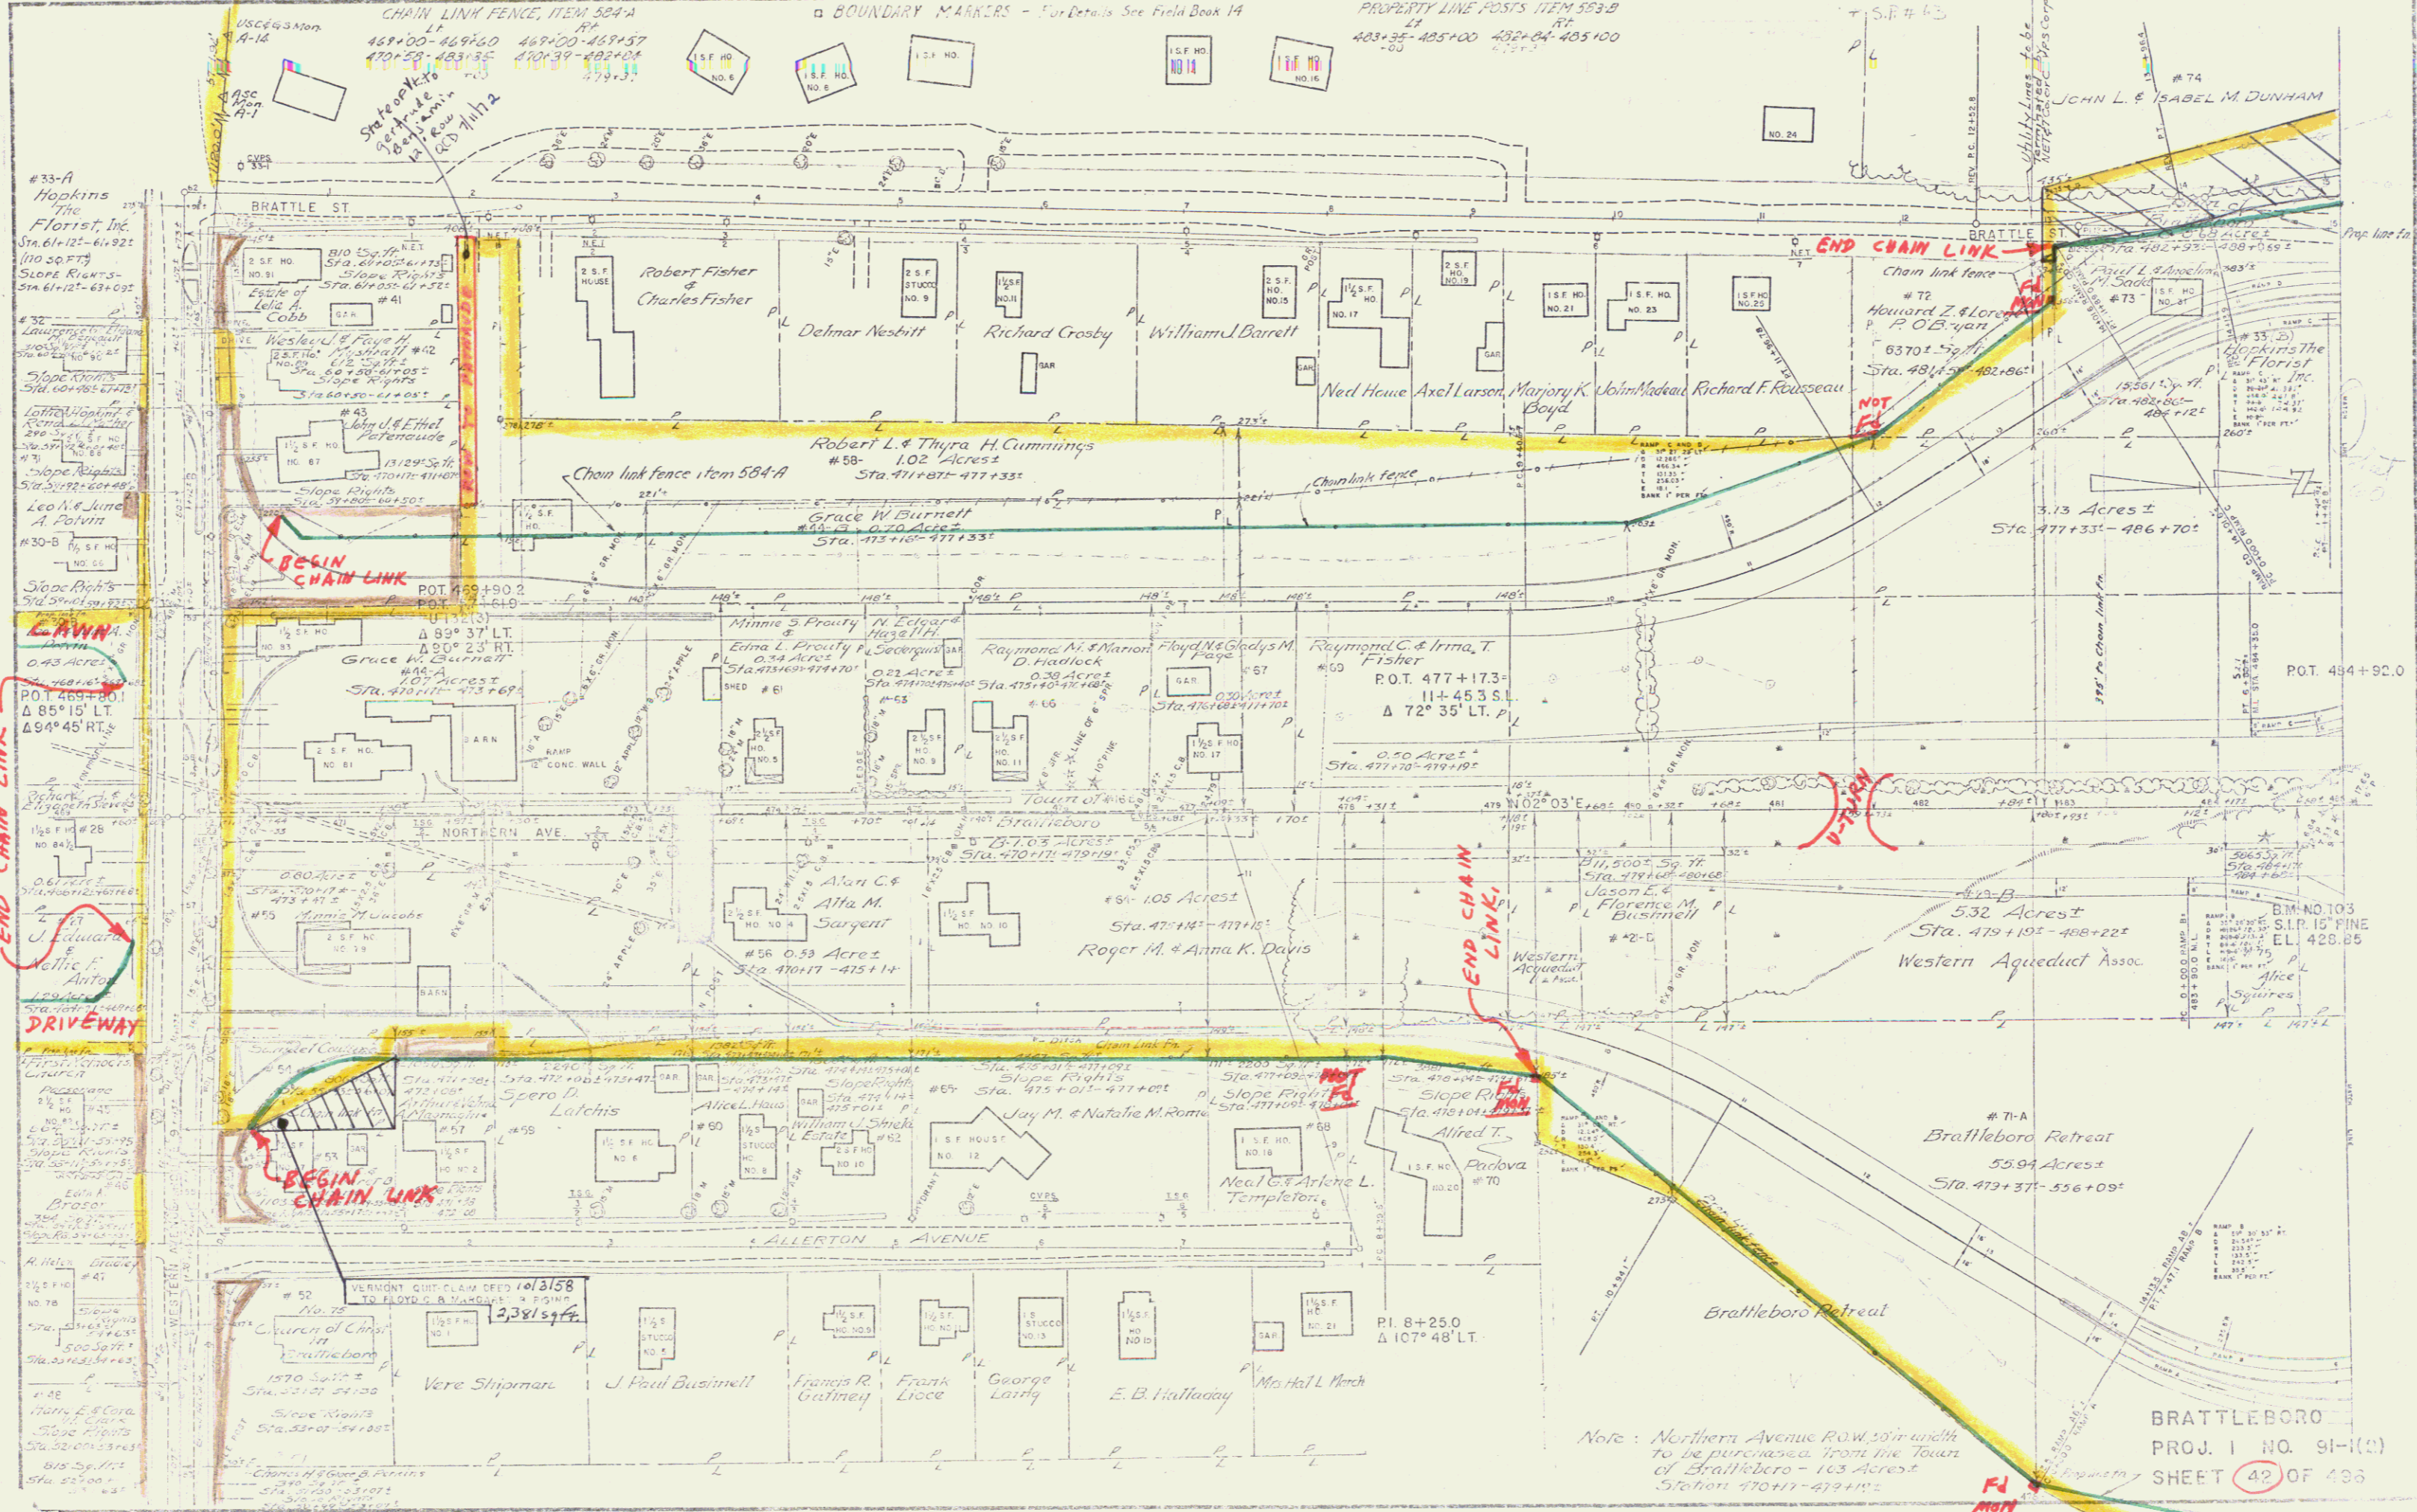

END CHAIN LINK  
LAWN  
0.43 ACRES  
P.O.T. 469+80.1  
Δ 85° 15' LT.  
Δ 59° 45' RT.  
DRIVEWAY

BEGIN CHAIN LINK

END CHAIN LINK

Note: Northern Avenue R.O.W. 50' in width to be purchased from the Town of Brattleboro - 103 Acres Station 470+17 - 479+10

BRATTLEBORO  
PROJ. 1 NO. 91-1(1)  
SHEET 42 OF 496