


GRANITE SLOPE EDGING
 Lt. (Main Line) 21
 469+00-477+35.29

Paved Bit. Conc. Shoulders
 469+00-482+35 Lt. & Rt.

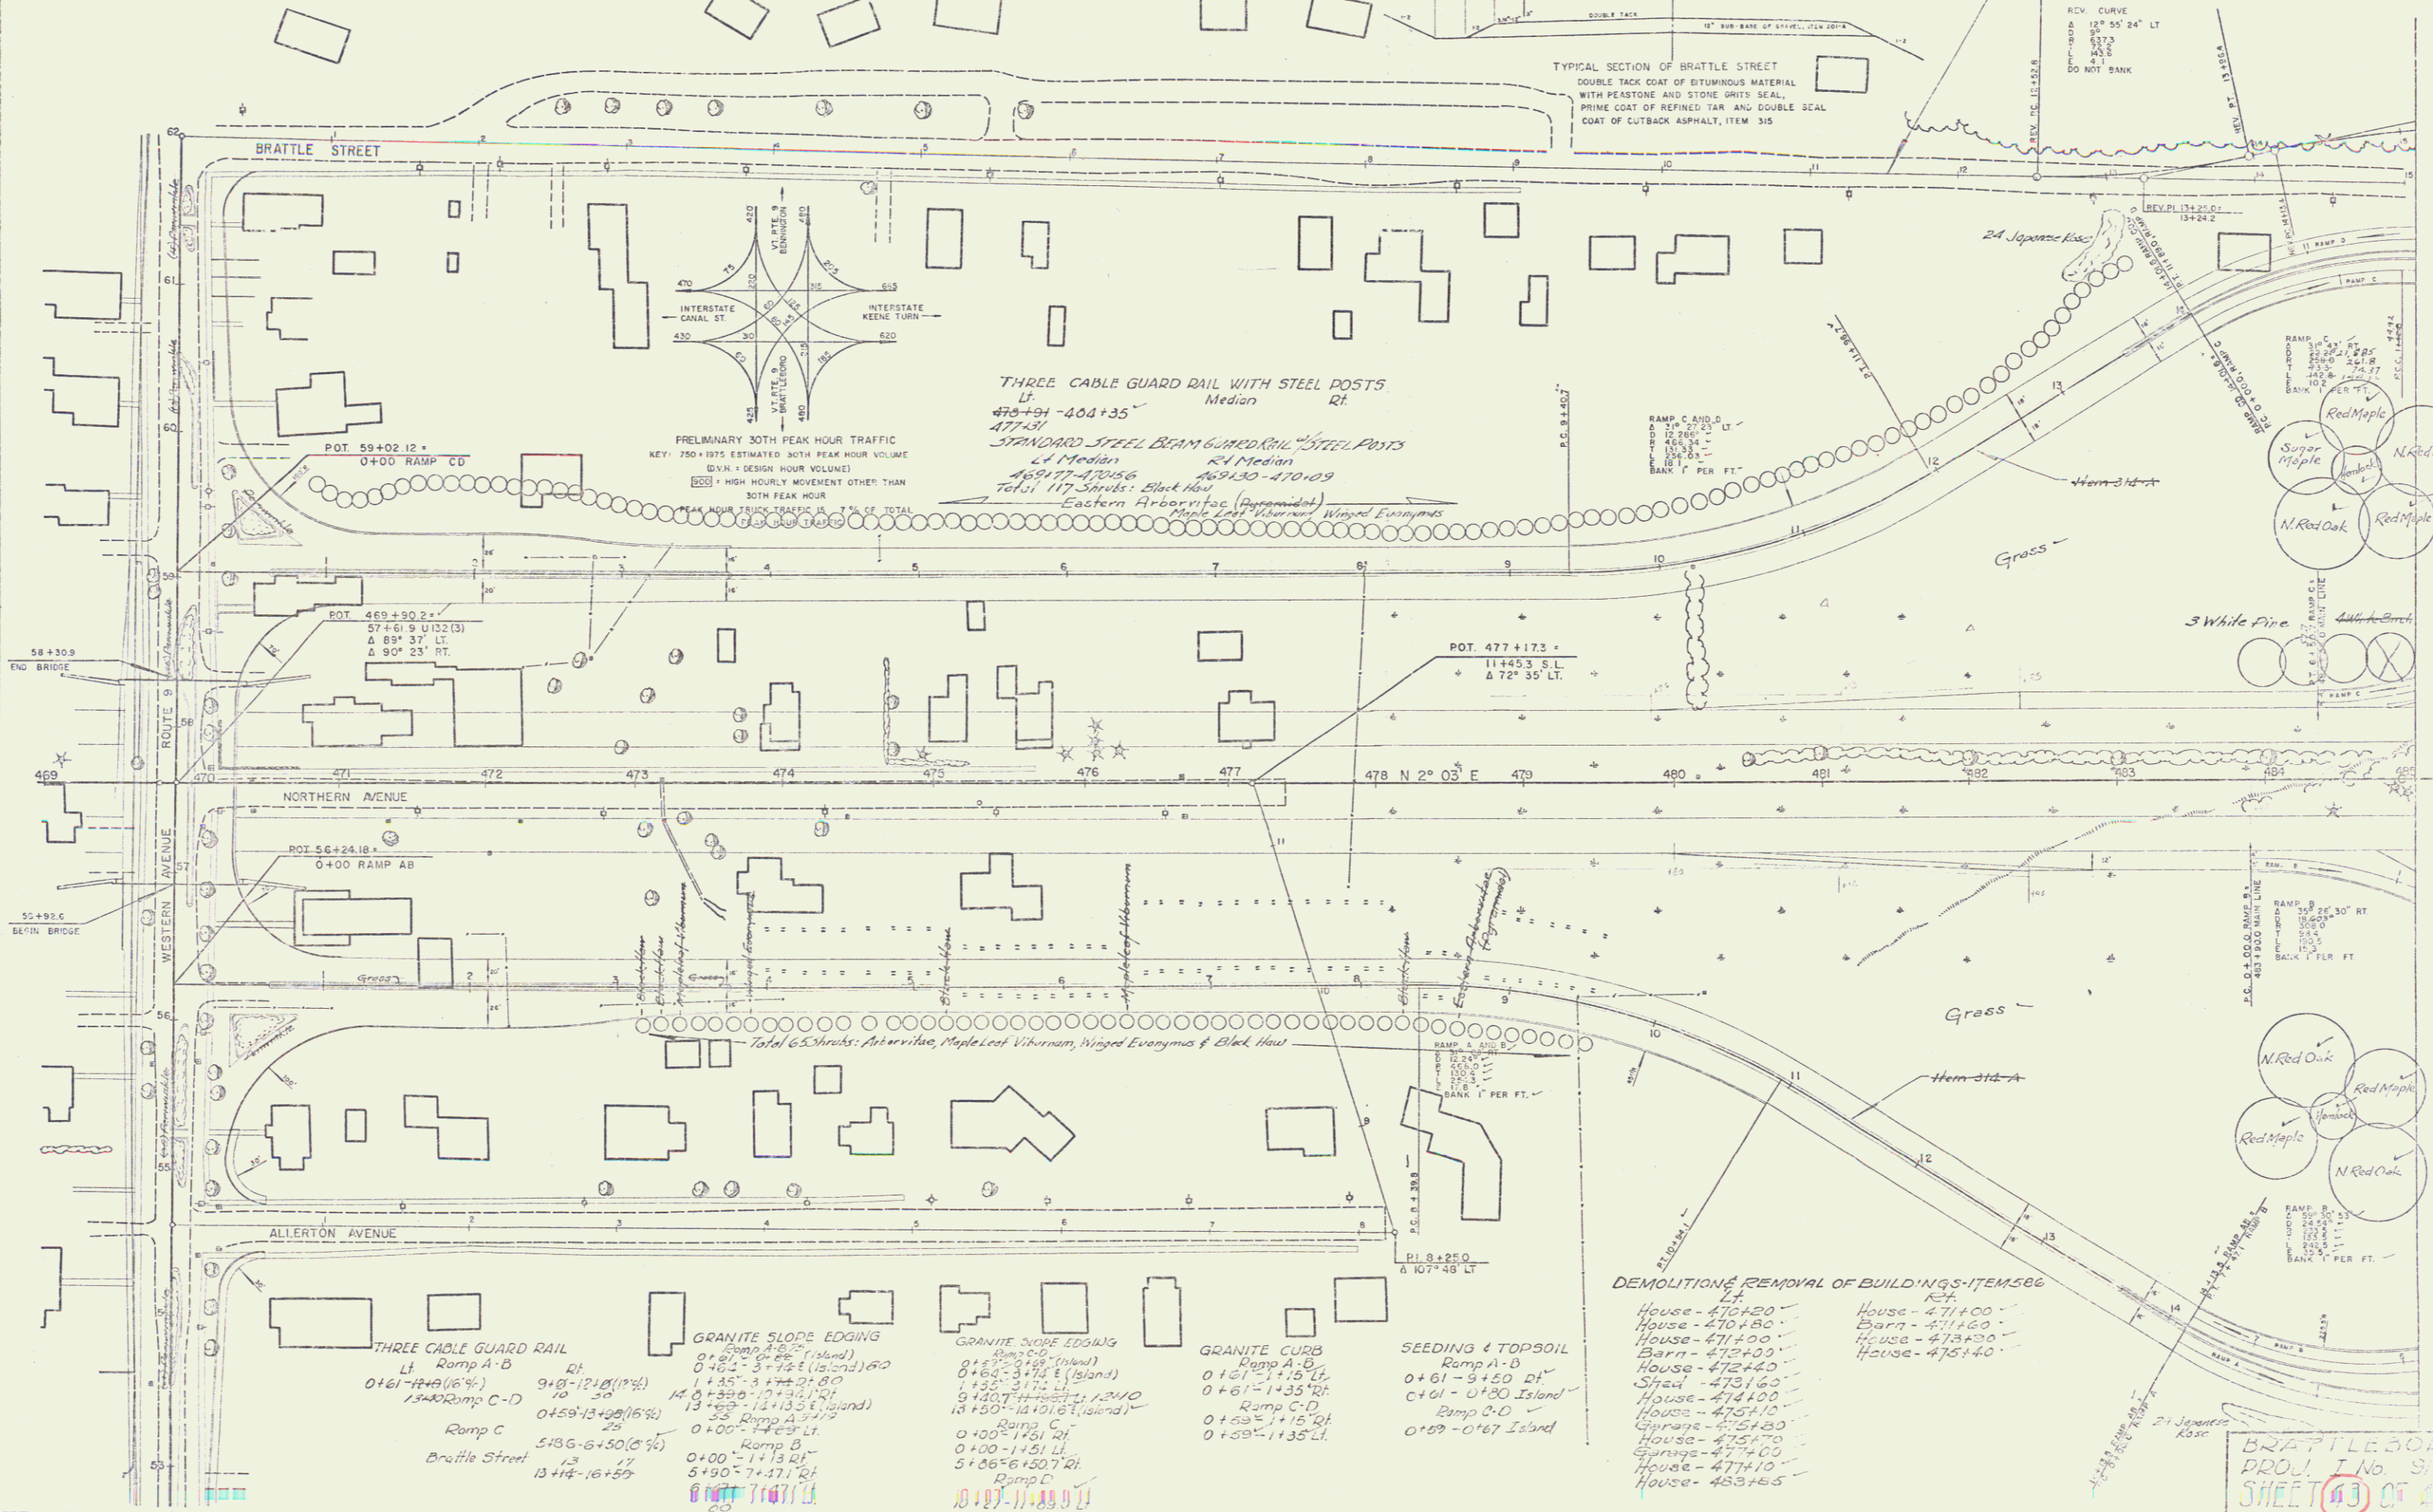

DEMOLITION REMOVAL OF BUILDINGS-ITEMS 566

- House - 470+20
- House - 470+80
- House - 471+00
- House - 472+00
- House - 473+00
- House - 474+00
- House - 475+00
- House - 475+10
- House - 475+20
- House - 475+30
- House - 475+40
- House - 476+00
- House - 477+00
- House - 477+10
- House - 477+20
- House - 477+30
- House - 477+40
- House - 477+50
- House - 478+00
- House - 478+10
- House - 478+20
- House - 478+30
- House - 478+40
- House - 478+50
- House - 479+00
- House - 479+10
- House - 479+20
- House - 479+30
- House - 479+40
- House - 479+50
- House - 480+00
- House - 480+10
- House - 480+20
- House - 480+30
- House - 480+40
- House - 480+50
- House - 481+00
- House - 481+10
- House - 481+20
- House - 481+30
- House - 481+40
- House - 481+50
- House - 482+00
- House - 482+10
- House - 482+20
- House - 482+30
- House - 482+40
- House - 482+50
- House - 483+00
- House - 483+10
- House - 483+20
- House - 483+30
- House - 483+40
- House - 483+50

BRATTLE STREET
 PROJ. No. SP-121
 SHEET 43 OF 48