

74 JOHN L & ISABEL M DURHAM
STA 42+93 - 486+68 (10.56 A)
SLOPE RIGHTS - STA 45+68 - 482+52

BRATTLE ST RELOCATION
REV. 11.16.93
REV. 08.15.24
REV. 08.15.24
REV. 08.15.24

BRATTLEBORO RETREAT
WOODS & PASTURE
WOODS & BRUSH
MEADOW

BRATTLEBORO RETREAT
WOODS & BRUSH
PINE WOODS

DRILLING & BLASTING OF SOLID ROCK - ITEM 114 (Mod.)
Ramp A
5+410 - 4+754
1+20 - 1+175
Ramp B
9+185 - 1+183
Ramp C
1+50 - 3+100
Ramp D
1+50 - 3+100

PROPERTY LINE FENCE ITEM 583-B
LT
485+00 - 504+30
485+00 - 501+00
489+75 - 504+00

BRATTLEBORO RETREAT
WOODS & PASTURE
WOODS & BRUSH
MEADOW

BRATTLEBORO RETREAT
WOODS & BRUSH
PINE WOODS

BRATTLEBORO RETREAT
WOODS & PASTURE
WOODS & BRUSH
MEADOW

BRATTLEBORO RETREAT
WOODS & PASTURE
WOODS & BRUSH
MEADOW

BRATTLEBORO RETREAT
WOODS & PASTURE
WOODS & BRUSH
MEADOW

BRATTLEBORO RETREAT
WOODS & BRUSH
PINE WOODS

FRANKLIN N. DESSAINT
0.3A
10/6/61
BK? P3?

BRATTLEBORO RETREAT
WOODS & PASTURE
WOODS & BRUSH
MEADOW

BRATTLEBORO RETREAT
WOODS & PASTURE
WOODS & BRUSH
MEADOW

BRATTLEBORO RETREAT
WOODS & BRUSH
PINE WOODS

BRATTLEBORO RETREAT
WOODS & PASTURE
WOODS & BRUSH
MEADOW

BRATTLEBORO RETREAT
WOODS & PASTURE
WOODS & BRUSH
MEADOW

BRATTLEBORO RETREAT
WOODS & PASTURE
WOODS & BRUSH
MEADOW


BRATTLEBORO RETREAT
WOODS & BRUSH
PINE WOODS

BRATTLEBORO RETREAT
WOODS & PASTURE
WOODS & BRUSH
MEADOW

BRATTLEBORO RETREAT
WOODS & PASTURE
WOODS & BRUSH
MEADOW

BRATTLEBORO RETREAT
WOODS & PASTURE
WOODS & BRUSH
MEADOW

BRATTLEBORO RETREAT
WOODS & BRUSH
PINE WOODS

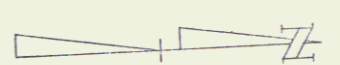

BRATTLEBORO
PROJ. 1 NO. 91-1(2)
SHEET 60 OF 498

10