


DRILLING AND BLASTING
OF SOLID ROCK SUBGRADE-ITEM 503 (Mod)
501100 - 501100
511100 - 511100
501100 - 501100
501175 - 501175
501100 - 511100
511100 - 511100

PROPERTY LINE FENCE ITEM 503-B
L.F. 501100-511100
R.F. 501100-511100

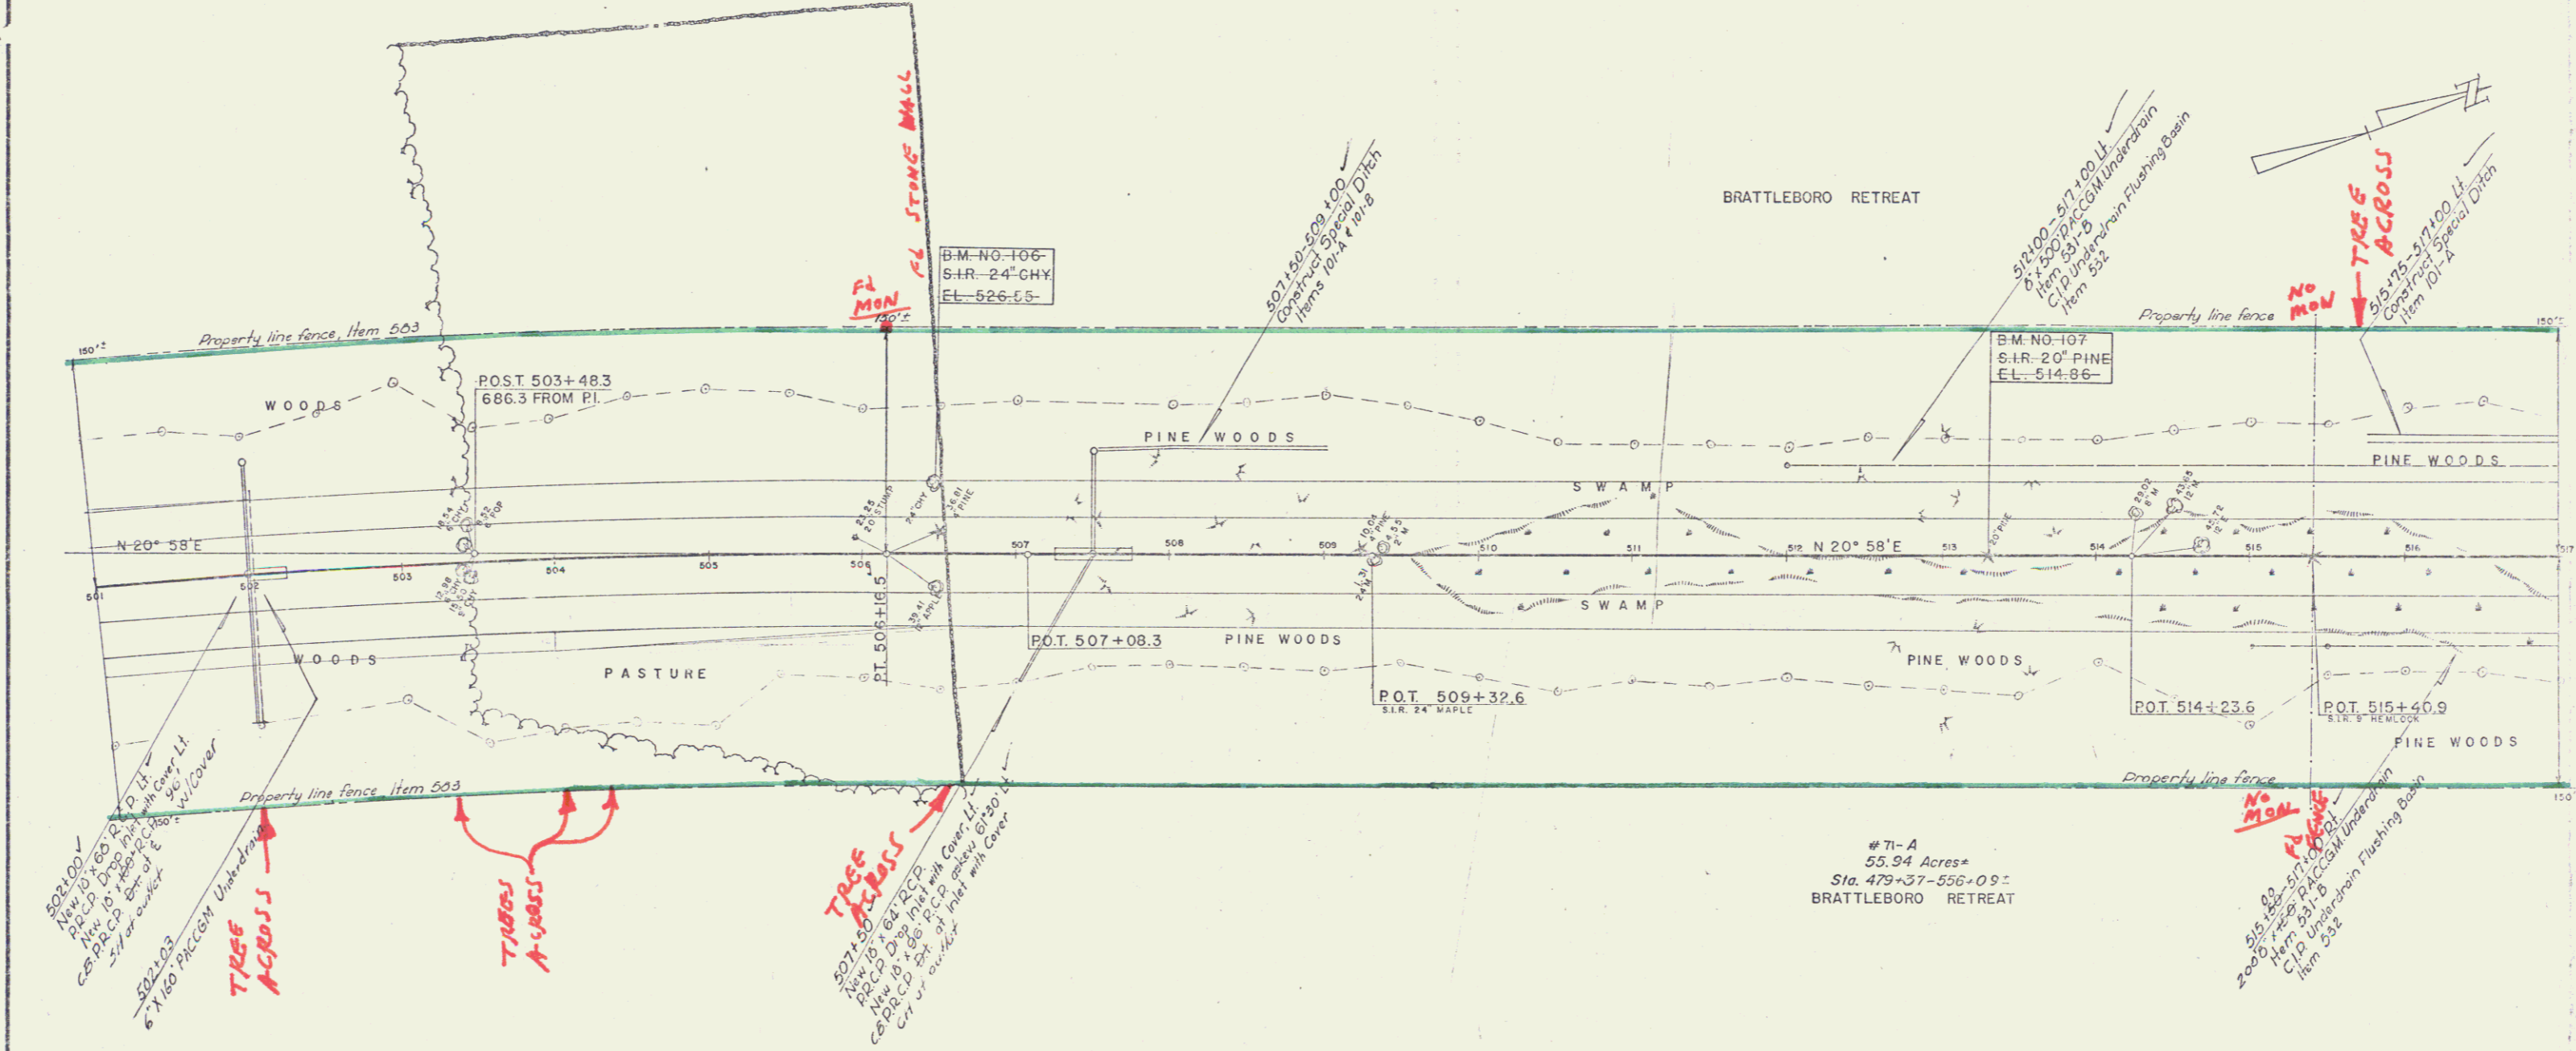

71-A
55.94 Acres
Sta. 479+37-556+09
BRATTLEBORO RETREAT

BRATTLEBORO
PROJ. 1 NO. 91-1(2)
SHEET 63 OF 496