


PROPERTY LINE FENCE ITEM 583-B  
44  
517+00-533+00' 517+00-533+00'

MATCH MARKS - SEE SHEET #  
Traverse to spring boxes

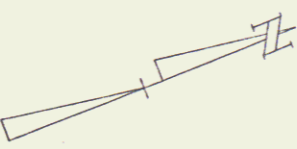

BRATTLEBORO  
PROJ. NO. 91-1(2)  
SHEET 65 OF 496