


THREE CABLE GUARD RAIL WITH STEEL POSTS
 6.5' Lt. Median Lt. Rt. PROPERTY LINE/FENCE ITEM 503-B
 547+65-549+00 Lt. Rt. 533+00-547+00 533+00-549+00

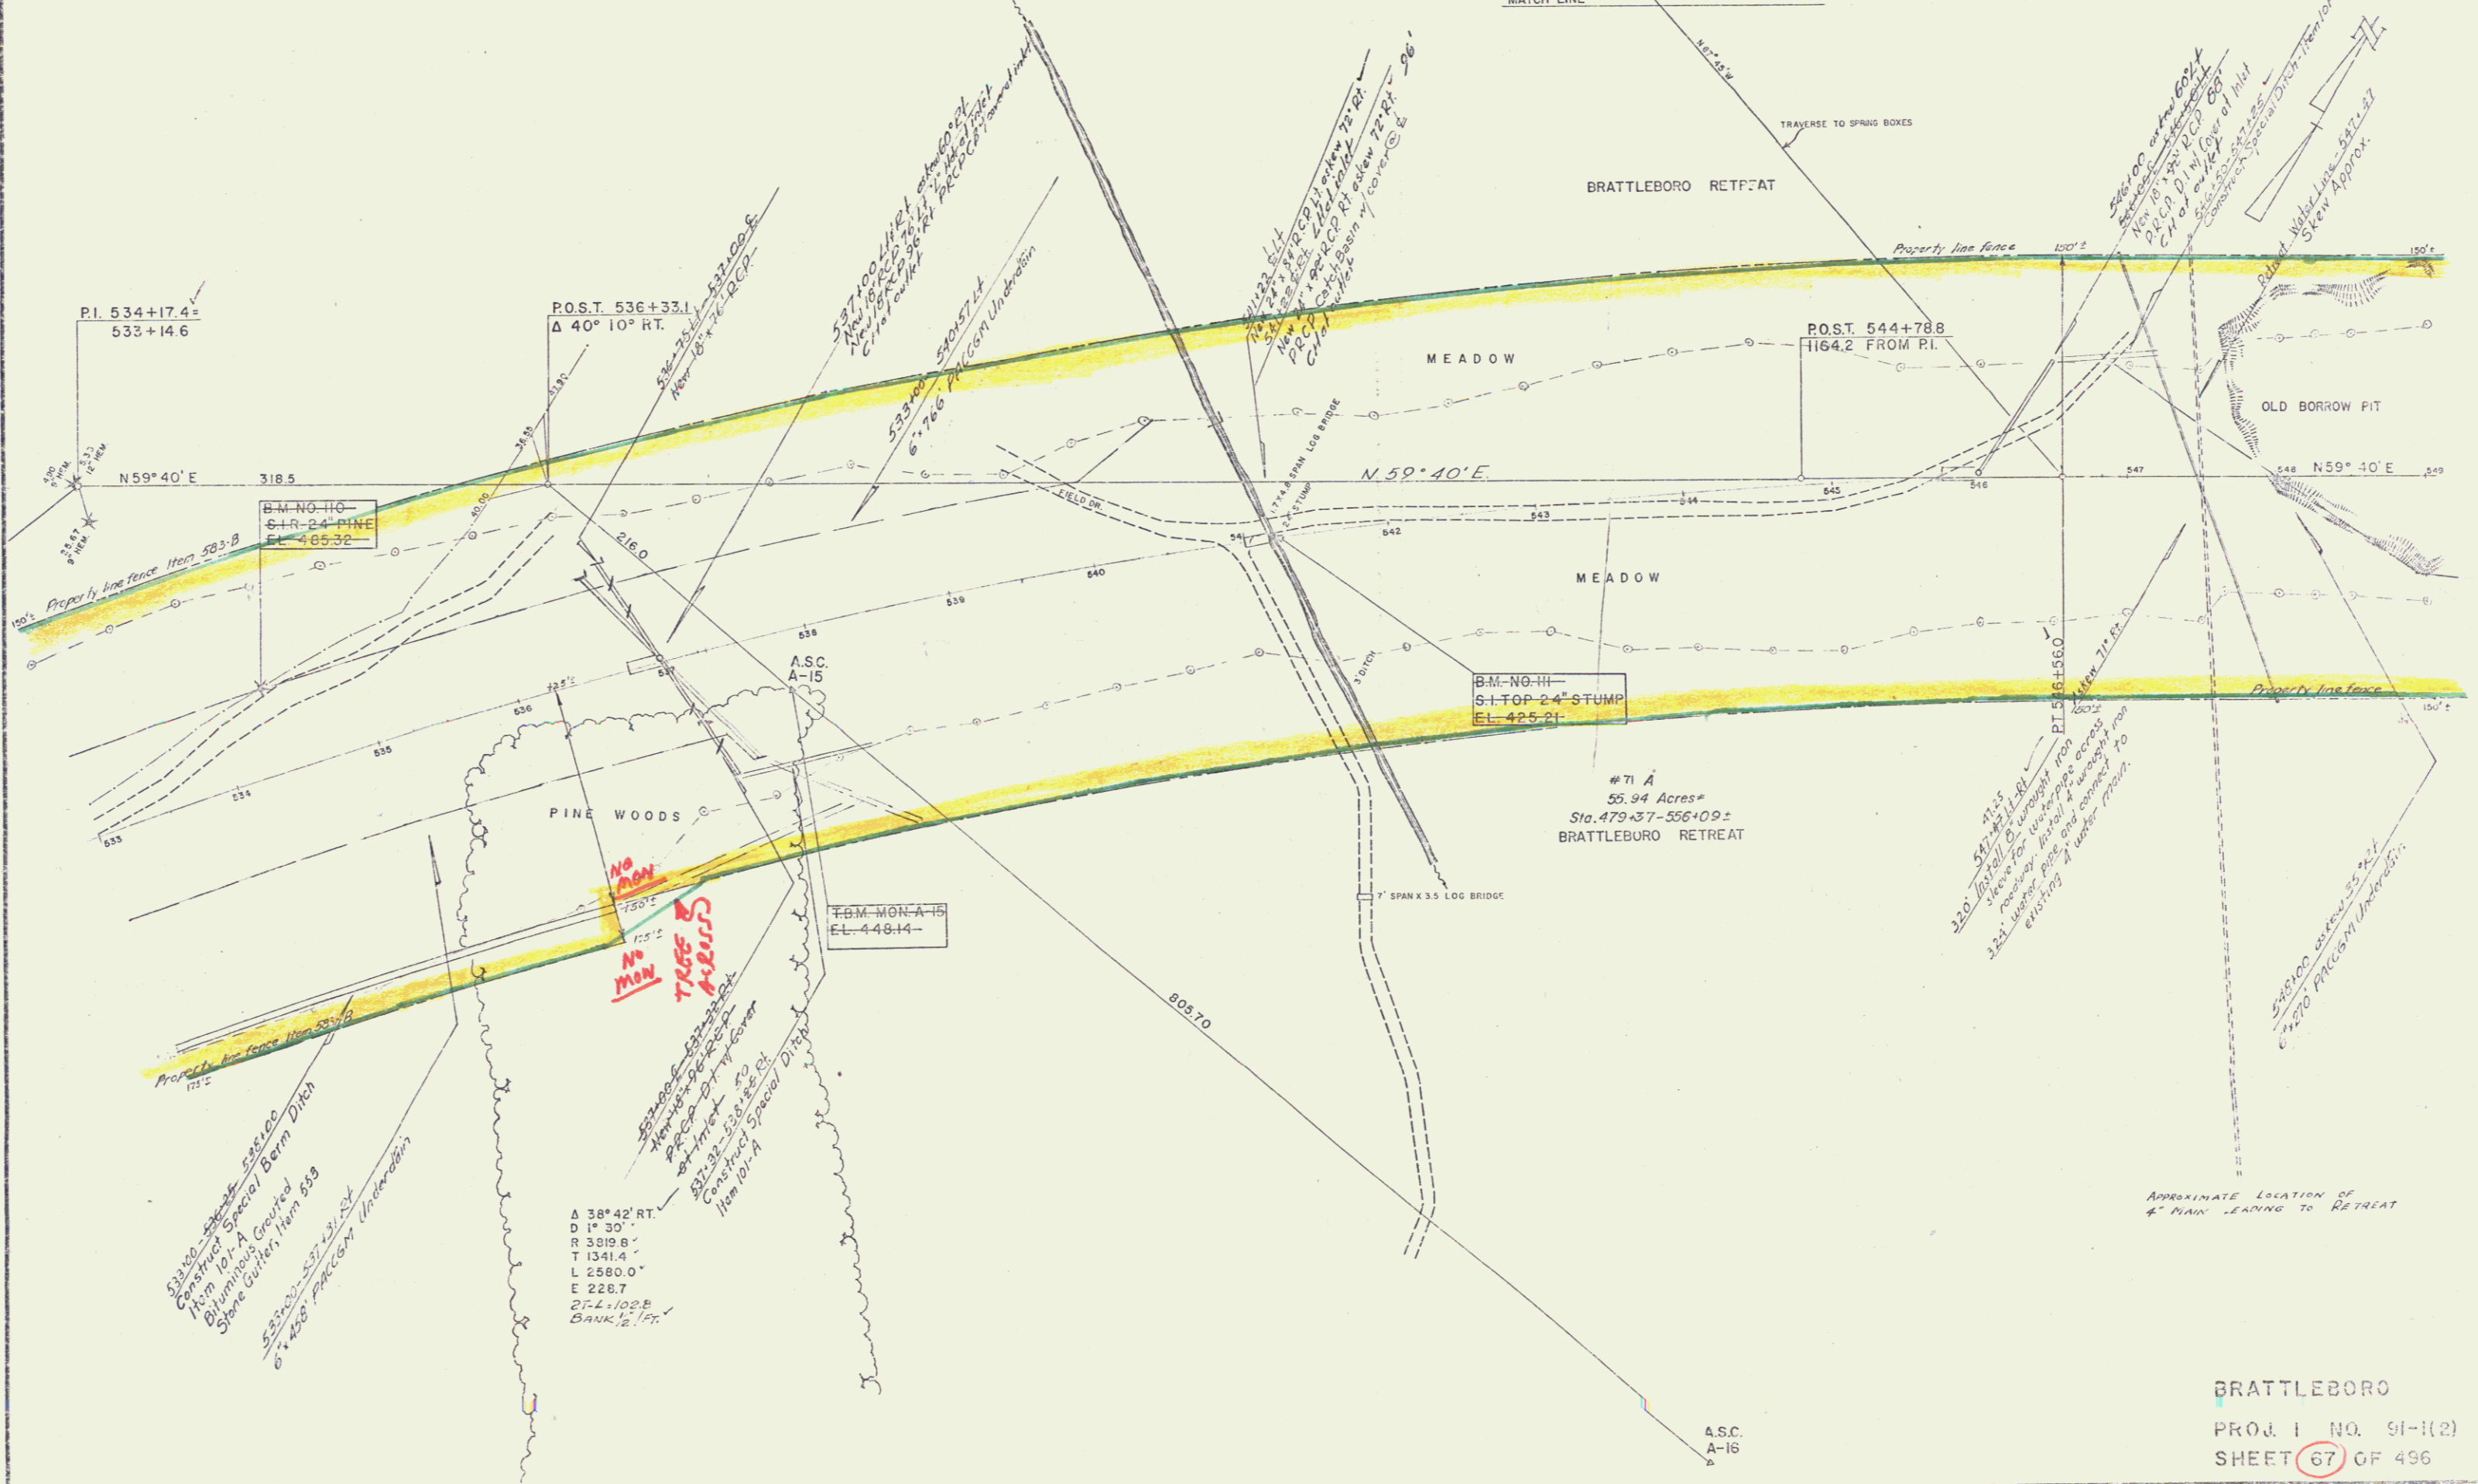

533+00 - 547+00
 Centerline Special Berm Ditch
 6' x 42" Precast Concrete Underdrain
 533+00 - 547+00
 6' x 42" Precast Concrete Underdrain

Δ 38° 42' RT.
 D 1' 30"
 R 3819.8'
 T 1341.4'
 L 2580.0'
 E 228.7'
 21-2+102.8
 BANK 1/2 Ft.

**NO
 MIN
 TREE
 TRAILS**

533+00 - 547+00
 Centerline Special Berm Ditch
 6' x 42" Precast Concrete Underdrain
 533+00 - 547+00
 6' x 42" Precast Concrete Underdrain

210' 21.15'
 547+00 - 549+00
 Centerline Special Berm Ditch
 6' x 42" Precast Concrete Underdrain
 547+00 - 549+00
 6' x 42" Precast Concrete Underdrain

547+00 - 549+00
 Centerline Special Berm Ditch
 6' x 42" Precast Concrete Underdrain
 547+00 - 549+00
 6' x 42" Precast Concrete Underdrain

APPROXIMATE LOCATION OF
 4" MAIN LEADING TO RETREAT

BRATTLEBORO
 PROJ. I NO. 91-1(2)
 SHEET 67 OF 496