

THREE CABLE GUARD RAIL IN MEDIAN AT BRIDGE APPROACHES
 553+1.66 553+62-553+62.4
 555+1.06 553+60-553+75.4
 556+00.45 555+65-555+62.4
 555+62.5 555+62.4
 561+62-561+62.4


PAVED OUTSIDE SHOULDER W/ BIT. CURB
 Lt. Rt.
 550+75-553+34 550+75-553+63
 555+27-562+00 555+56-562+00

PAVED SHOULDER DRAIN
 558+00 Lt. & Rt.

THREE CABLE GUARD RAIL WITH STEEL POSTS
 Lt. Rt. Median Lt.
 549+00-553+63 549+00-553+63
 554+96-562+00 554+96-562+00

PROPERTY LINE FENCE, ITEM 563-B
 Lt. Rt. Lt. Rt.
 549+00-553+63 549+00-554+13
 554+96-562+00 554+96-562+00

DEMOLITION & REMOVAL OF BUILDINGS-ITEM 566
 Lt. Rt.
 Spring No. 555+190

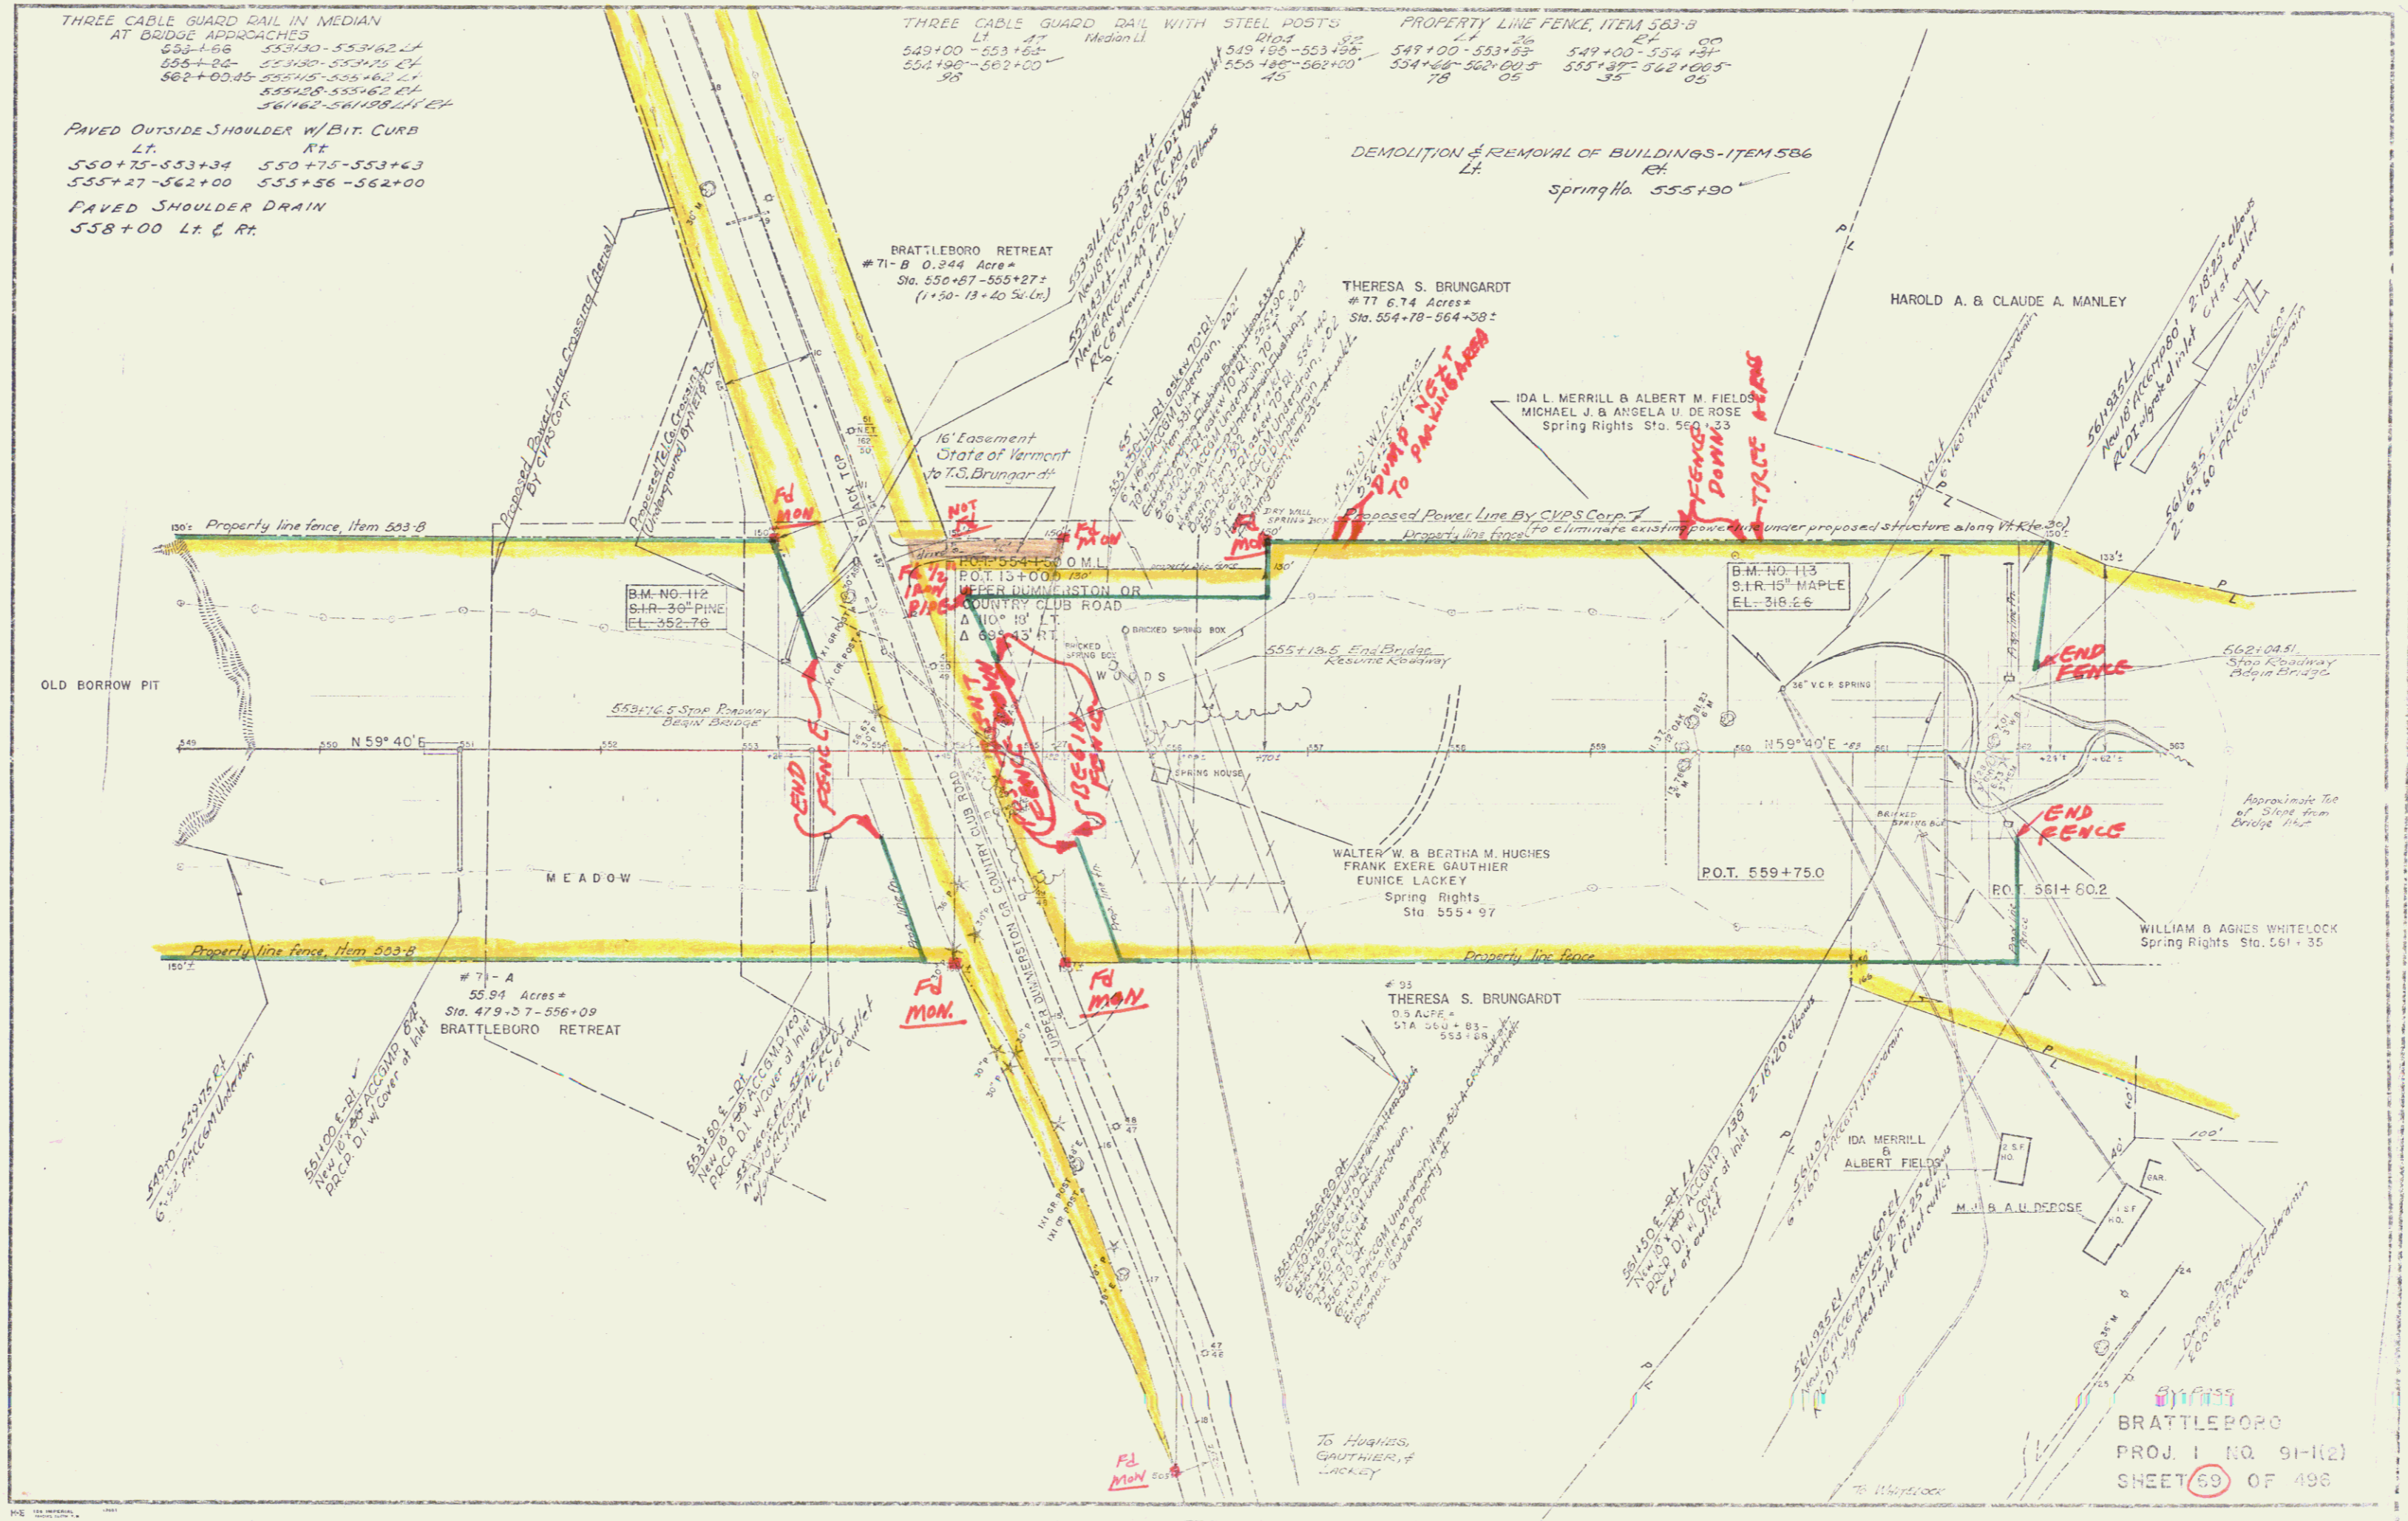

BRATTLEBORO
 PROJ. 1 NO. 91-112
 SHEET 69 OF 496