



THREE CABLE GUARD RAIL W/ STEEL POSTS
 LT 2+65 - 3+74 2+02 - 3+44
 RT 2+31 - 3+56 1+58 - 3+13

REMOVAL AND DISPOSAL
 OF EXISTENT GUARD RAIL
 LT 3+10 - 3+80 RT 2+20 - 3+24
 CONSTRUCT DRIVES
 LT 1+15 RT 3+50

77
 THERESA S. BRUNGARD
 6.74 Acres =
 Sta. 554+79-564+38"

BRATTLEBORO RETREAT
 # 71 B
 0.844 Acres =
 Sta. 550+57-555+27"
 (1+50 - 131.00 55.00)

71 A
 55.94 Acres =
 Sta. 479+37-556+09"
 BRATTLEBORO RETREAT

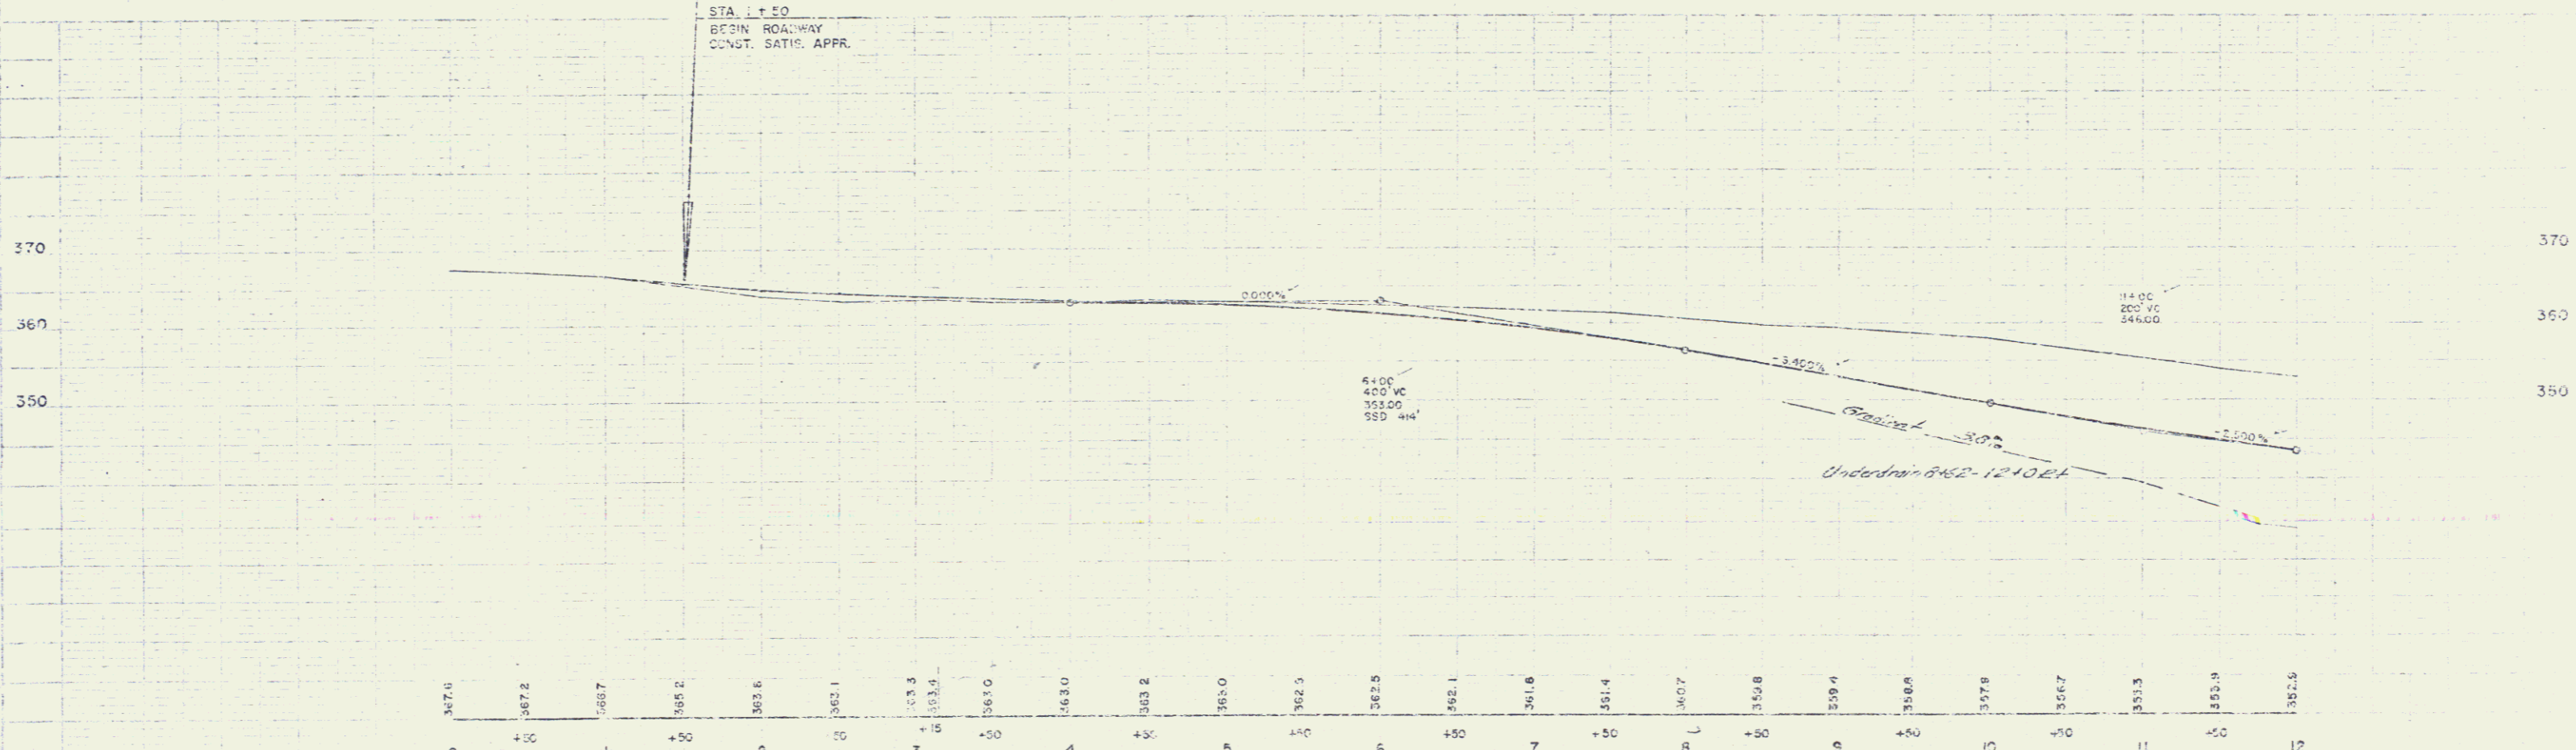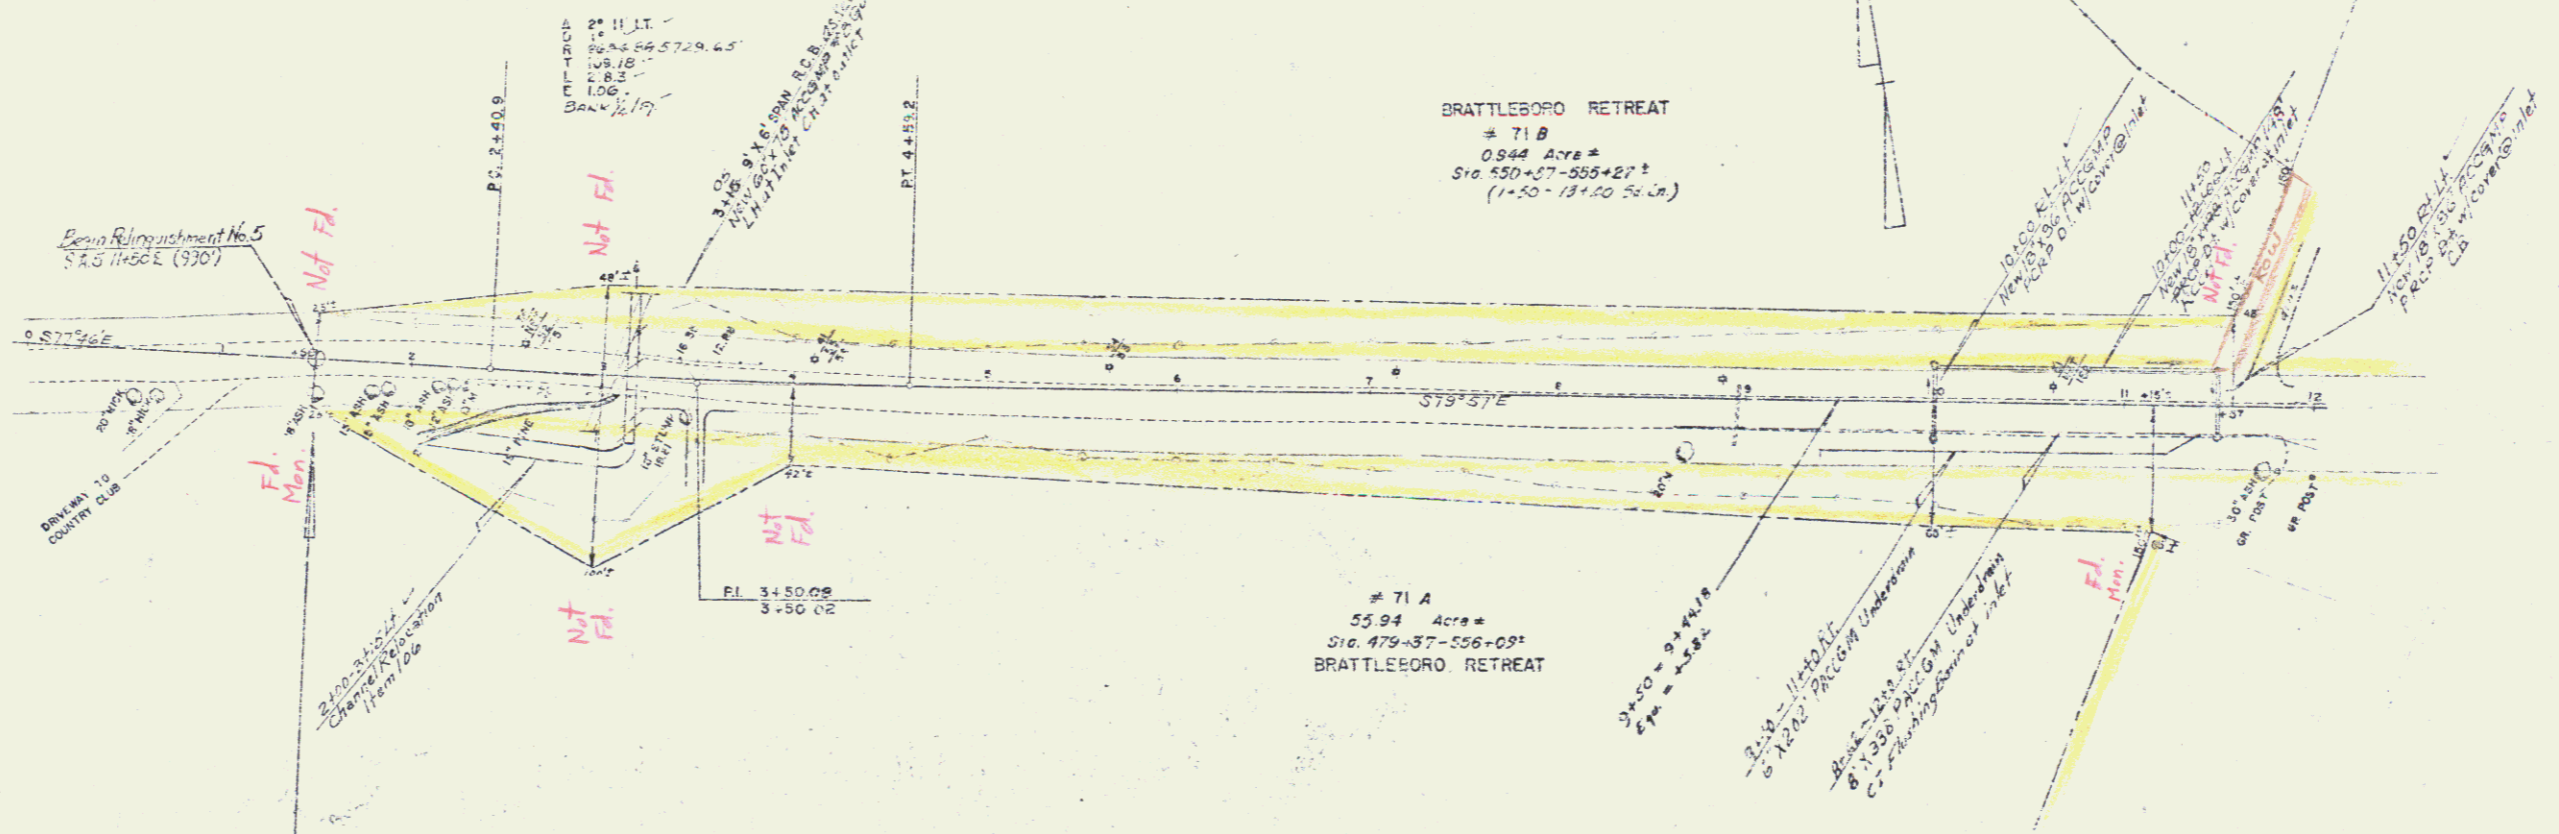

12
 (COUNTRY CLUB ROAD)
 BRATTLEBORO
 PROJECT I 91-112
 SHEET 71 OF 45E