

Seeding - Item G11
Seed Steep Slopes With
Crown Vetch 20 Lbs./Acre
Creeping Red Fescue 30 Lbs./Acre
1104+00 - 1105+50 Rt.

Three Cable Guard Rail With Steel Posts
1103 + 00 to 1105 + 50 Lt.
1107 + 25 to 1108 + 00 Lt.
1110 + 48 to 1112 + 22 Lt.
1112 + 25 to 1113 + 00 Lt.

Property Line Fence With Steel Posts
1103 + 00 to 1107 + 00 Lt.
1107 + 00 to 1117 + 00 Lt.
1101 + 00 to 1117 + 00 Lt.

Construct Special Ditch
Link No. 101 - C
1110 + 10 to 1110 + 70 Lt.
Construct U - Turn
1107 + 00
1107 + 00


Reinforced Concrete Edge Gutter
Item No. 553
1110 + 70 to 1111 + 50 Lt.
1105 + 00 Rt.
1105 + 00 - 1105 + 25 Lt.
1109 + 00 - 1110 + 25 Lt.

Paved Median Gutter
1104 + 25 to 1105 + 00
1110 + 25 to 1110 + 50
1115 + 25 to 1115 + 50
1103 + 75 - 1104 + 50
1107 + 25 - 1107 + 50
1111 + 75 - 1113 + 00

PUB. NO.	STATE	PROJ. NO.	SHEET NO.	TOTAL SHEETS
1	VT	91-110	33	328

#40B - HENRY W & LURA H FROST
(A-40) STA 1113+06-1119+33±
DITCH RIGHTS - STA 1118+50± LT. B RT.
W. D. 8/12/59
REC.: PUTNEY BK. 35 - PG 352-8/20/59

#41 - JAMES B & OLGA GERNERT GREENE
(A-788) STA 1101+62-1113+65±
W. D. 7/13/59
REC.: PUTNEY BK. 35 - PG 362-7/17/59

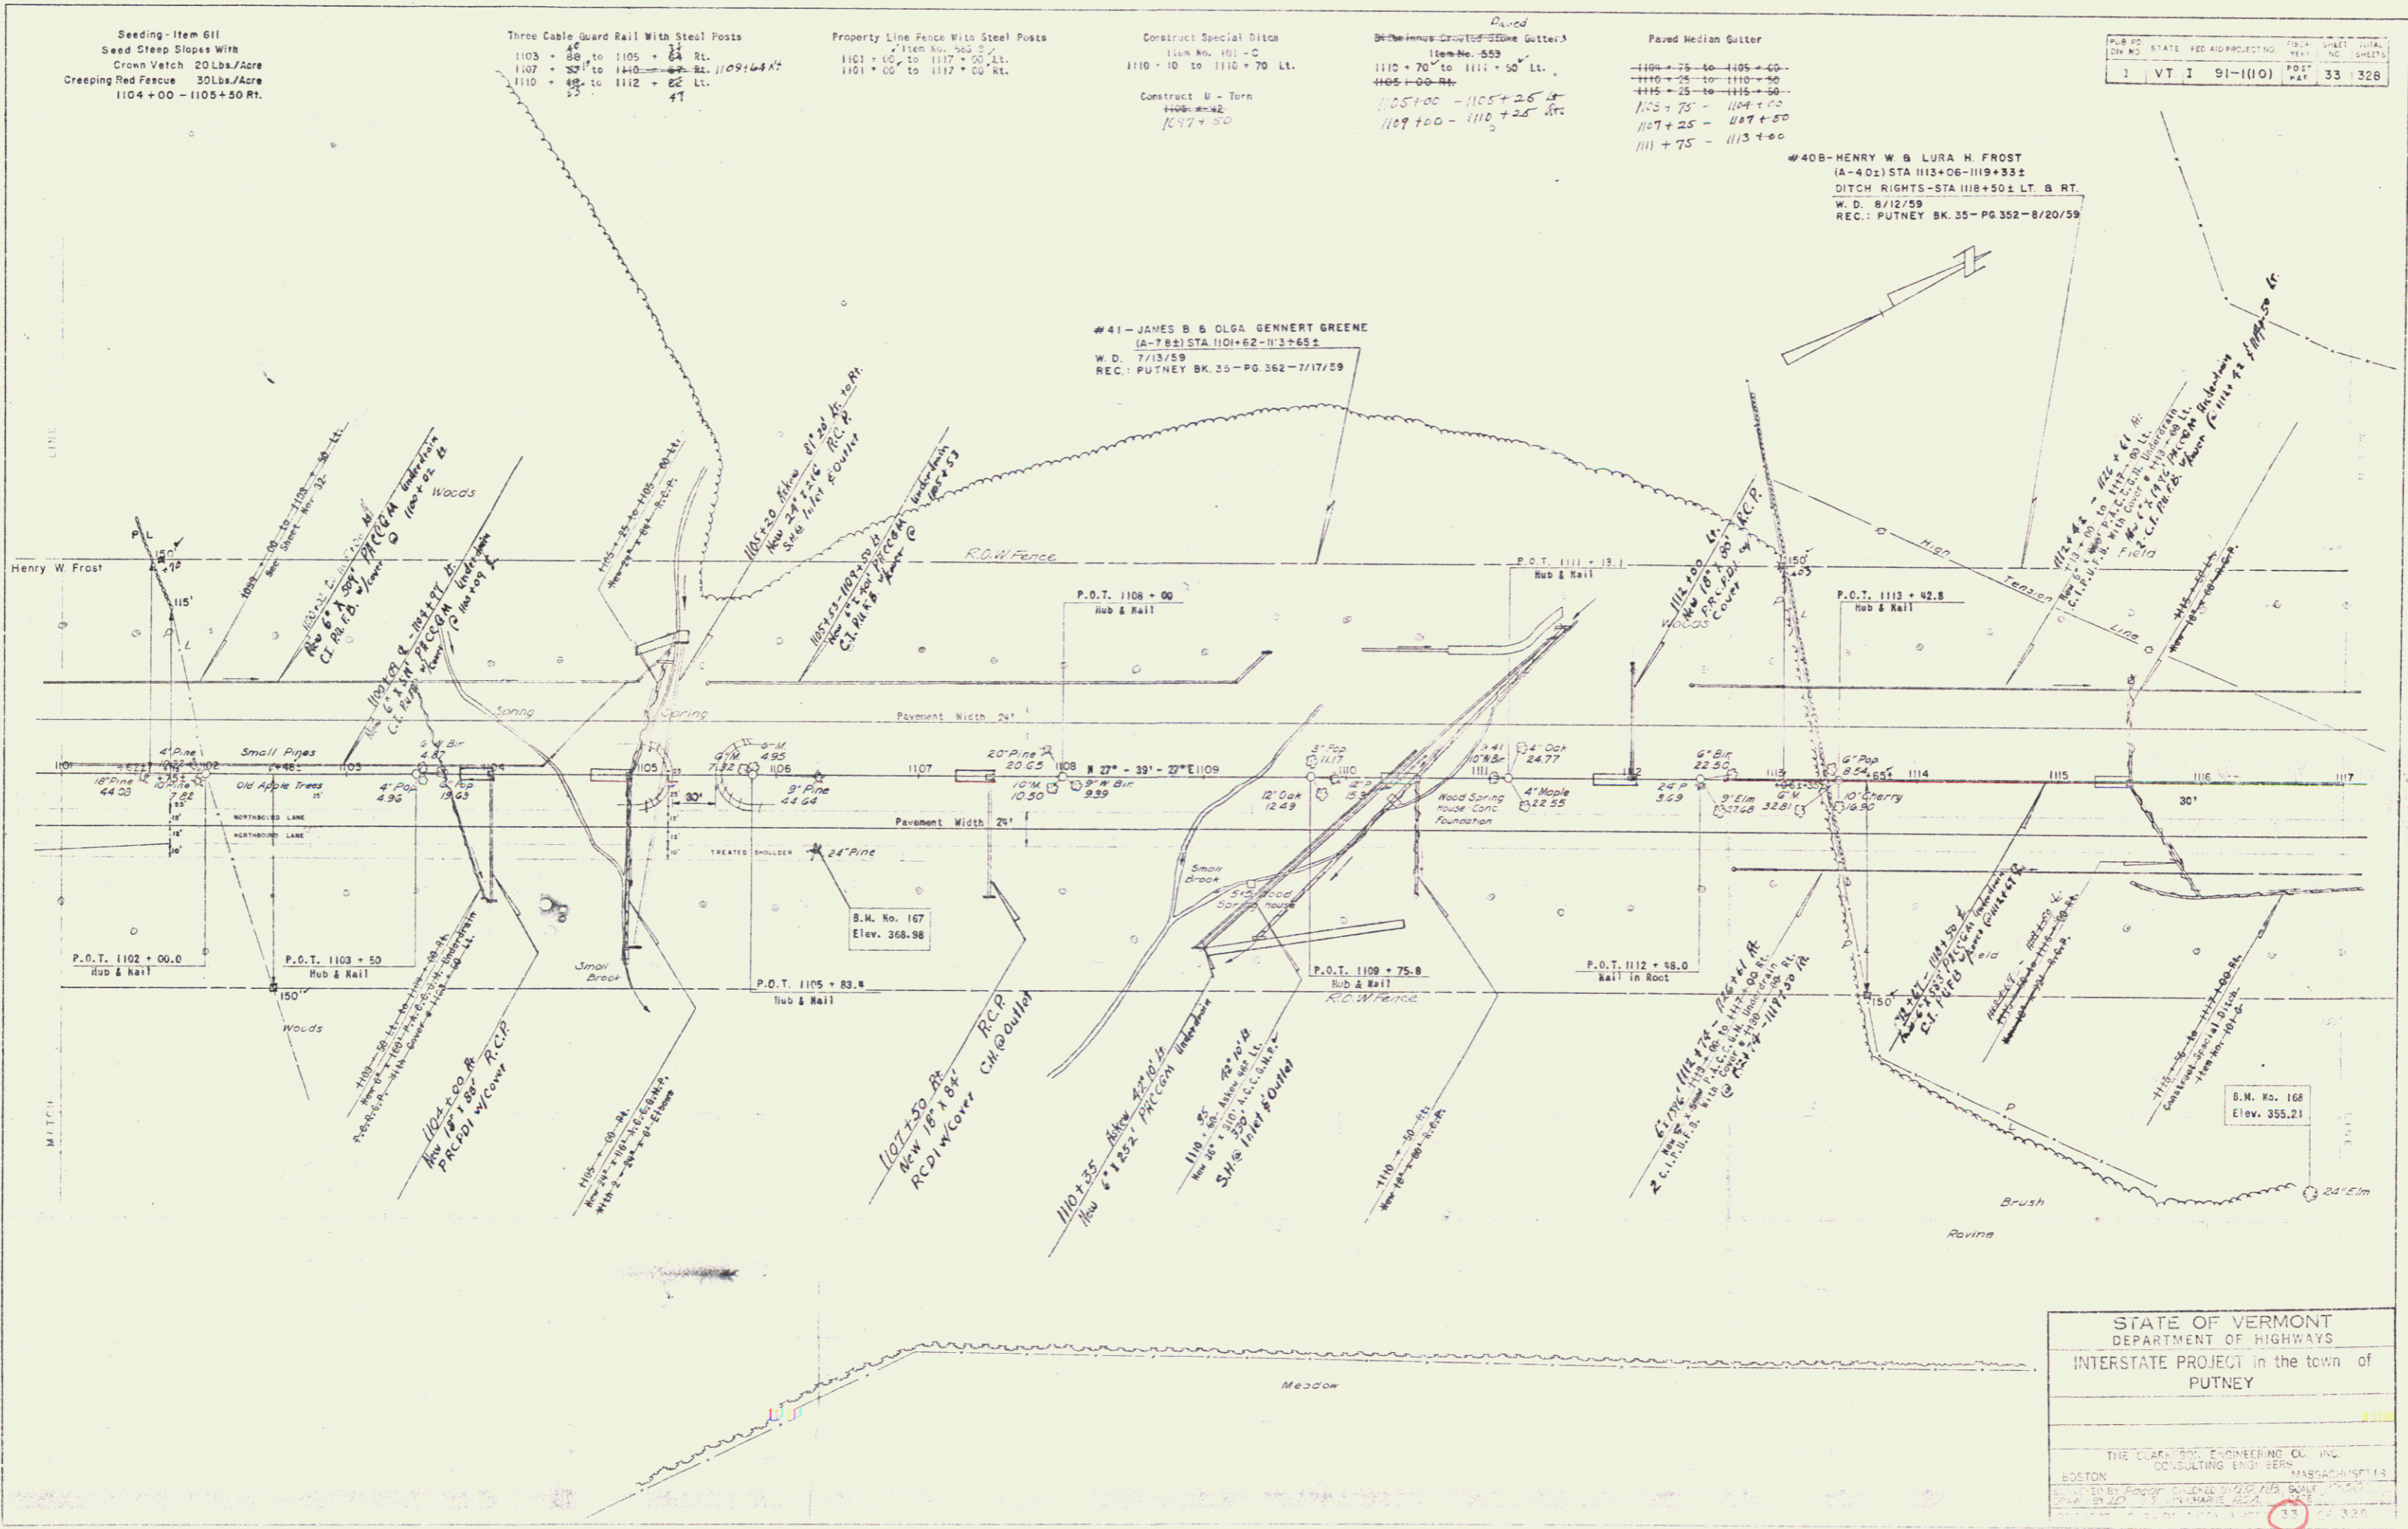

STATE OF VERMONT
DEPARTMENT OF HIGHWAYS
INTERSTATE PROJECT in the town of
PUTNEY

THE CLARK AND ENGINEERING CO. INC.
CONSULTING ENGINEERS
BOSTON

SCALE: AS SHOWN
DATE: 11/15/59
DRAWN BY: [Signature]
CHECKED BY: [Signature]
APPROVED BY: [Signature]

33