

Bituminous Gravel
Stone Battery
12.5' x 10' x 12'

Form No. 100
1162 + 00 to 1162 + 25

1167 + 00 to 1167 + 25
1168 + 00 to 1168 + 25


Note: For Summary Of Contract
Contract No. 3, See Sheet No. 4.

Gravel Stone
1163'00" - 1165'00"

VT. 1 91-1110

#45A DOUGLAS & MADELINE B HARLOW
(S. 44) STA 1152+00-1159+00

#45-B MYRON A & NELLIE L KENERSON
(S. 44) STA 1162+00-1169+00

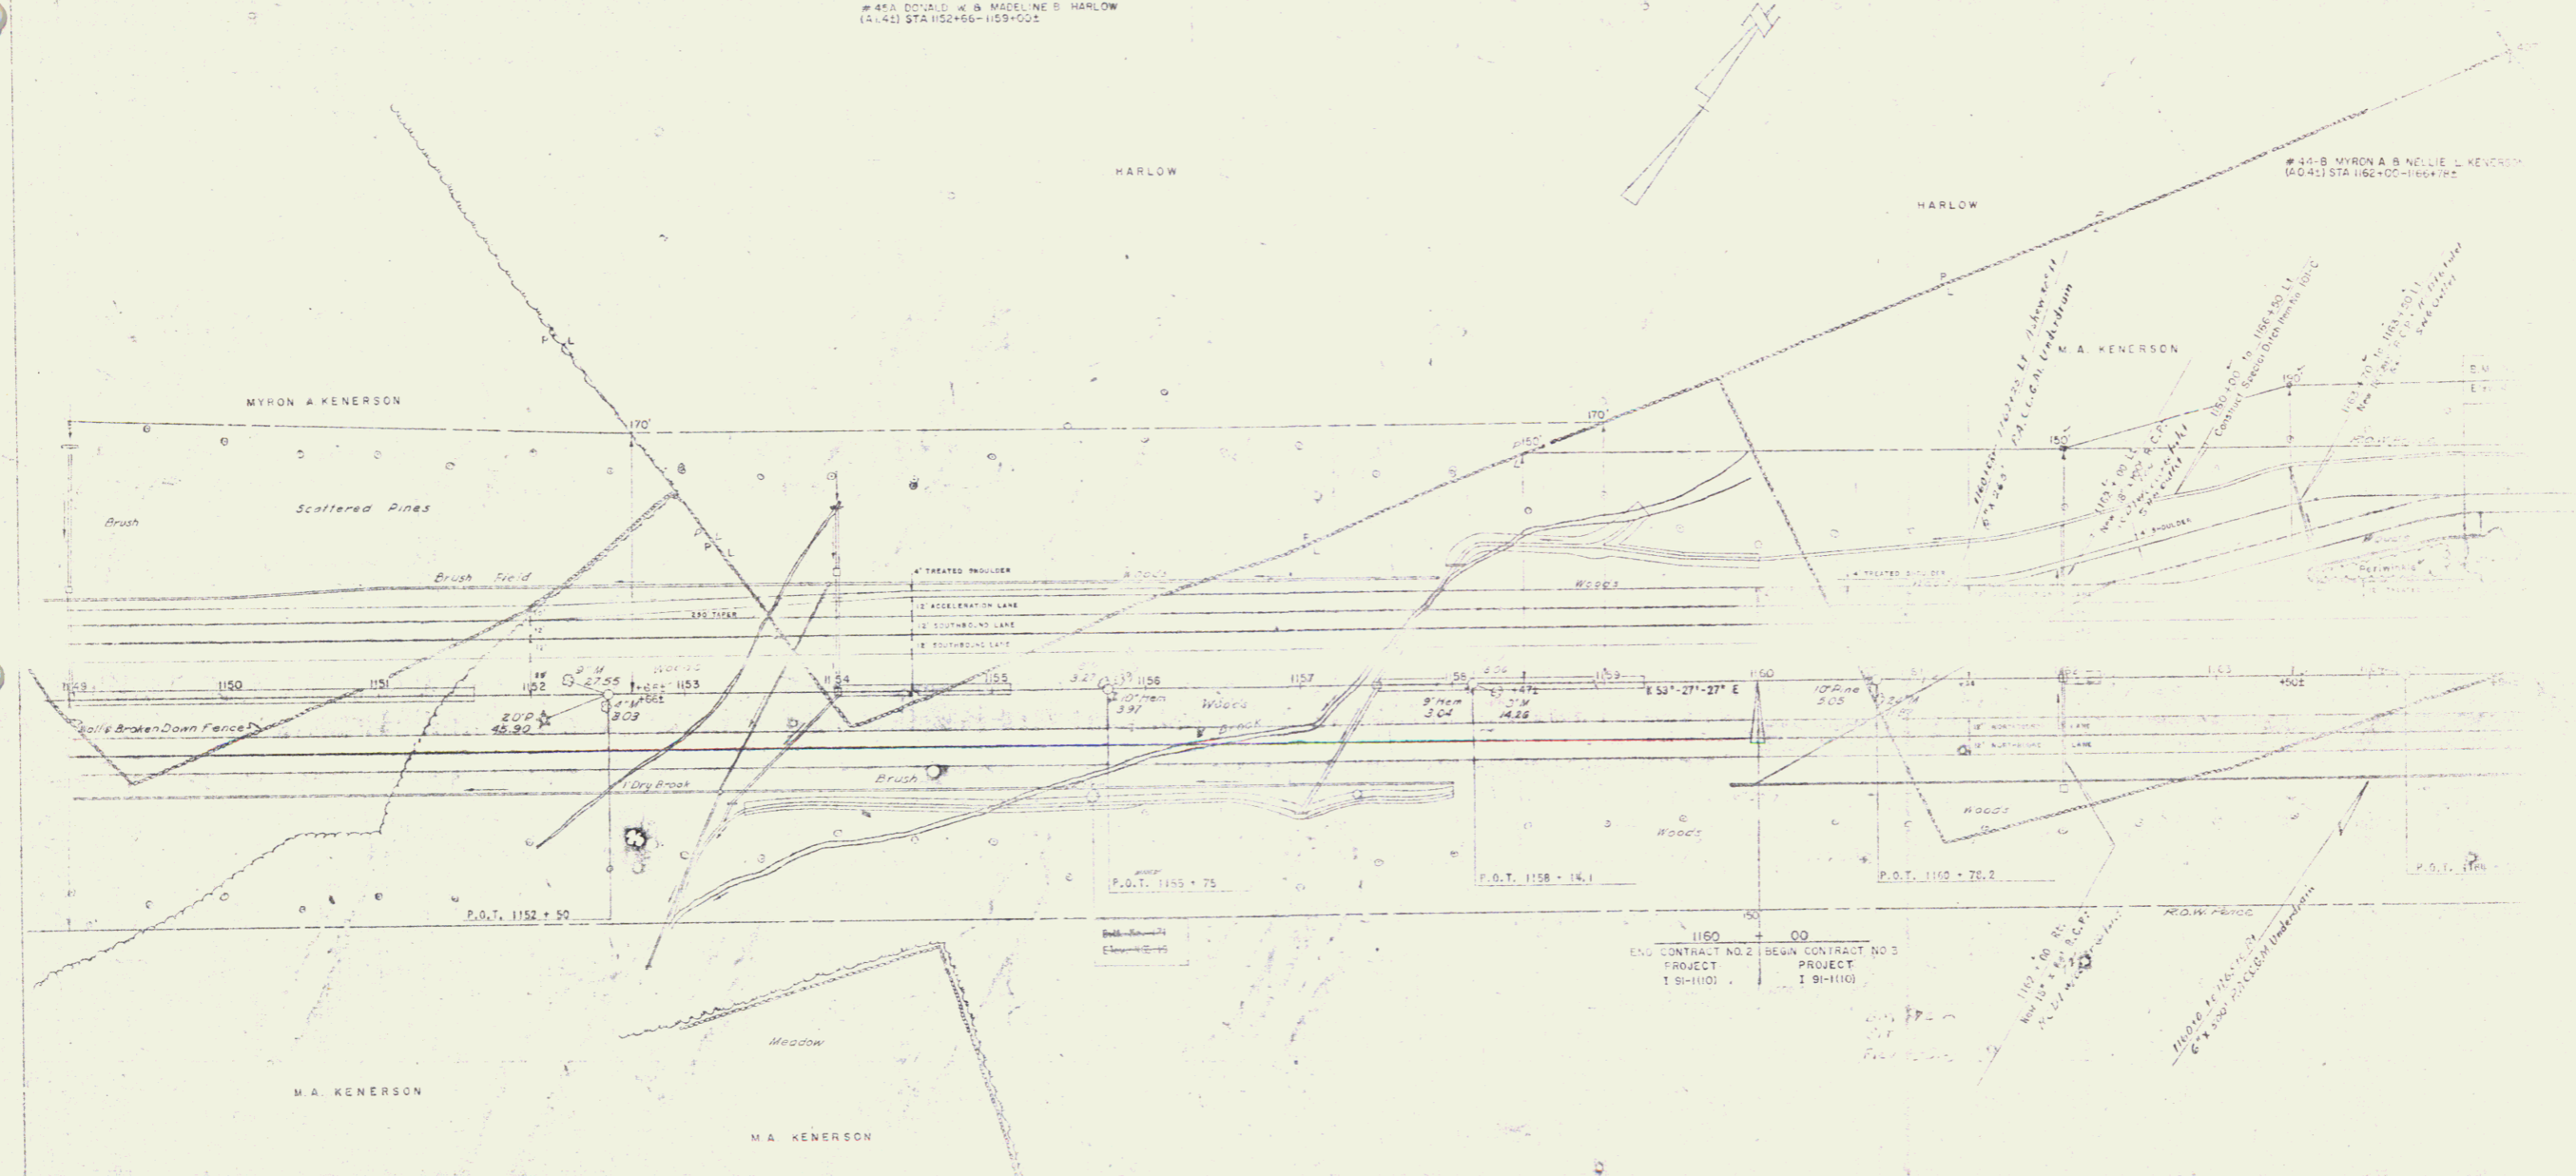

POOR ORIGINAL COPY

STATE OF VERMONT
DEPARTMENT OF HIGHWAYS
INTERSTATE PROJECTS
DUTY

43

16