

Paved Median gutter

1166 + 00 to 1166 + 25  
1171 + 00 to 1171 + 25  
1176 + 00 to 1177 + 50  
1180 + 50 to 1181 + 00

#45B DONALD W. & MADELINE B. HARLOW  
(43700 SQ FT.) STA 1166+43-1168+00  
W.D. 10/28/59  
REC.: PUTNEY BK. 35 - PG. 447 - 10/31/59

Property Line Fence With Steel Posts

Item No. 582 B  
1165 + 00 to 1181 + 00 Lt.  
1165 + 00 to 1181 + 00 Rt.

Bituminous Grouted Stone Curbs

1180 + 30 Rt.  
1172 + 50 + Rt.  
1174 + 00 Lt.

Three Chain Guard Rail With Steel Posts

1167 + 00 to 1181 + 35 Lt.  
1169 + 00 to 1172 + 00 Lt.  
05

Granite Slope Edging

1165 + 00 to 1169 + 43 Lt.  
(Weighing Station)

STATE OF VERMONT  
DEPARTMENT OF HIGHWAYS  
1 VT 1 91-11(10) POST  
W&M 44 328

Summary Landscape Material  
Contract No. 3


I. Trees  
A. Deciduous  
1. Betula Papyrifera - Paper Birch 3  
2. Castanea Crispagalli - Chestnut Southern 8

II. Vines  
1. Vinca Minor - Periwinkle 1,850

III. General Notes  
A. Size of Planting Material  
1. Evergreen trees should be 2-3 feet in height.  
2. Evergreen shrubs should be 12" in diameter (measurement is average spread of branches), 6-12" in height and 2 1/2" minimum caliper.  
3. Large deciduous trees should be 2 1/2" to 1 inch in caliper with a minimum height of 6 to 8 feet.  
4. Small deciduous trees should be 1 1/8 inch in caliper, 5 to 6 feet in height with 6 or more branches.  
5. Deciduous shrubs should be 2 to 3 feet in height, with not less than 4 canes, 2 feet end up.  
6. All plant material to be grown according to American Standards for Nursery Stock.

CURVE DATA  
A = 56' - 35' - 30" Lt.  
B = 28'  
C = 2669.3'  
T = 3464.3'  
L = 2820.6'  
E = 188.5'  
Bank = 11/16" per foot

#46 C ELLWYN E. & BEVERLY H. MILLER  
(2600 SQ FT. ±) STA. 1166 + 89 - 1169 + 10 ±  
W.D. 2/19/60  
REC.: PUTNEY BK. 35 - PG. 222 - 7/10/59  
SPRING RIGHTS STA. 1177 + 00

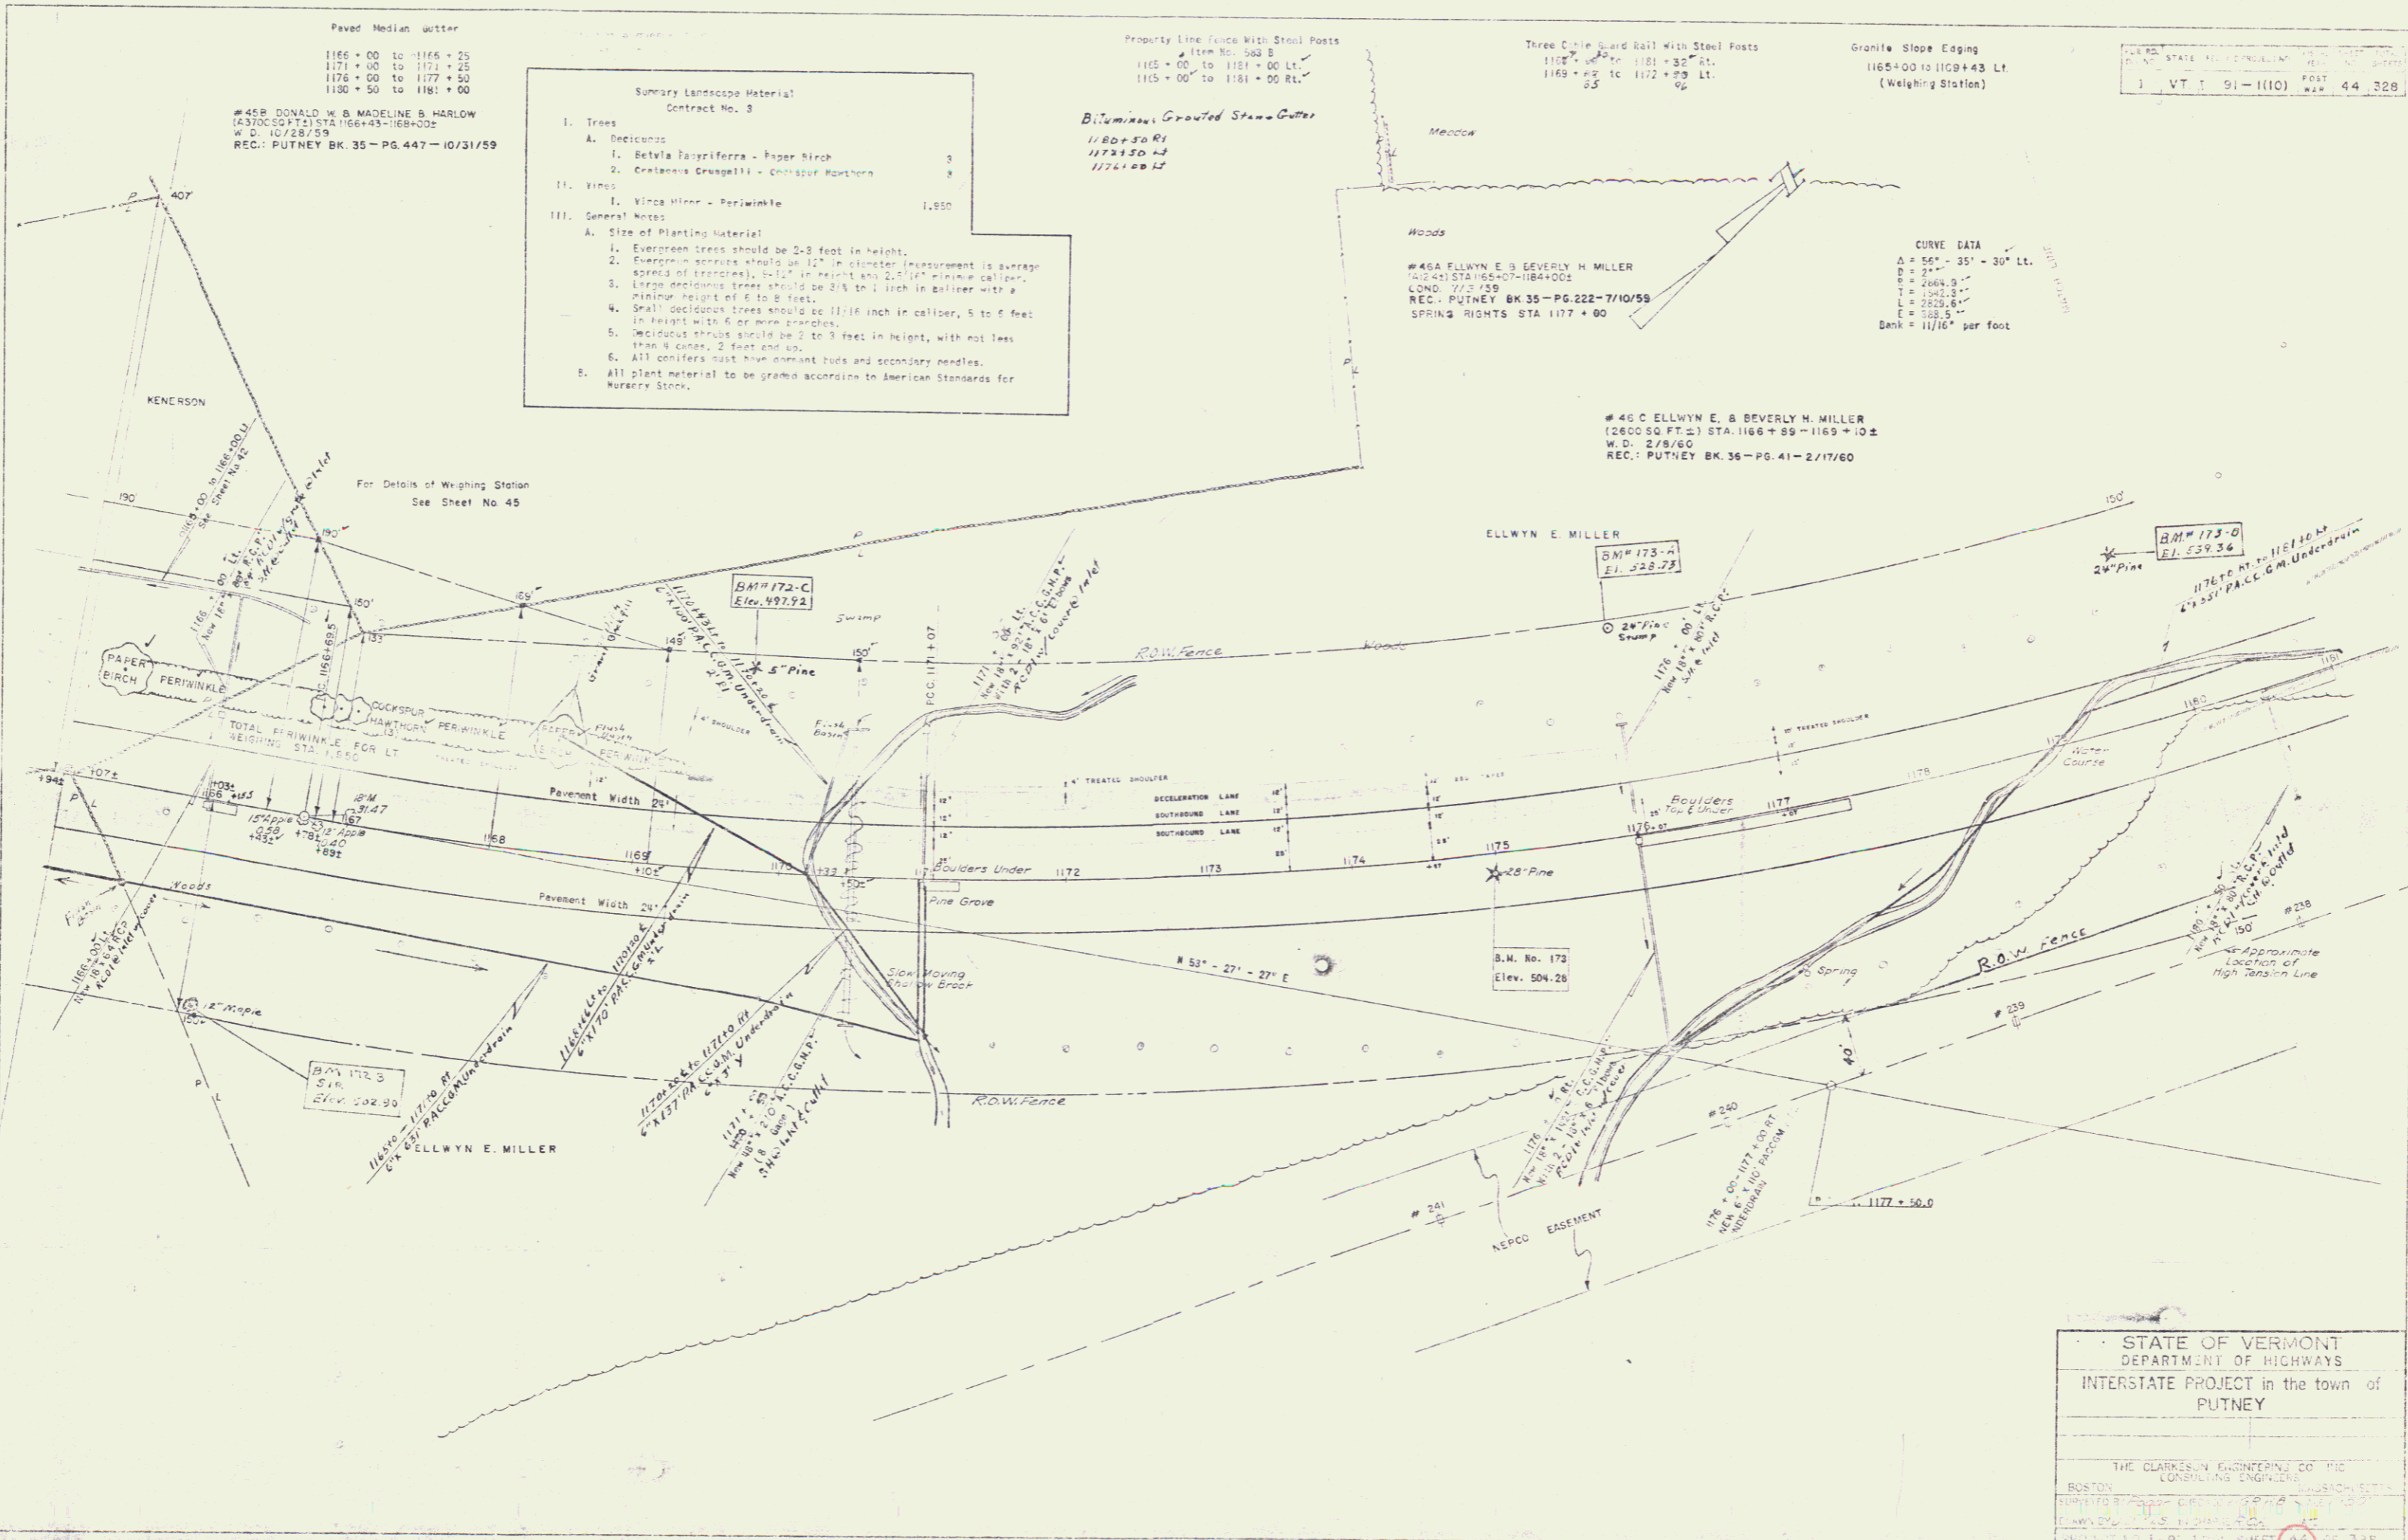

STATE OF VERMONT  
DEPARTMENT OF HIGHWAYS  
INTERSTATE PROJECT in the town of  
PUTNEY

THE CLARKE ENGINEERING CO. INC.  
CONSULTING ENGINEERS  
BOSTON

DESIGNED BY: [Signature]  
CHECKED BY: [Signature]  
DATE: [Date]  
SHEET NO. 43 OF 328  
CONTRACT NO. 3

1172.69

17