

Seeding - Item G11
Seed Steep Slopes With
Crown Vetch 20 Lbs./Acre
Creeping Red Fescue 30 Lbs./Acre
1104 + 00 - 1105 + 50 Rt.

Three Cable Guard Rail With Steel Posts
1103 + 86 to 1105 + 84 Rt.
1107 + 37 to 1110 + 22 Lt.
1110 + 55 to 1112 + 22 Lt.
1109:44X4
47

Property Line Fence With Steel Posts
Item No. 563 S
1101 + 00 to 1117 + 00 Lt.
1101 + 00 to 1117 + 00 Rt.

Construct Special Ditch
Item No. 401 - C
1110 + 10 to 1110 + 70 Lt.
Construct U - Turn
Hub & Nail
1049 + 50


Paved
Bermains-Crowned-Edge Gutters
Item No. 553
1110 + 70 to 1111 + 50 Lt.
1105 + 00 Rt.
1105 + 00 - 1105 + 25 Lt.
1109 + 00 - 1110 + 25 Rt.

Paved Median Gutter
1104 + 75 to 1105 + 60
1110 + 25 to 1110 + 50
1115 + 25 to 1115 + 50
1105 + 75 - 1104 + 00
1107 + 25 - 1107 + 50
1111 + 75 - 1113 + 60

PUB. NO.	STATE	FED. AID PROJECT NO.	YEAR	SHEET NO.	TOTAL SHEETS
1	VT	I 91-1(10)	POST	33	328

#40B-HENRY W & LURA H. FROST
(A-40z) STA 1113+06-1119+33±
DITCH RIGHTS-STA 1118+50± LT. & RT.
W. D. 8/12/59
REC.: PUTNEY BK. 35-PG. 352-8/20/59

#41-JAMES B & OLGA GENNERT GREENE
(A-78z) STA 1101+62-1113+65±
W. D. 7/13/59
REC.: PUTNEY BK. 35-PG. 362-7/17/59

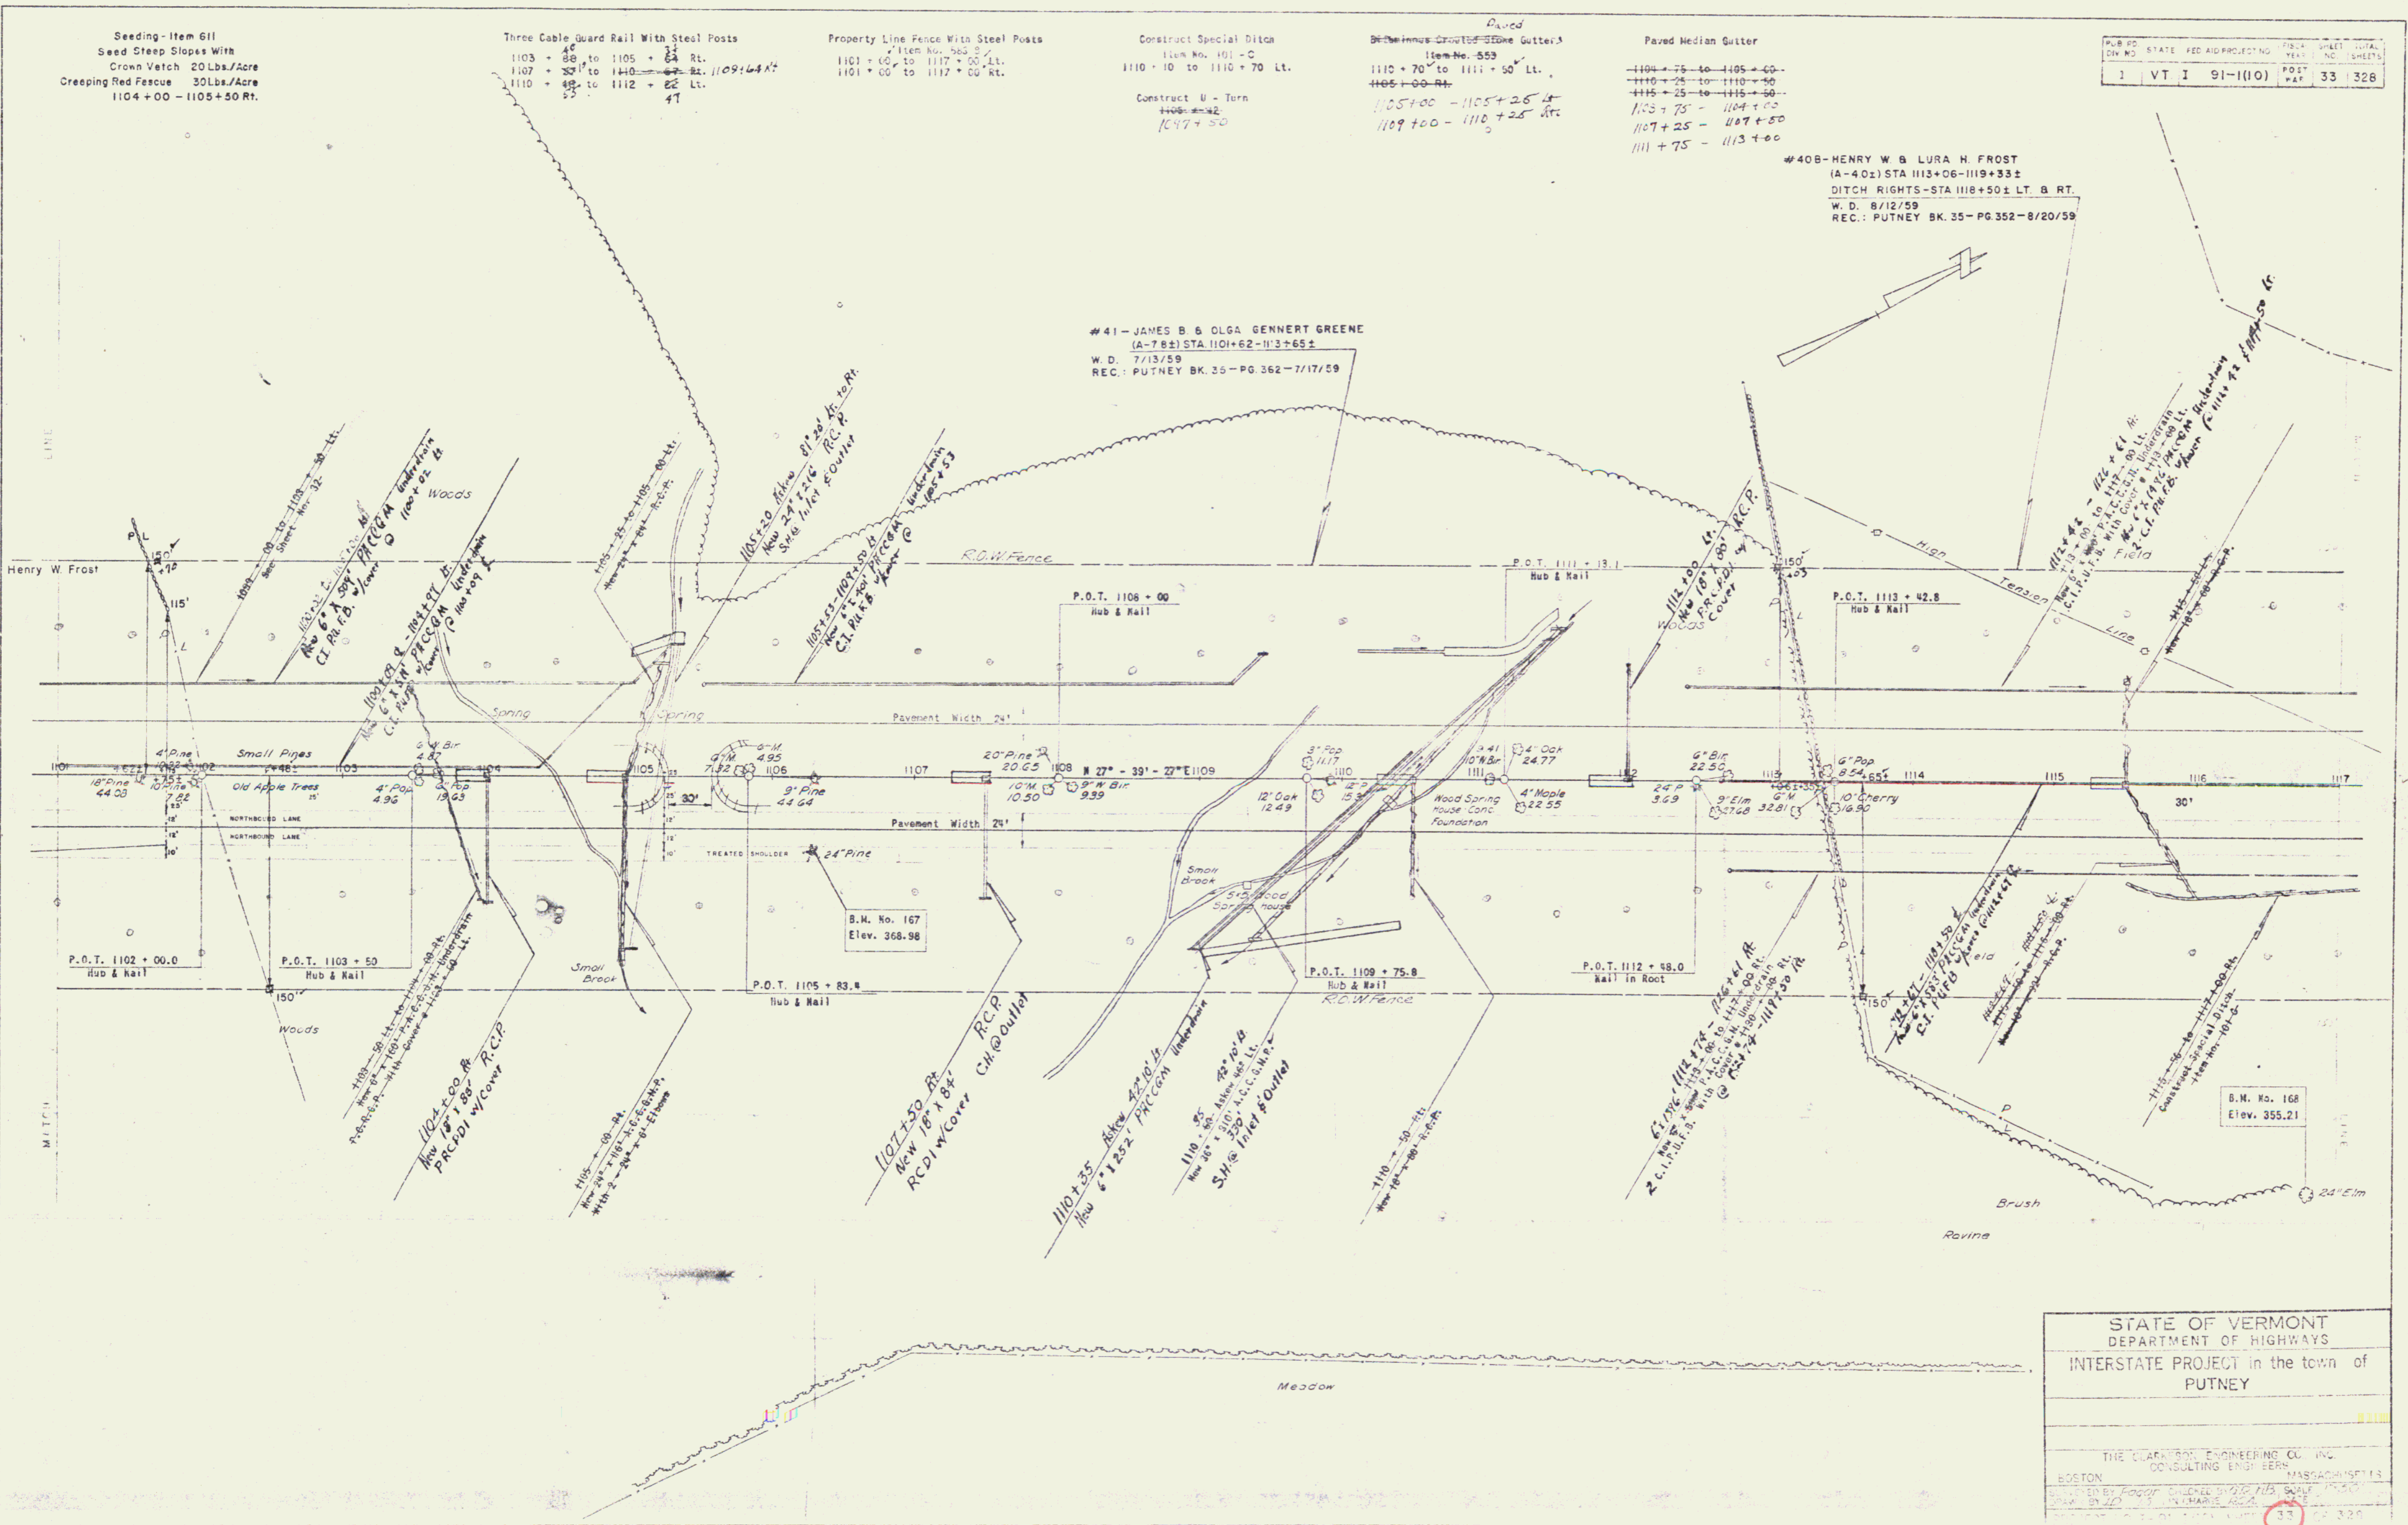

STATE OF VERMONT
DEPARTMENT OF HIGHWAYS
INTERSTATE PROJECT in the town of
PUTNEY

THE CLARISON ENGINEERING CO. INC.
CONSULTING ENGINEERS
BOSTON MASSACHUSETTS

DESIGNED BY: [Signature] CHECKED BY: [Signature] SCALE: [Blank]
DRAWN BY: [Signature] DATE: [Blank]

33