

Removal and Disposal of Two Cable Guard Rail
 Item No. 549-A
 10 + 00 to 11 + 75 Rt.
 16 + 50 to 11 + 20 Rt.

Plank Guard Rail with
 Preservative Treatment
 10 + 00 Rt. 16'

Construct Approach
 8 + 75 Rt.

Two Cable Guard Rail with Wood Posts
 9 + 55 to 17 + 00 Lt.
 9 + 80 to 15 + 75 Rt.

Construct Special Ditch Item 101-A
 15 + 25 to 17 + 50


Channel Excavation of Earth
 Item 106-A
 12 + 75 to 16 + 25 Rt. Chan. E

Stone Fill For Slope Protection
 Item 522
 16 + 25 to 18 + 00 Lt.

FOR NO.	STATE	FED. AID PROJECT NO.	FISCAL YEAR	SHEET NO.	TOTAL SHEETS
1	VT. I	91-1(10)	POST WAR	37	328

Summary - Landscape Material	
Contract No. 2	
I. Trees	
A. Deciduous	
1. Betula Papyrifera - Paper Birch	6
2. Crataegus Crusgalli - Cockspur Hawthorn	8
II. Vines	
1. Vinca Minor - Periwinkle	1,950
III. General Notes	
A. Size of Planting Material	
1. Evergreen trees should be 2-3 feet in height.	
2. Evergreen shrubs should be 12" in diameter (measurement is average spread of branches), 5-12" in height and 2.5/16" minimum caliber.	
3. Large deciduous trees should be 3/4 to 1 inch in caliber with a minimum height of 6 to 8 feet.	
4. Small deciduous trees should be 1 1/16 inch in caliber, 5 to 6 feet in height with 6 or more branches.	
5. Deciduous shrubs should be 2 to 3 feet in height, with not less than 4 canes, 2 feet and up.	
6. All conifers must have dormant buds and secondary needles.	
E. All plant material to be graded according to American Standards for Nursery Stock.	

#40C HENRY W & LURA H FROST
 (A321) STA 7+50-16+00 SIDELINE
 W.D. 8/12/59
 REC.: PUTNEY BK. 35-PG. 352-8/20/59

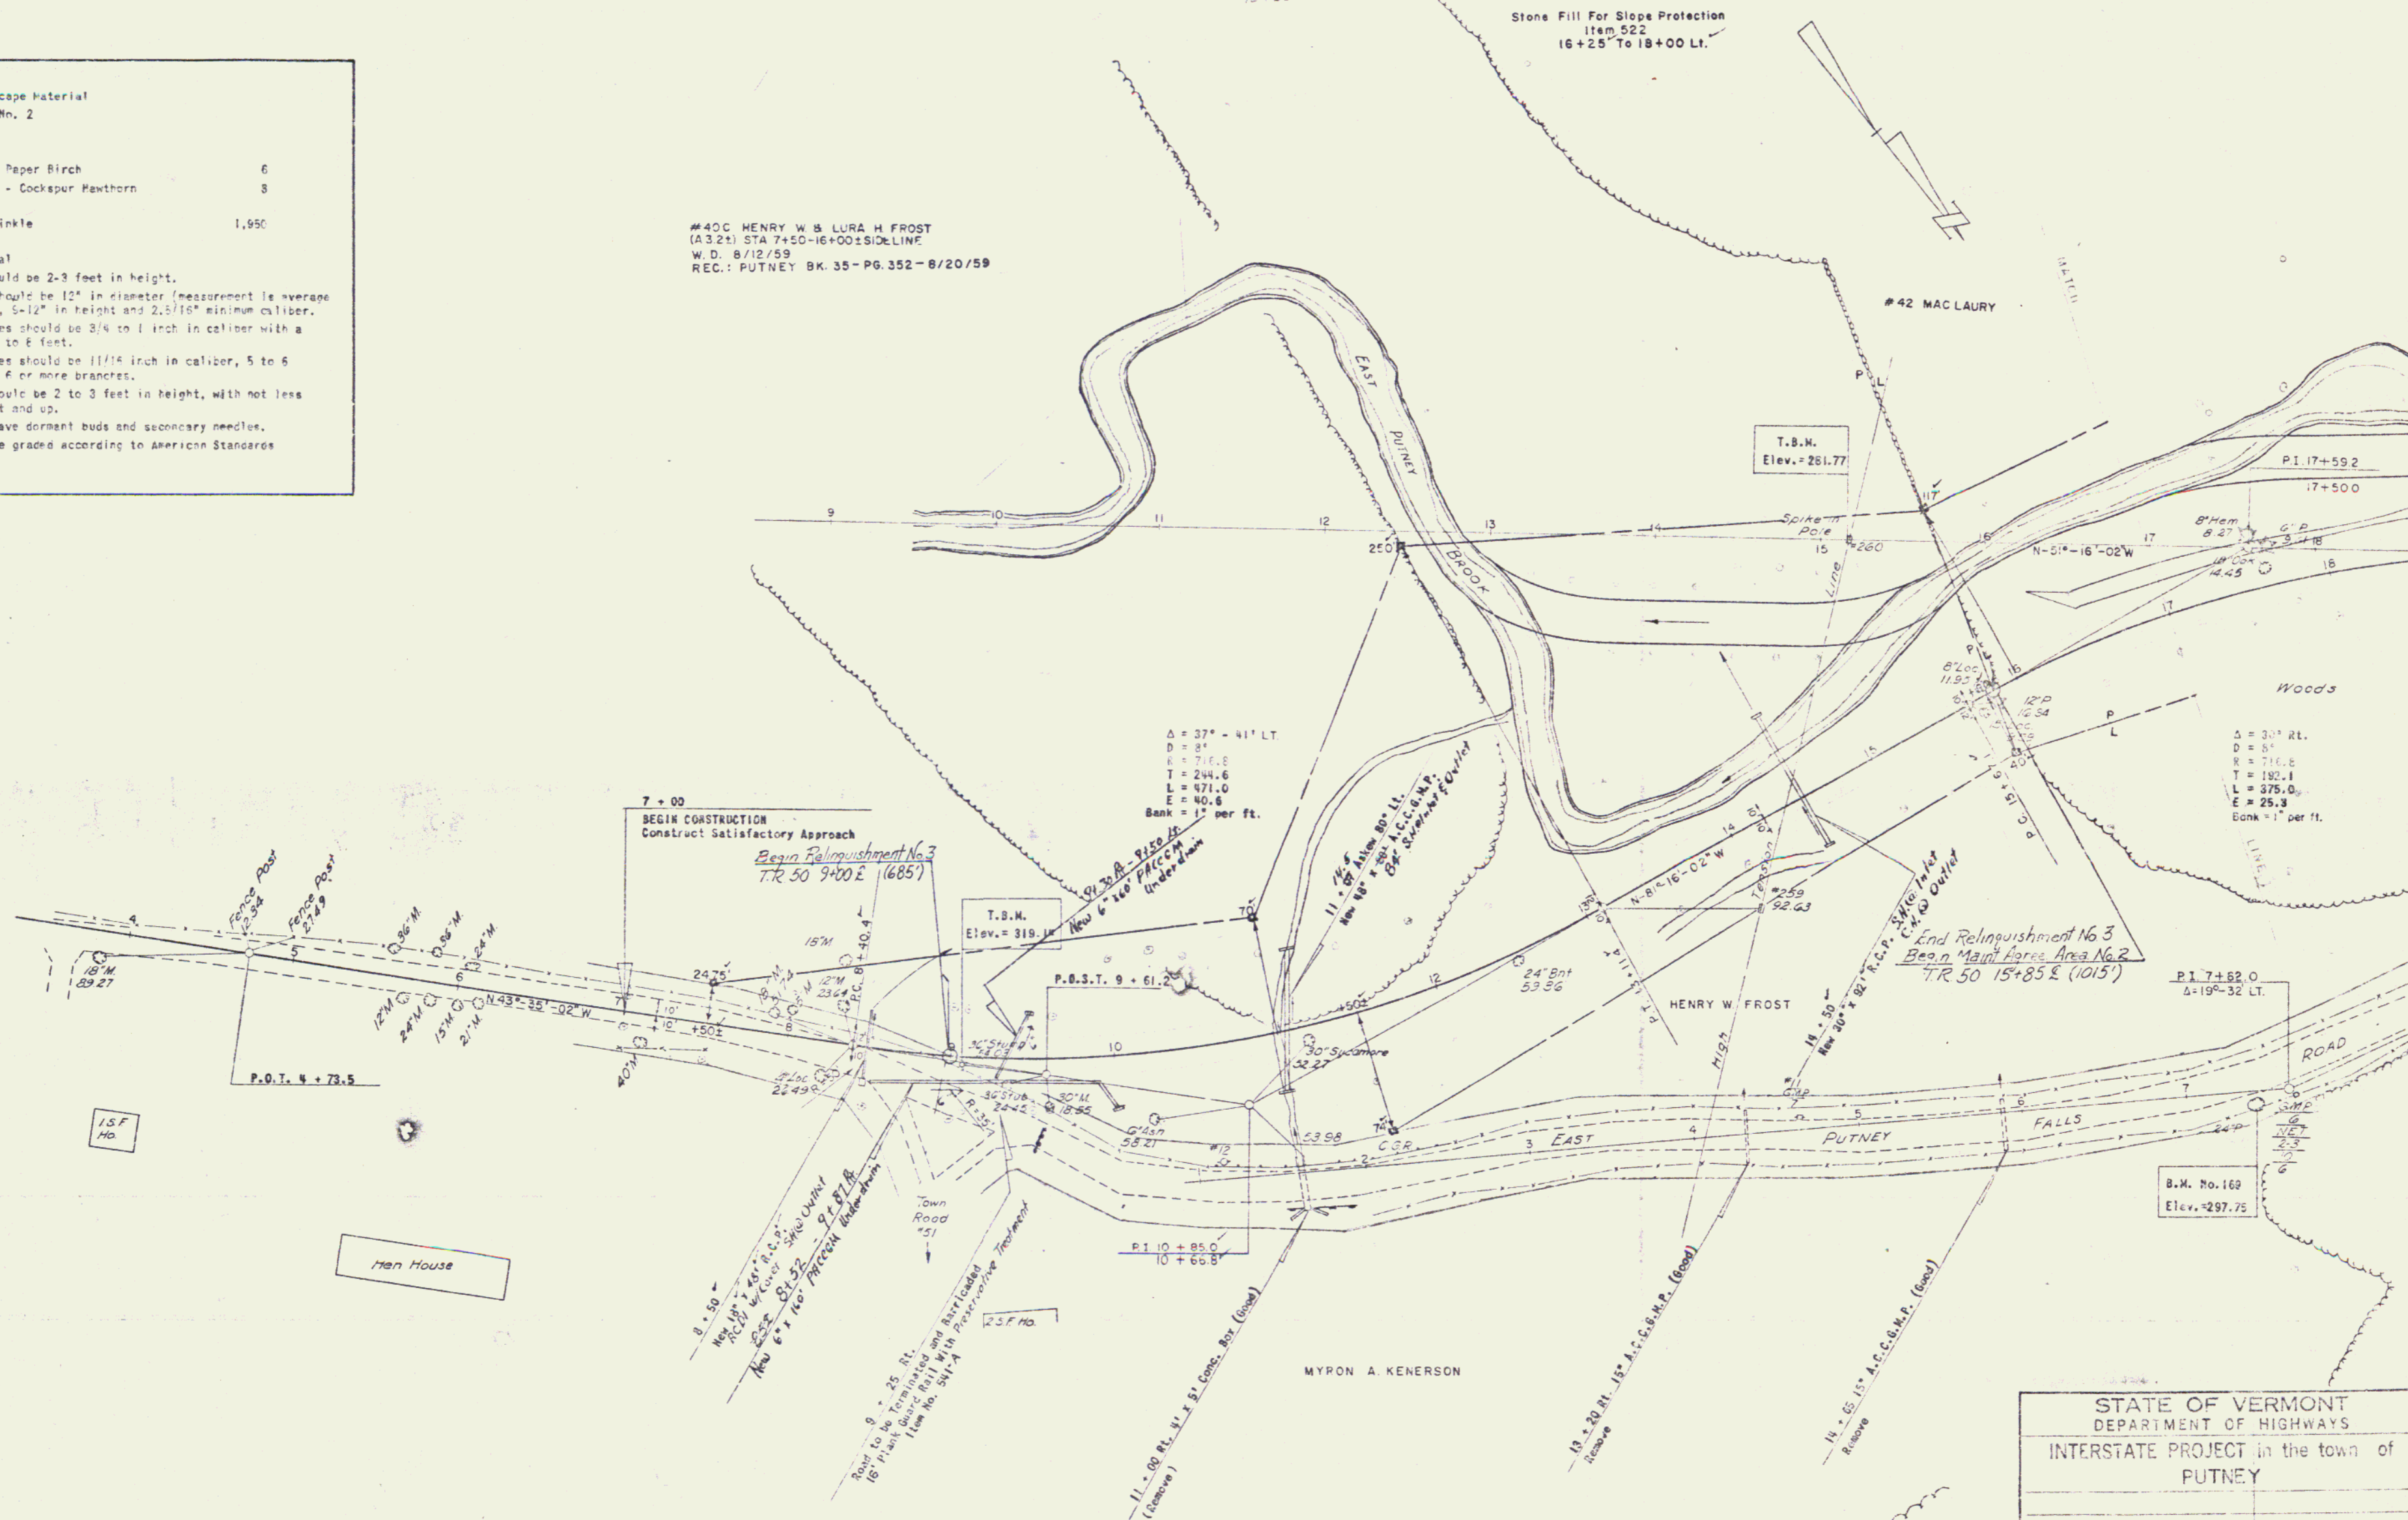

STATE OF VERMONT
 DEPARTMENT OF HIGHWAYS
 INTERSTATE PROJECT in the town of
 PUTNEY

THE CLARKSON ENGINEERING CO., INC.
 CONSULTING ENGINEERS
 115 MAIN STREET
 BRATTLEBORO, VERMONT

SCALE 1" = 40'
 PROJECT NO. I-91(10) SHEET 37 OF 328
 CONTRACT NO. 2