

PUB. RD. DIV. NO.	STATE	FED. AID PROJECT NO.	FISCAL YEAR	SHEET NO.	TOTAL SHEETS
1	VT	I 91-1(10)	POST WAR	49	328

DEMOLITION AND REMOVAL OF BUILDING
 ITEM 586
 1212 + 40 LT. 1213 + 40 LT.
 1212 + 65 LT. 1214 + 00 RT.
 1213 + 25 LT. 1214 + 80 LT.
 NOTE: OWNER TO VACATE ON OR BEFORE NOV. 1, 1969. (STA. 1211 + 11 - 1216 + 22)

Paved Median gutter
 1210 + 00 to 1210 + 25
 Construct Special Ditch
 Item No. 103 A
 U.S. Route #5 (Reloc.) 223 + 50 to 225 + 00 Rt.
 Town Road #25 3 + 00 to 4 + 00 Lt.

Removal and Disposal of Present Guard Rail
 Item No. 550
 U.S. Route #5 (Reloc.) 225 + 57 to 227 + 20 Lt.
 U.S. Route #5 (Reloc.) 225 + 17 Lt. to 226 + 57 Rt.


Property Line Fence With Steel Posts
 Item 583 B
 1210 + 00 to 1211 + 00 Lt.
 1210 + 00 to 1211 + 00 Rt.

Three Cable Guard Rail With Steel Posts
 U.S. Route #5 (Reloc.) 225 + 57 to 226 + 24 Rt.
 U.S. Route #5 (Reloc.) 225 + 57 to 226 + 24 Lt.
 225 + 57 to 226 + 24 Lt.
 225 + 57 to 226 + 24 Rt.

STATE OF VERMONT
 BY Q.C.D. REC. 10/7/81 IN BK 57 PG. 327-9
 OF PUTNEY LAND RECORDS
 NOTE: SEE SHEET # 49 FOR R.O.W. DEED DATA

Type of Inst. Agreement
 SA.3
 TR.50
 TR.25

Town Putney
 Date 8-14-74
 Book 51
 Page 31
 Date of Record 8-29-74

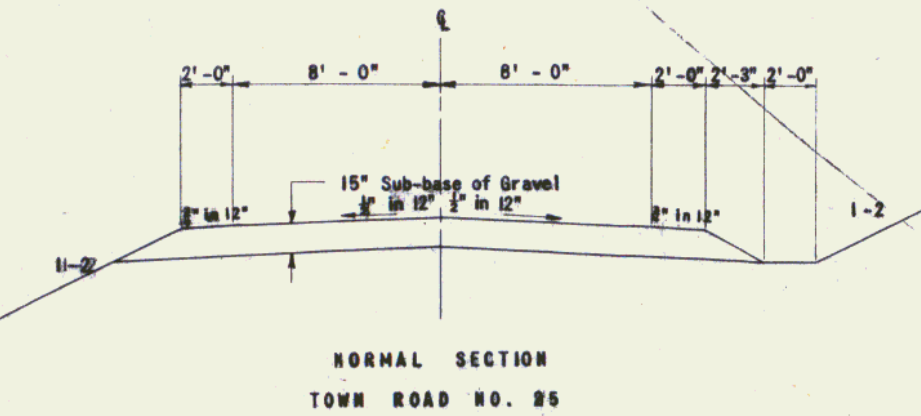

U.S. Rte. #5 Survey Curve Data
 $\Delta = 30^\circ - 09' \text{ Rt.}$
 $D = 8''$

Rev. U.S. Rte #5 Relocated
 $\Delta = 30^\circ - 09' \text{ Rt.}$
 $D = 7''$
 $R = 819.02'$
 $T = 220.61'$
 $L = 430.71'$
 $E = 29.19'$
 Bank = 15/16" per foot

SURPLUS PARCEL 65
 GRANTEE: PAULA J. BARTON
 CONVEYANCE: VT. Q.C. DEED
 DATE: MARCH 15, 1966
 AREA: 0.3 ACRE

STATE OF VERMONT
 DEPARTMENT OF HIGHWAYS
 INTERSTATE PROJECT in the town of
PUTNEY

THE CLARKESON ENGINEERING CO., INC.
 CONSULTING ENGINEERS
 BOSTON MASSACHUSETTS

SURVEYED BY Dagar CHECKED BY C.P. H.A. SCALE 1"=50'
 DRAWN BY J.D. J.S. IN CHARGE G.C.A. DATE
 PROJECT NO. I-91-1(10) SHEET 49A OF 328
 CONTRACT NO. 3.