


Paved Median Gutter
 Item No. 361 B
 1251+25 TO 1252+00
 1257+25 TO 1257+50
 1251+25 TO 1251+50

Three Cable Guard Rail With Steel Posts
 1242+00 to 1242+72 Lt.

Property Line Fence With Steel Posts
 Item No. 362 B
 1242+00 to 1258+00 Lt. (1600')
 1242+00 to 1258+00 Rt. (1600')

Construct U Turn
 1251+50 TO 1258+00
 CONSTRUCT SPECIAL DITCH
 ITEM 103-B

DIV. NO.	STATE	FED. AID PROJECT NO.	FISCAL YEAR	SHEET NO.	TOTAL SHEETS
1	VT.	I 91-1(11)		72	555

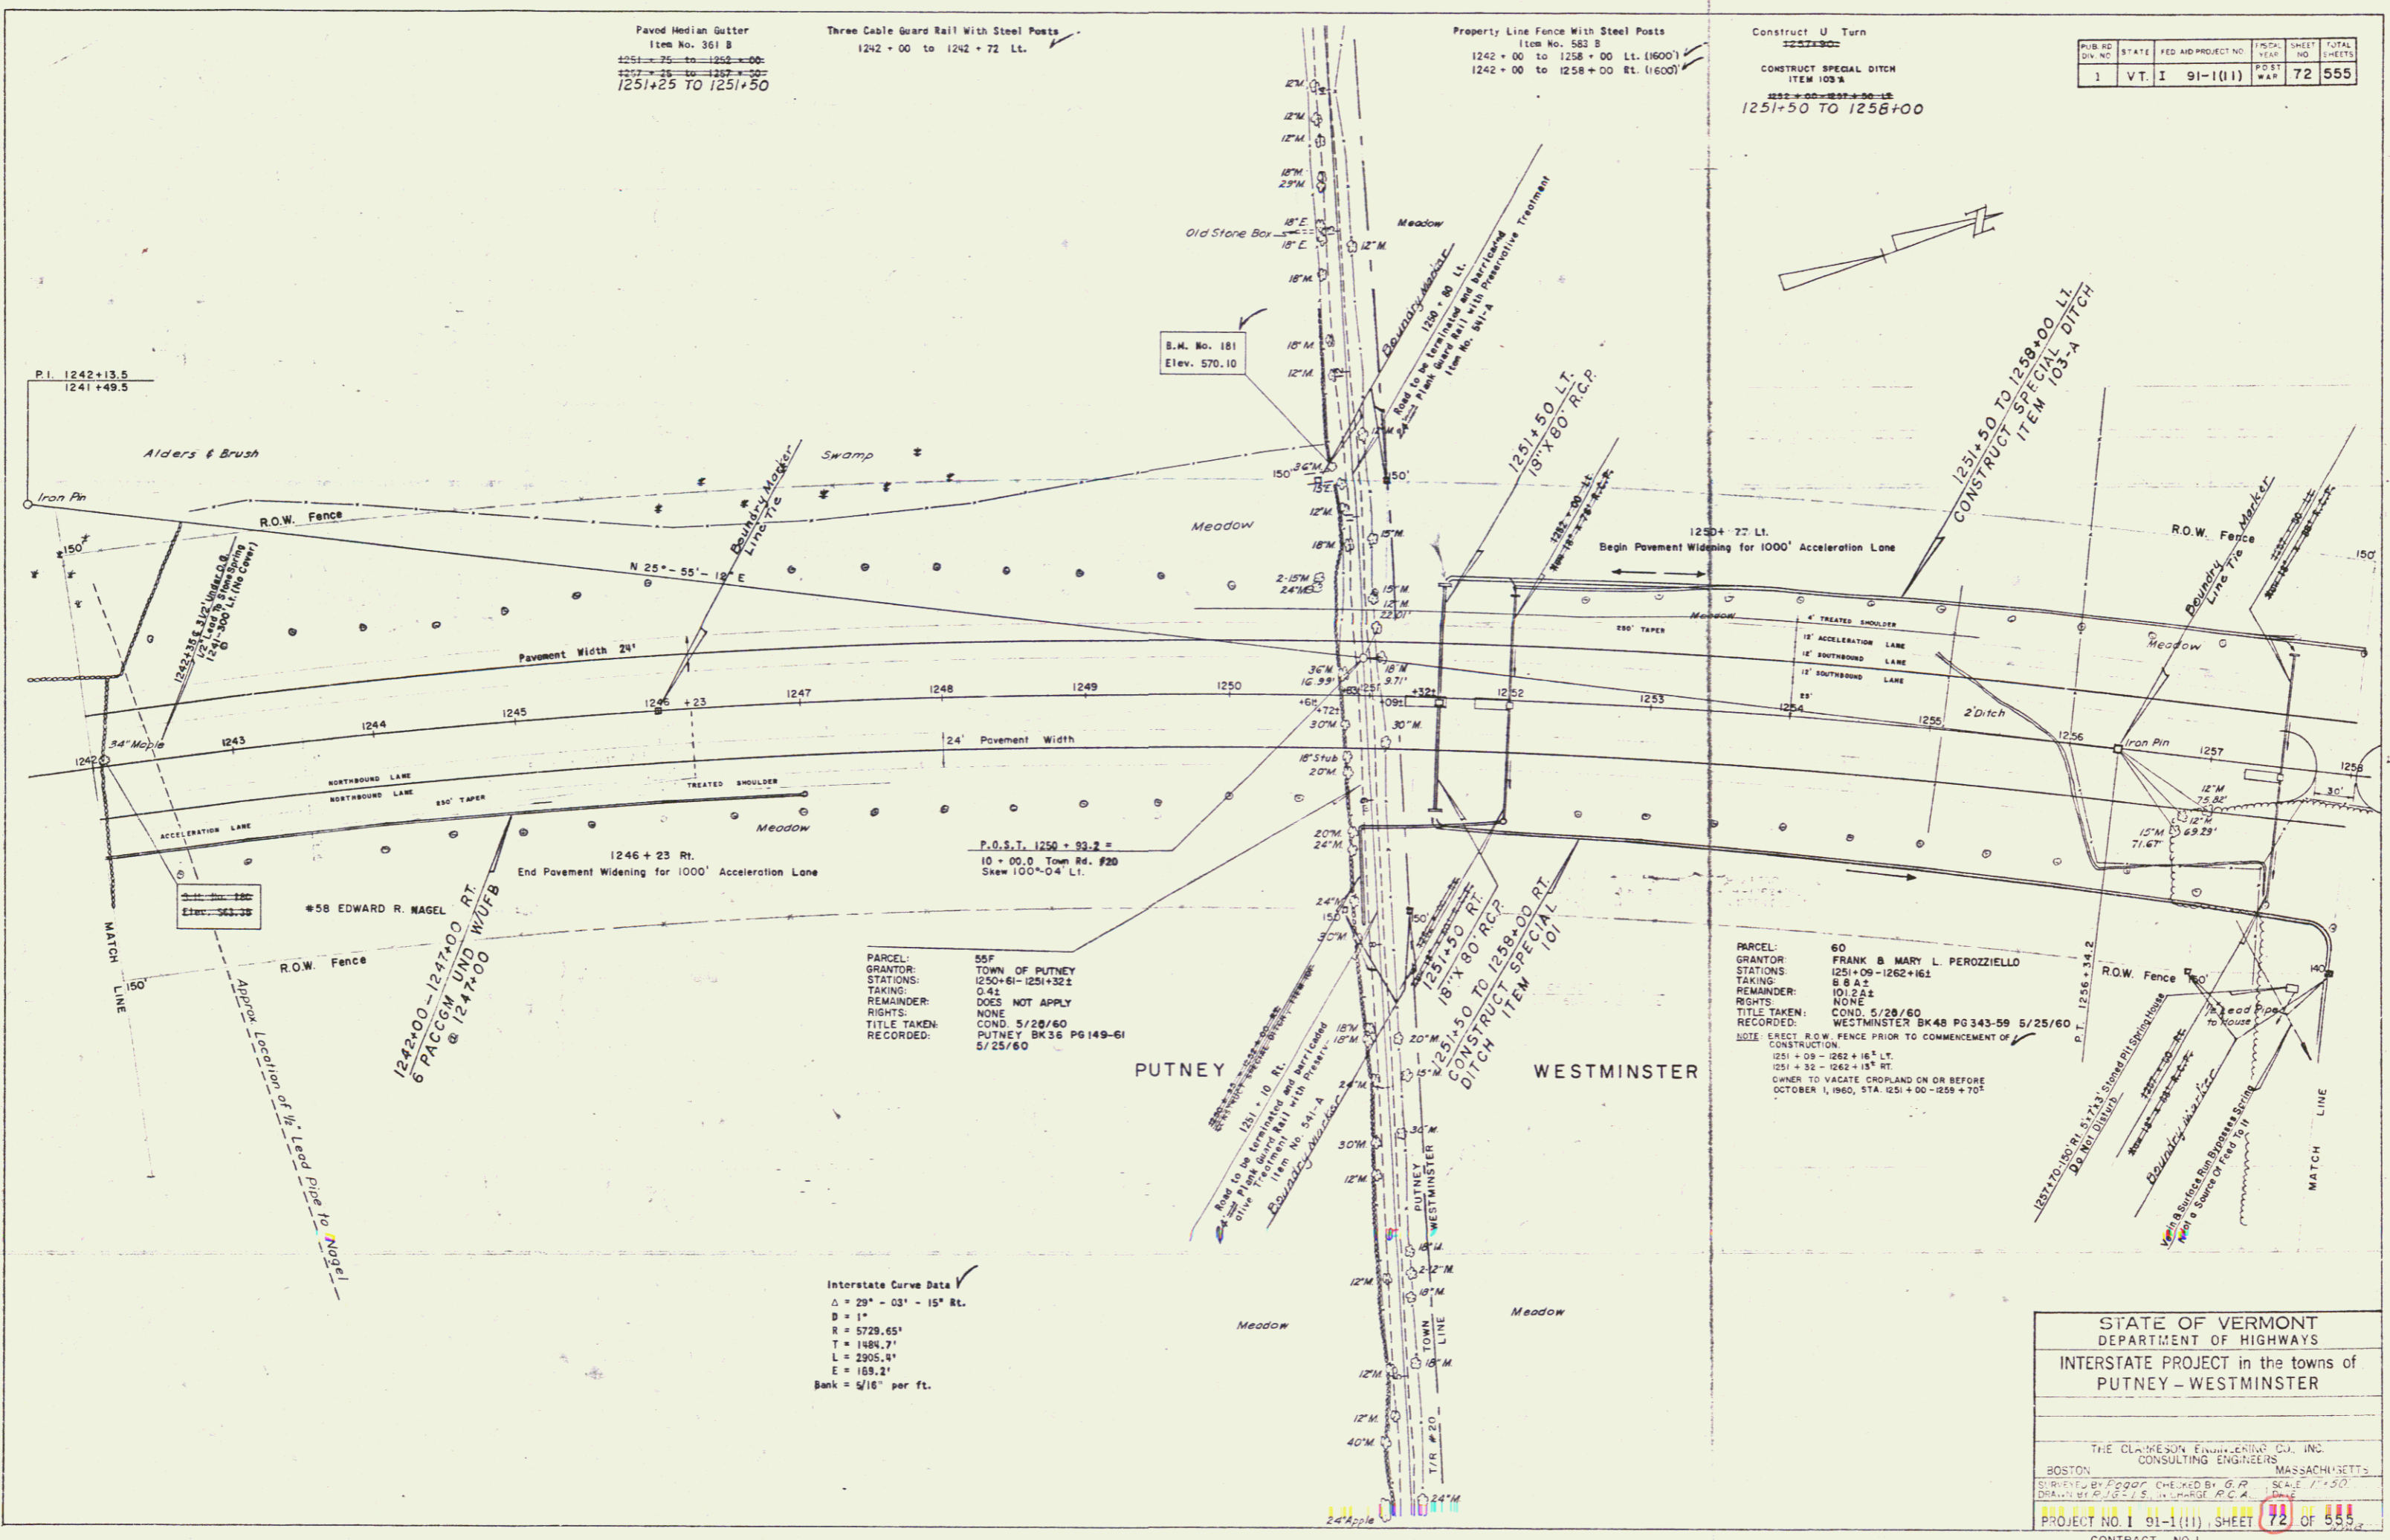

PARCEL: 55
 GRANTOR: TOWN OF PUTNEY
 STATIONS: 1250+61-1251+32
 TAKING: 0-41
 REMAINDER: DOES NOT APPLY
 RIGHTS: NONE
 TITLE TAKEN: COND. 5/28/60
 RECORDED: PUTNEY BK 36 PG 149-61
 5/25/60

PARCEL: 60
 GRANTOR: FRANK B. MARY L. PEROZZIELLO
 STATIONS: 1251+09-1262+161
 TAKING: 8-8-22
 REMAINDER: NONE
 RIGHTS: NONE
 TITLE TAKEN: COND. 5/29/60
 RECORDED: WESTMINSTER BK 48 PG 343-59 5/25/60
 NOTE: ERECT R.O.W. FENCE PRIOR TO COMMENCEMENT OF CONSTRUCTION
 1251+09 - 1262+161 LT.
 1251+32 - 1262+151 RT.
 OWNER TO VACATE CHOPLAND ON OR BEFORE OCTOBER 1, 1960, STA. 1251+00 - 1259+70'

Interstate Curve Data
 $\Delta = 29^\circ - 03' - 15''$ Rt.
 $D = 1'$
 $R = 5729.65'$
 $T = 1688.7'$
 $L = 2305.4'$
 $E = 169.2'$
 Bank = $5/16''$ per ft.

STATE OF VERMONT
 DEPARTMENT OF HIGHWAYS
 INTERSTATE PROJECT in the towns of
 PUTNEY - WESTMINSTER

THE CLAYTON ENGINEERING CO., INC.
 CONSULTING ENGINEERS
 BOSTON, MASSACHUSETTS

DESIGNED BY: P. J. EGGER CHECKED BY: G. P. [unclear] SCALE: 1" = 50'
 DRAWN BY: R. J. [unclear] DATE: [unclear]

PROJECT NO. 1 91-1(11) SHEET 72 OF 555
 CONTRACT NO. 1