


NOTE:
Thin out trees, clear brush, grade and seed area, Station 1259+70 to 1266+90 LT.
For Additional Detail on Safety Turnout See Sheets 79 & Roadway Standard Sheet B-17

| | | |
|---|--|---|
| <p>PARCEL: 61 GRANTOR: RUSSELL A. & HAZEL BRUYN STATIONS: 1266+70:2 RT TAKING: NONE REMAINDER: DOES NOT APPLY RIGHTS: NONE</p> <p>SPRING - STA 1266+70:2 RT TITLE TAKEN: W.D. 6/6/60 RECORDED: WESTMINSTER BK 20 PG 17 6/6/60</p> | <p>PARCEL: 54 GRANTOR: ERNEST R. & PHYLLIS B. NORMAN STATIONS: 1266+70:2 RT TAKING: NONE REMAINDER: DOES NOT APPLY RIGHTS: NONE</p> <p>SPRING - STA 1266+70:2 RT TITLE TAKEN: W.D. 6/6/60 RECORDED: WESTMINSTER BK 50 PG 19 6/6/60</p> | <p>PARCEL: 54 GRANTOR: CLIFFORD G. & MARGARET FOLKES STATIONS: 1269+28:1 LT TAKING: NONE REMAINDER: DOES NOT APPLY RIGHTS: NONE</p> <p>SPRING - STA 1269+28:1 LT TITLE TAKEN: COND. 5/28/60 WESTMINSTER BK 48 PG 34:3-58 5/28/60 RECORDED: WESTMINSTER BK 48 PG 34:3-58 5/28/60</p> |
|---|--|---|

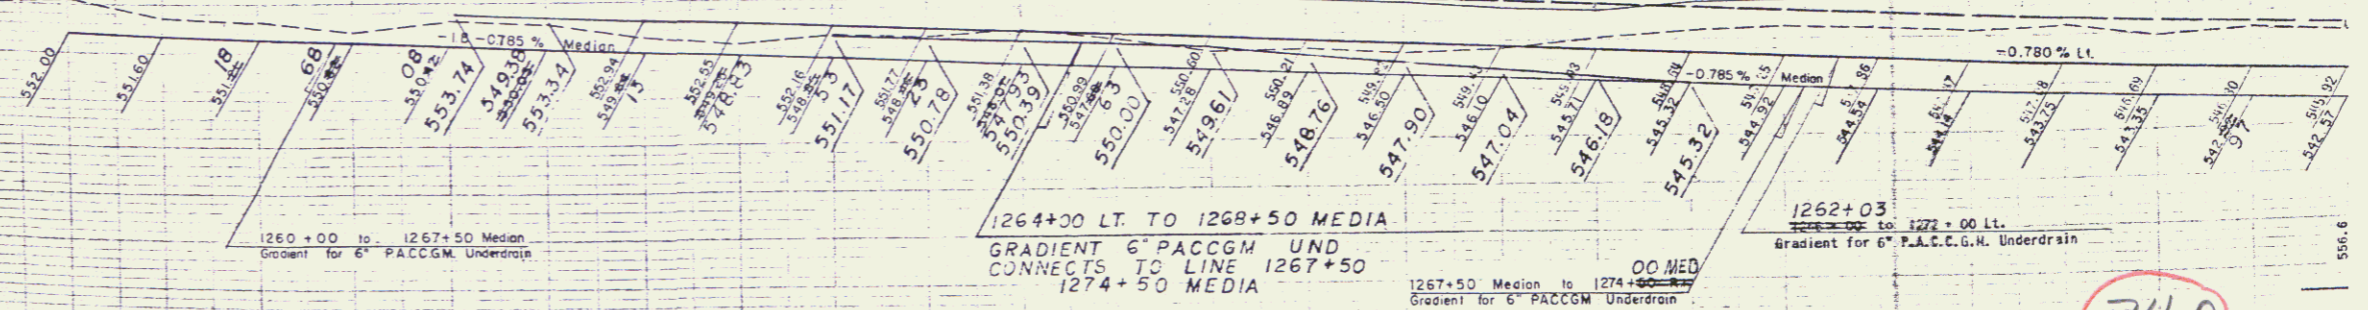

74A

5th. 6
5th. 9