

Bituminous Concrete Curb  
Item No. 555  
1331+50

Bituminous Grouted Stone Gutter  
Item No. 553  
1343+50 RL

Property Line Fence With Steel Posts  
Item No. 553-B  
1350+50 to 1353+25 LT (300')  
1358+00 to 1344+00 LT (1620')  
1344+00 to 1344+72 LT (135)  
1344+00 to 1340+90 RL (285)  
1341+0 to 1353+25 RL (1000)  
Channel Excavation of Earth Item 106-A  
Fullam Brook  
0+10 to 1+25  
5+75 to 6+25


Three Cable Guard Rail With Steel Posts  
Item No. 351-B  
1338+00 to 1348+00 Rt.  
1341+50 to 1348+70 Lt.  
1952+77 to 1953+26 Rt.

Paved Median Gutter  
Item No. 351-B  
1348+75 to 1343+00  
1348+25 to 1348+50

Sub-base of Sand  
Item 202  
1344+50 to 1352+50 Rt.  
1345+00 to 1353+00 Lt.

Gravel Backfill  
Item 222  
1345+50 to 1353+00 Lt.

PUR. NO.	STATE	FED. AID PROJECT NO.	FISCAL YEAR	SHEET NO.	TOTAL SHEETS
1	VT.	I-91-1(11)		84	555

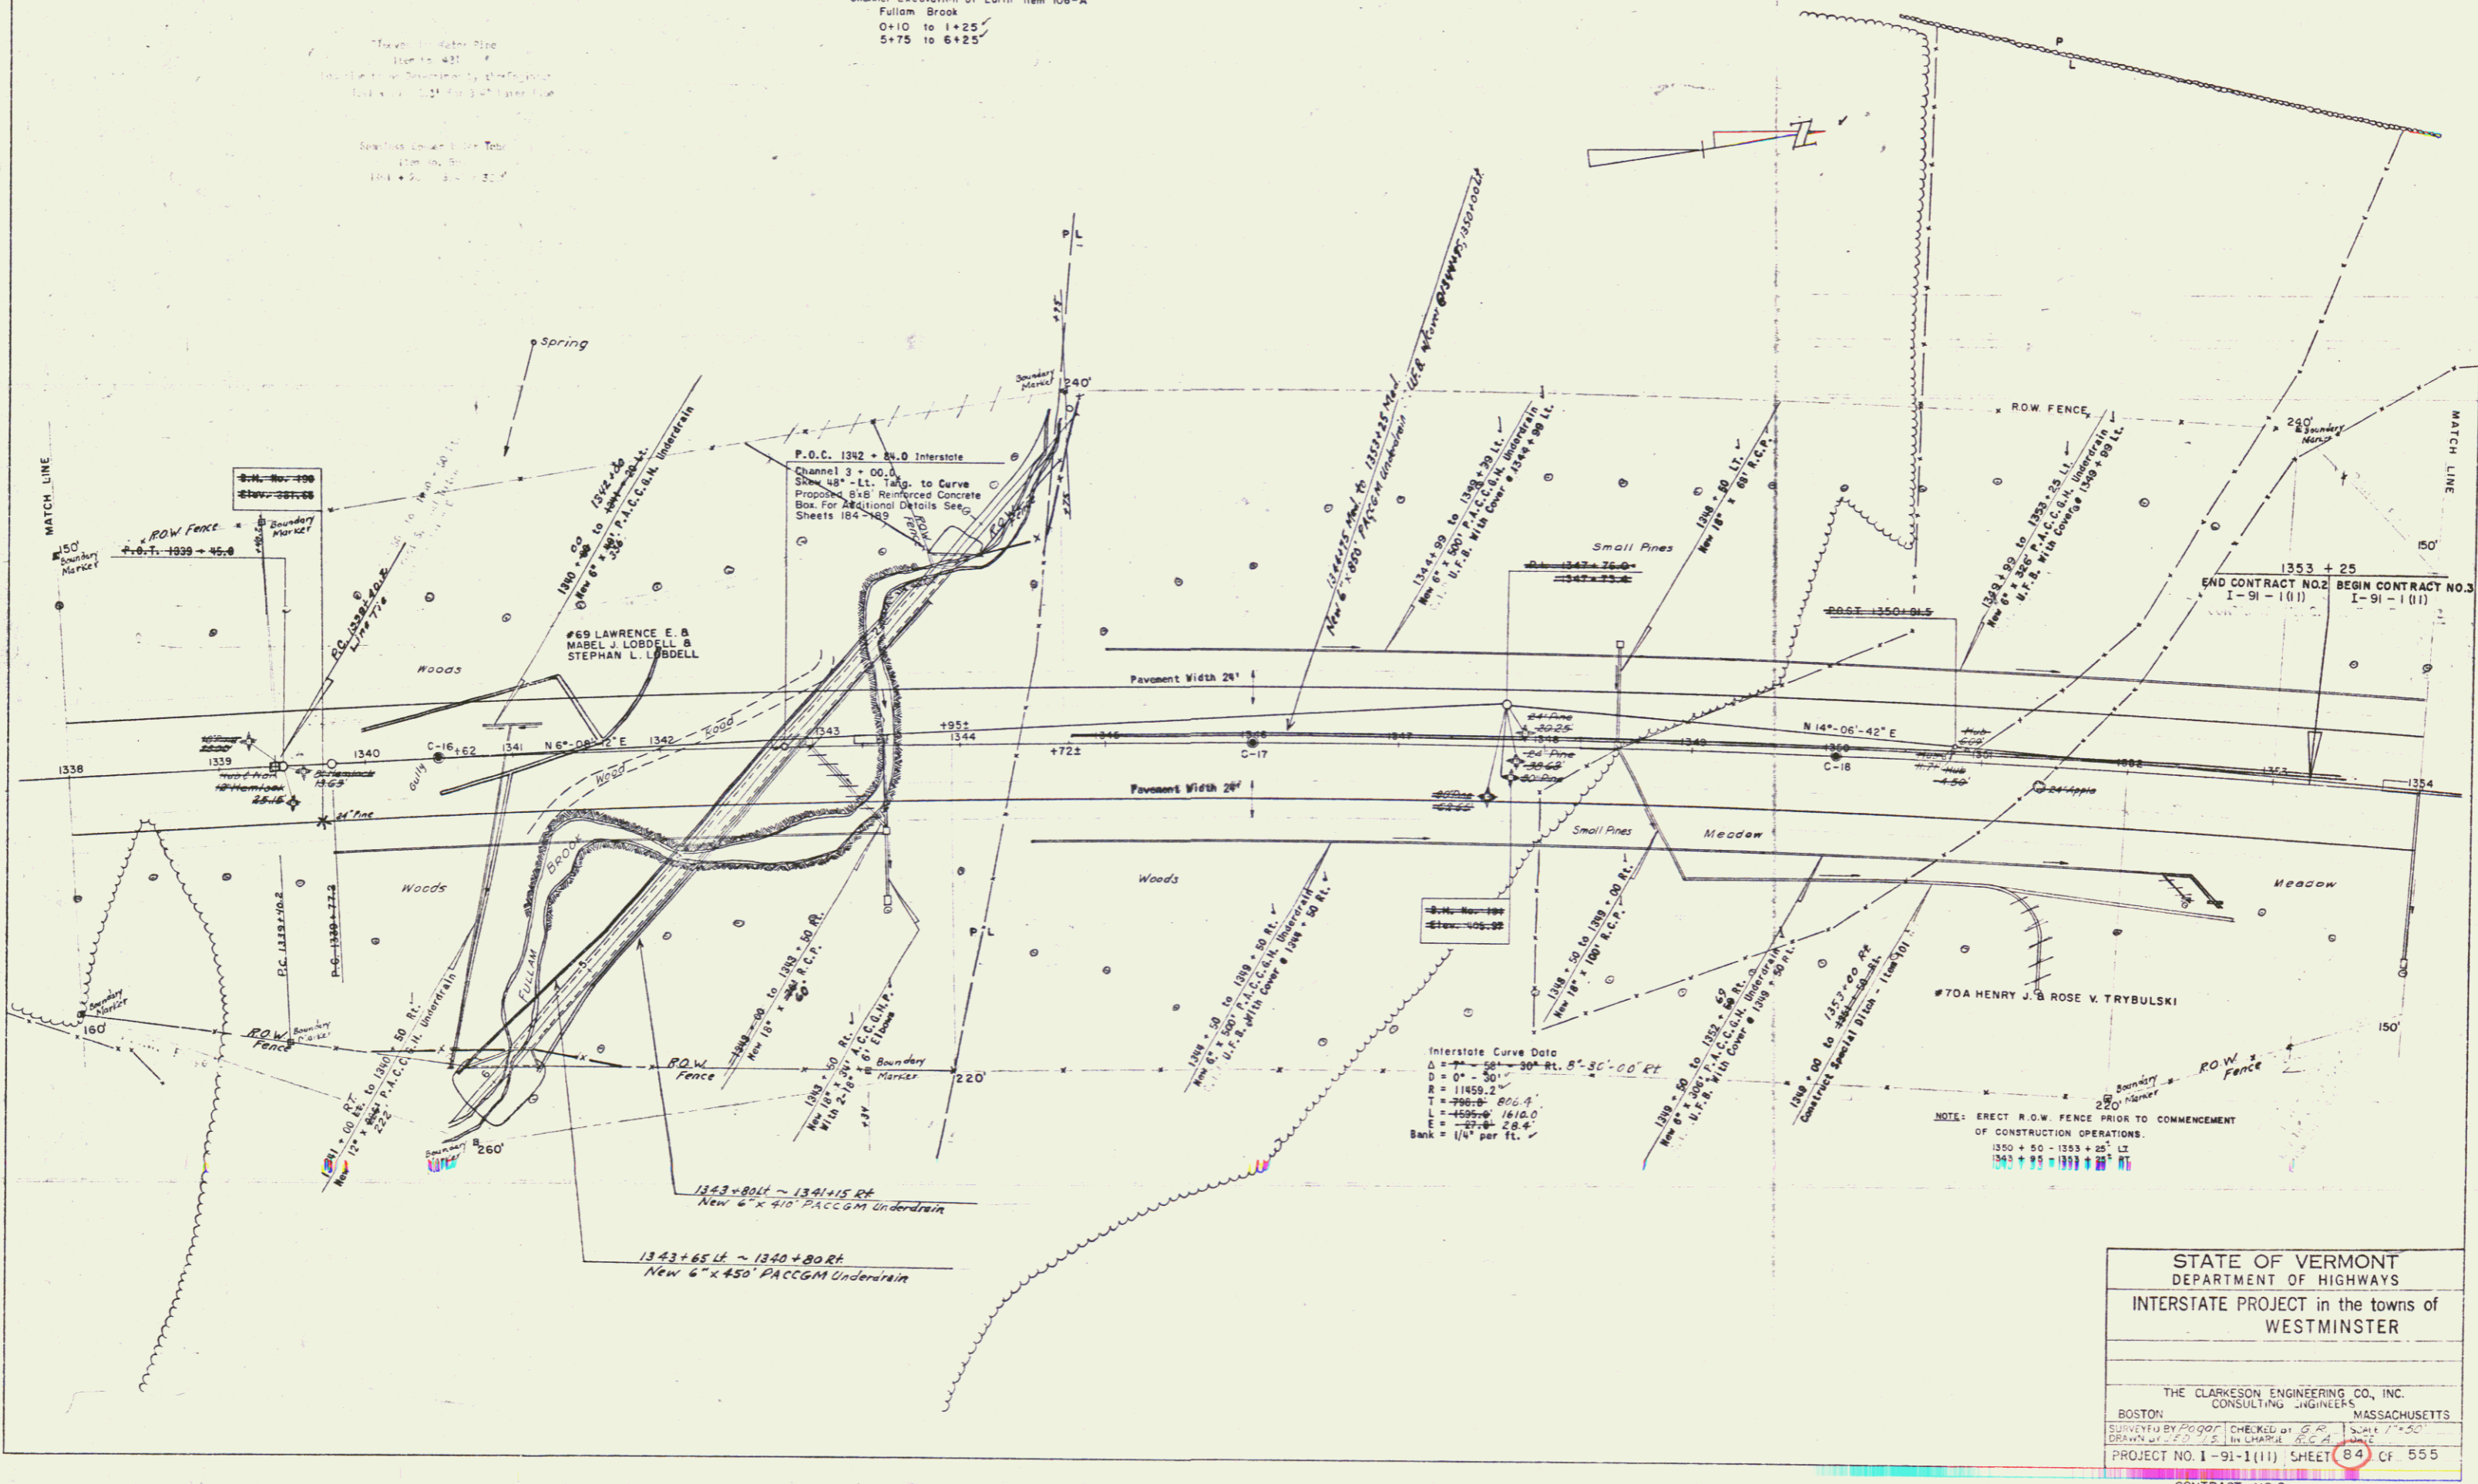

STATE OF VERMONT  
DEPARTMENT OF HIGHWAYS  
INTERSTATE PROJECT in the towns of  
WESTMINSTER

THE CLARKSON ENGINEERING CO., INC.  
CONSULTING ENGINEERS  
BOSTON, MASSACHUSETTS

DESIGNED BY: J.C. [Signature] CHECKED BY: G.A. [Signature] DATE: 7/15/50  
DRAWN BY: J.C. [Signature] IN CHARGE: G.A. [Signature] DATE: 7/15/50

PROJECT NO. I-91-1(11) SHEET 84 OF 555

CONTRACT NO. 2.