

Drilling & Blasting of Solid Rock Subgrade
Item No. 111
4 + 50 to 7 + 00 S.A. #4

Paved Median Gutters
Item No. 361-R
1369 + 75 - 1370 + 00

Bituminous Concrete Curb
Item No. 555
1369 + 00 TO 1370 + 00
1364 + 00 TO 1366 + 00 RT (APPROACH)

Demolition and Removal of Building
Item No. 586
1369 + 50 RT #1


Construct Special Ditch
Item No. 101-A
1368 + 00 - 1370 + 00 RT
1368 + 00

Three Cable Guard Rail with Posts, Item 543 STAGE II CONSTRUCTION
1368 + 00 - 1370 + 00 RT
1364 + 00 - 1369 + 00 RT (APPROACH)


Stone Fill For Slope Protection
Item No. 522
1370 + 00 Rt.

Property Line Fence with Steel Posts
Item No. 522
1364 + 50 to 1370 + 00 LT
1368 + 00 to 1370 + 00 RT

| PLAN NO. | STATE | FED. AID PROJECT NO. | LOCAL PROJECT NO. | SHEET NO. | TOTAL SHEETS |
|----------|-------|----------------------|-------------------|-----------|--------------|
| 1 | VT | I-91-1(23) | | 14 | 149 |

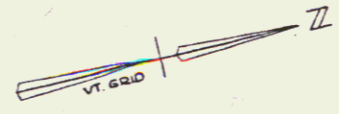

S.A. #4 Curve Data
D = 10' - 3 1/2' Lt.
R = 182.7'
T = 132.3'
L = 303.8'
E = 6.1'
Bank 3/4' per ft.

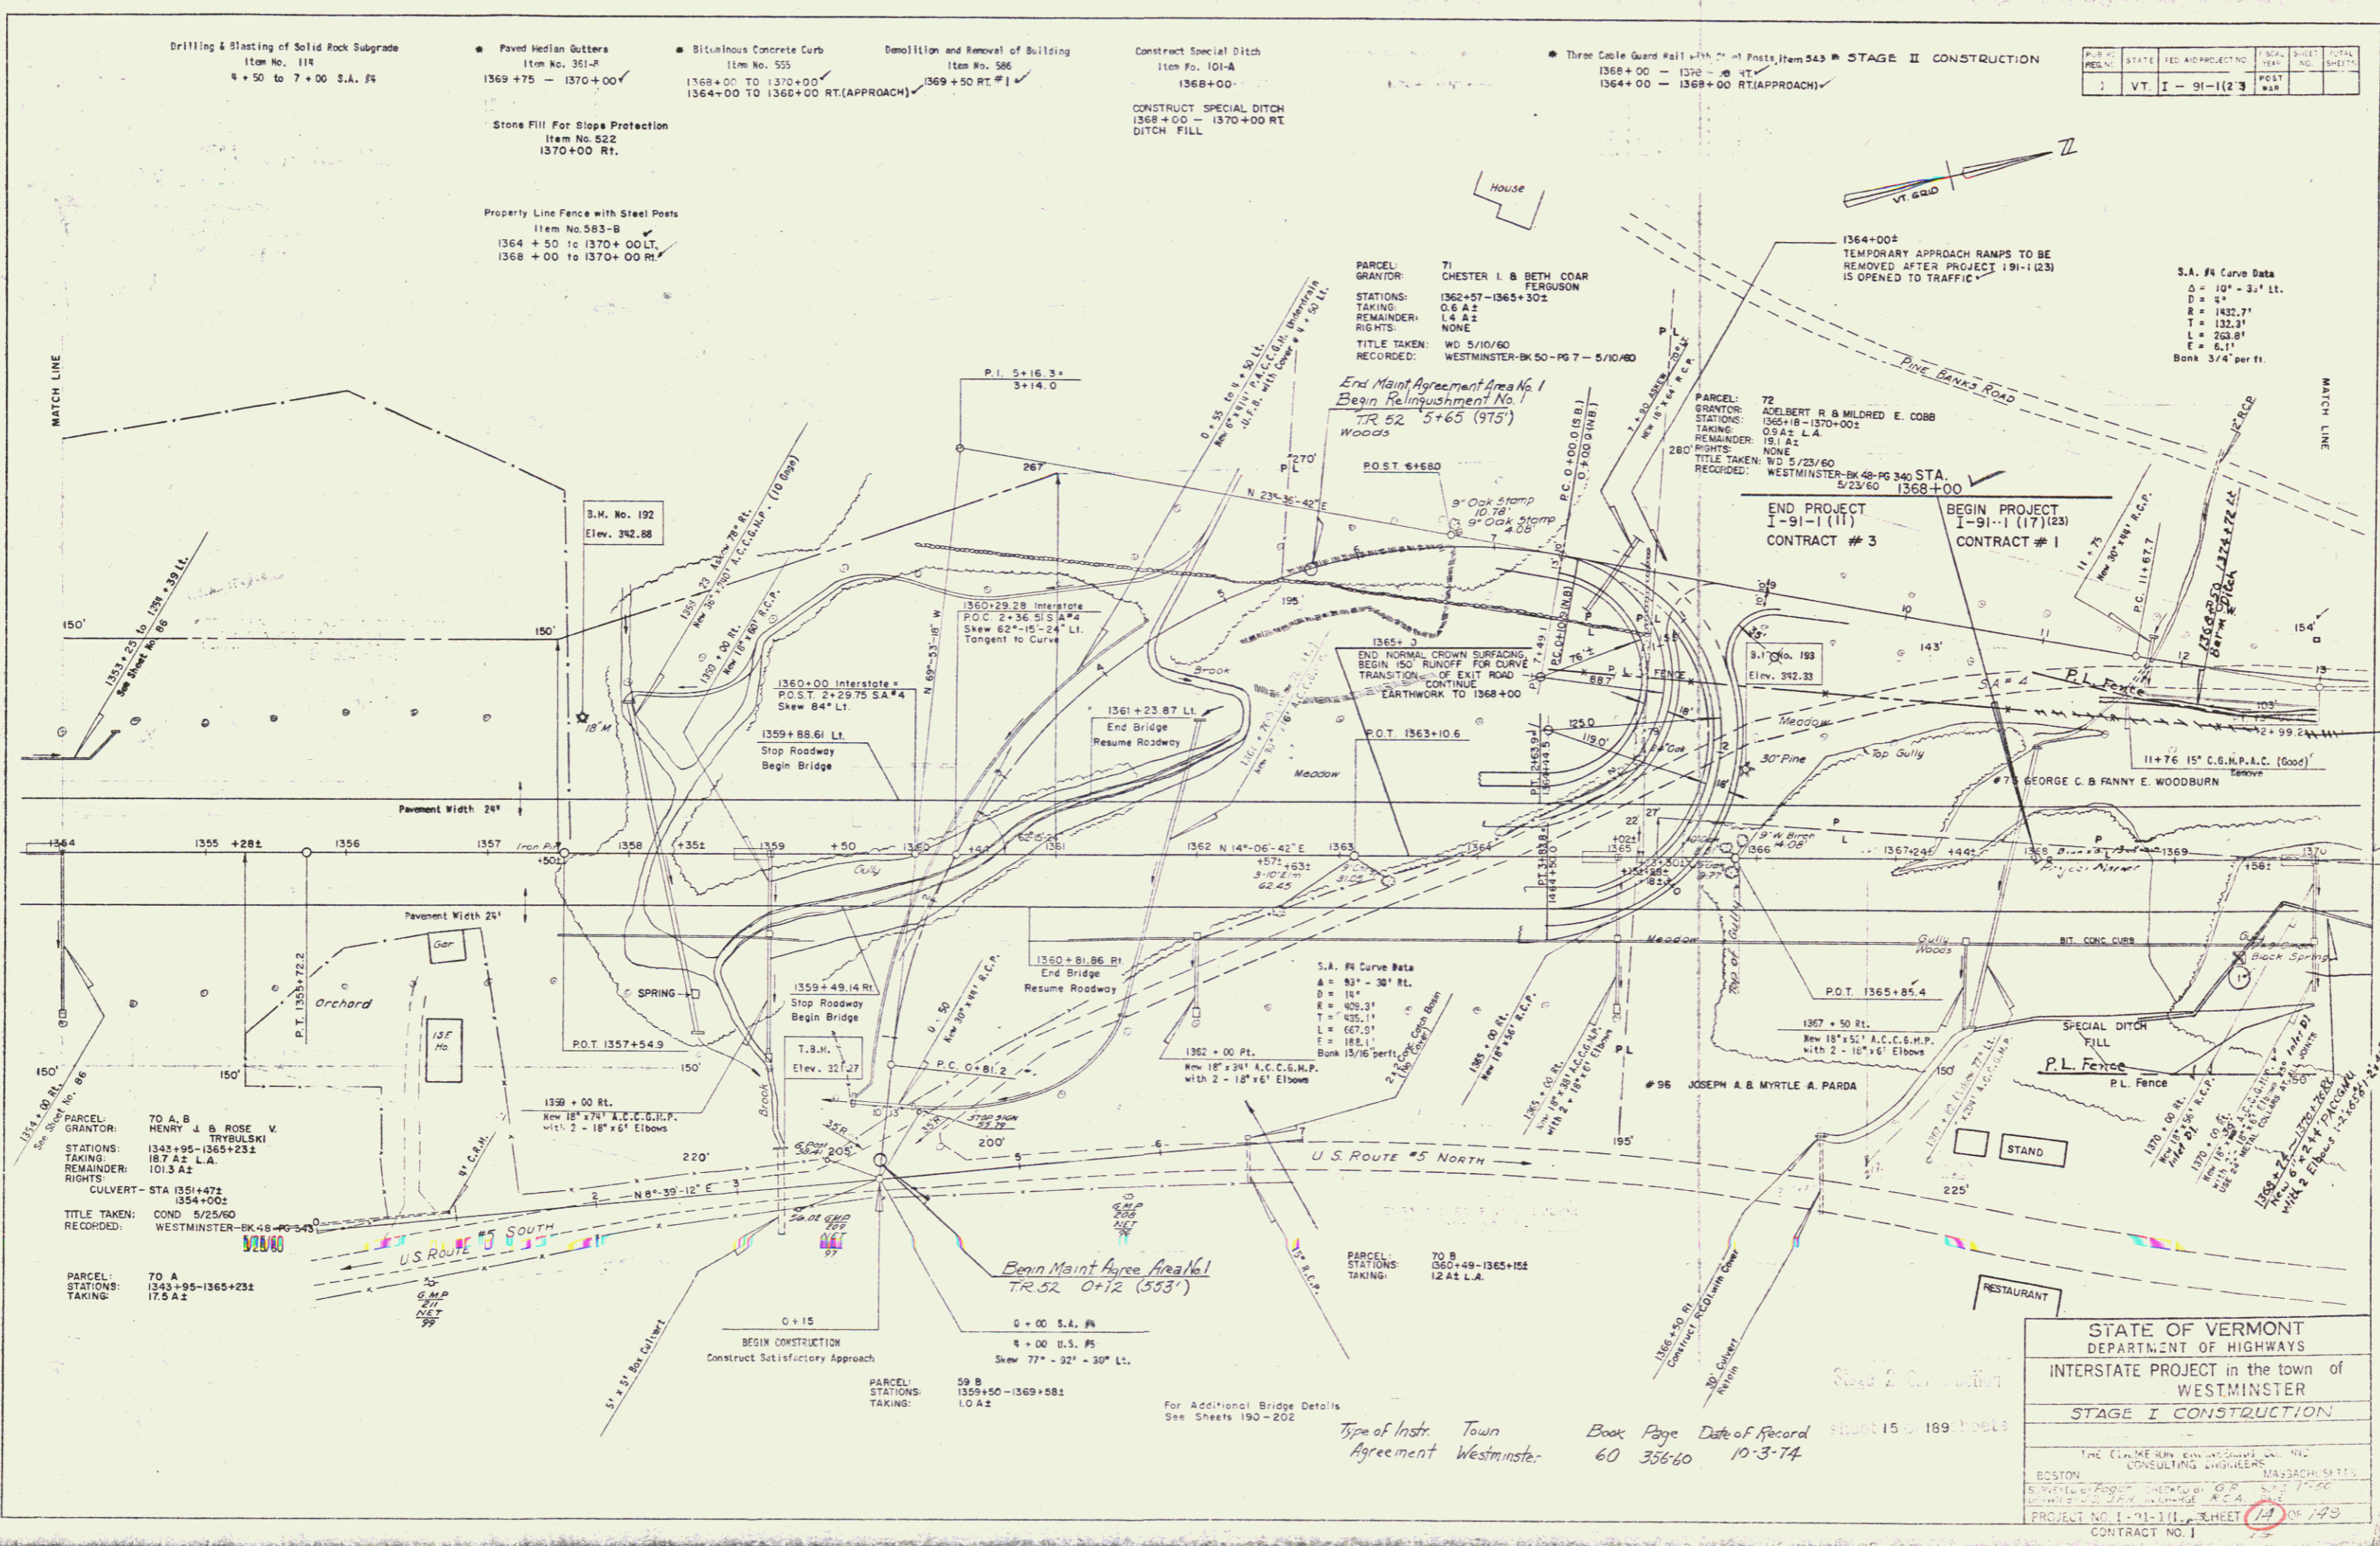

PARCEL: 70 A B
GRANTOR: HENRY J & ROSE V. TRYBULSKI
STATIONS: 1343+95-1365+231
TAKING: 18.7 A2 L.A.
REMAINDER: 101.3 A2
RIGHTS:
CULVERT - STA 1361+472
COND 5/25/60
RECORDED: WESTMINSTER-BK 48-PG 543
5/28/60

PARCEL: 70 A
STATIONS: 1343+95-1365+231
TAKING: 17.5 A2

PARCEL: 59 B
STATIONS: 1359+50-1369+581
TAKING: 1.0 A2

PARCEL: 70 B
STATIONS: 1360+49-1365+152
TAKING: 12 A2 L.A.

For Additional Bridge Details
See Sheets 190-202

Type of Instr. Town Book Page Date of Record
Agreement Westminster: 60 356-60 10-3-74

STATE OF VERMONT
DEPARTMENT OF HIGHWAYS
INTERSTATE PROJECT in the town of
WESTMINSTER
STAGE I CONSTRUCTION

THE COLLEGE HILL ENGINEERS & ARCHITECTS
CONSULTING ENGINEERS
BOSTON MASSACHUSETTS
5 STATE STREET BOSTON MASS 02109
PROJECT NO. I-91-1(11) SHEET 14 OF 149
CONTRACT NO. 1