


Property Line Fence with  
Steel Posts Item 582-D  
1528+00 LF - 1531+00 LF

Reveal Media: Gutter Item 361-D  
1525+51 - 1529+75"  
Ramp D 53100-53125 RHEL  
Ramp D 57100-57125 RHEL

Granite Slope Edging Item 556-P  
1525+51 - 1529+35 LF

Drilling & Blasting of Solid Rock  
Subgrade 15d Item 114  
1026+50 - 1031+00


# STAGE 2 CONSTRUCTION

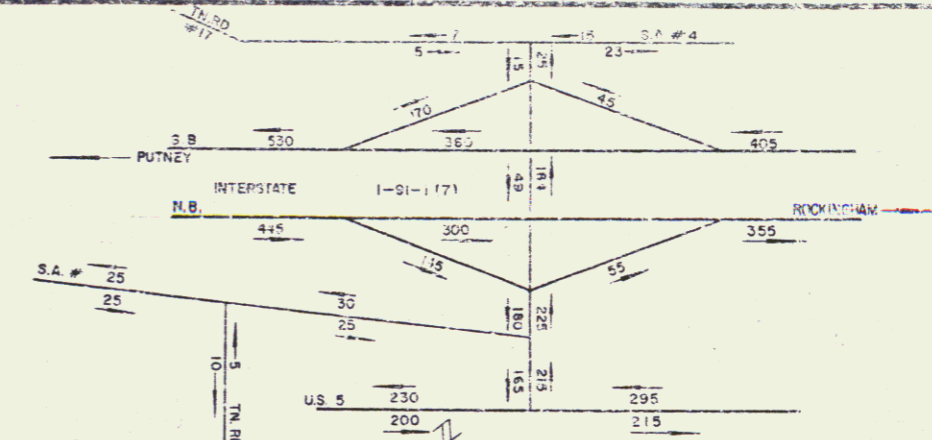

TRAFFIC DIAGRAM  
1980 D.H.V.

Bank Mark #205A SIR 18" diam.  
24" LA 1520+25 Elev. 457.43  
Mod. E.L. 1525+50

B.M. # 208-A  
S.I.R. 18" diam. 220" LF  
Elev. 457.43

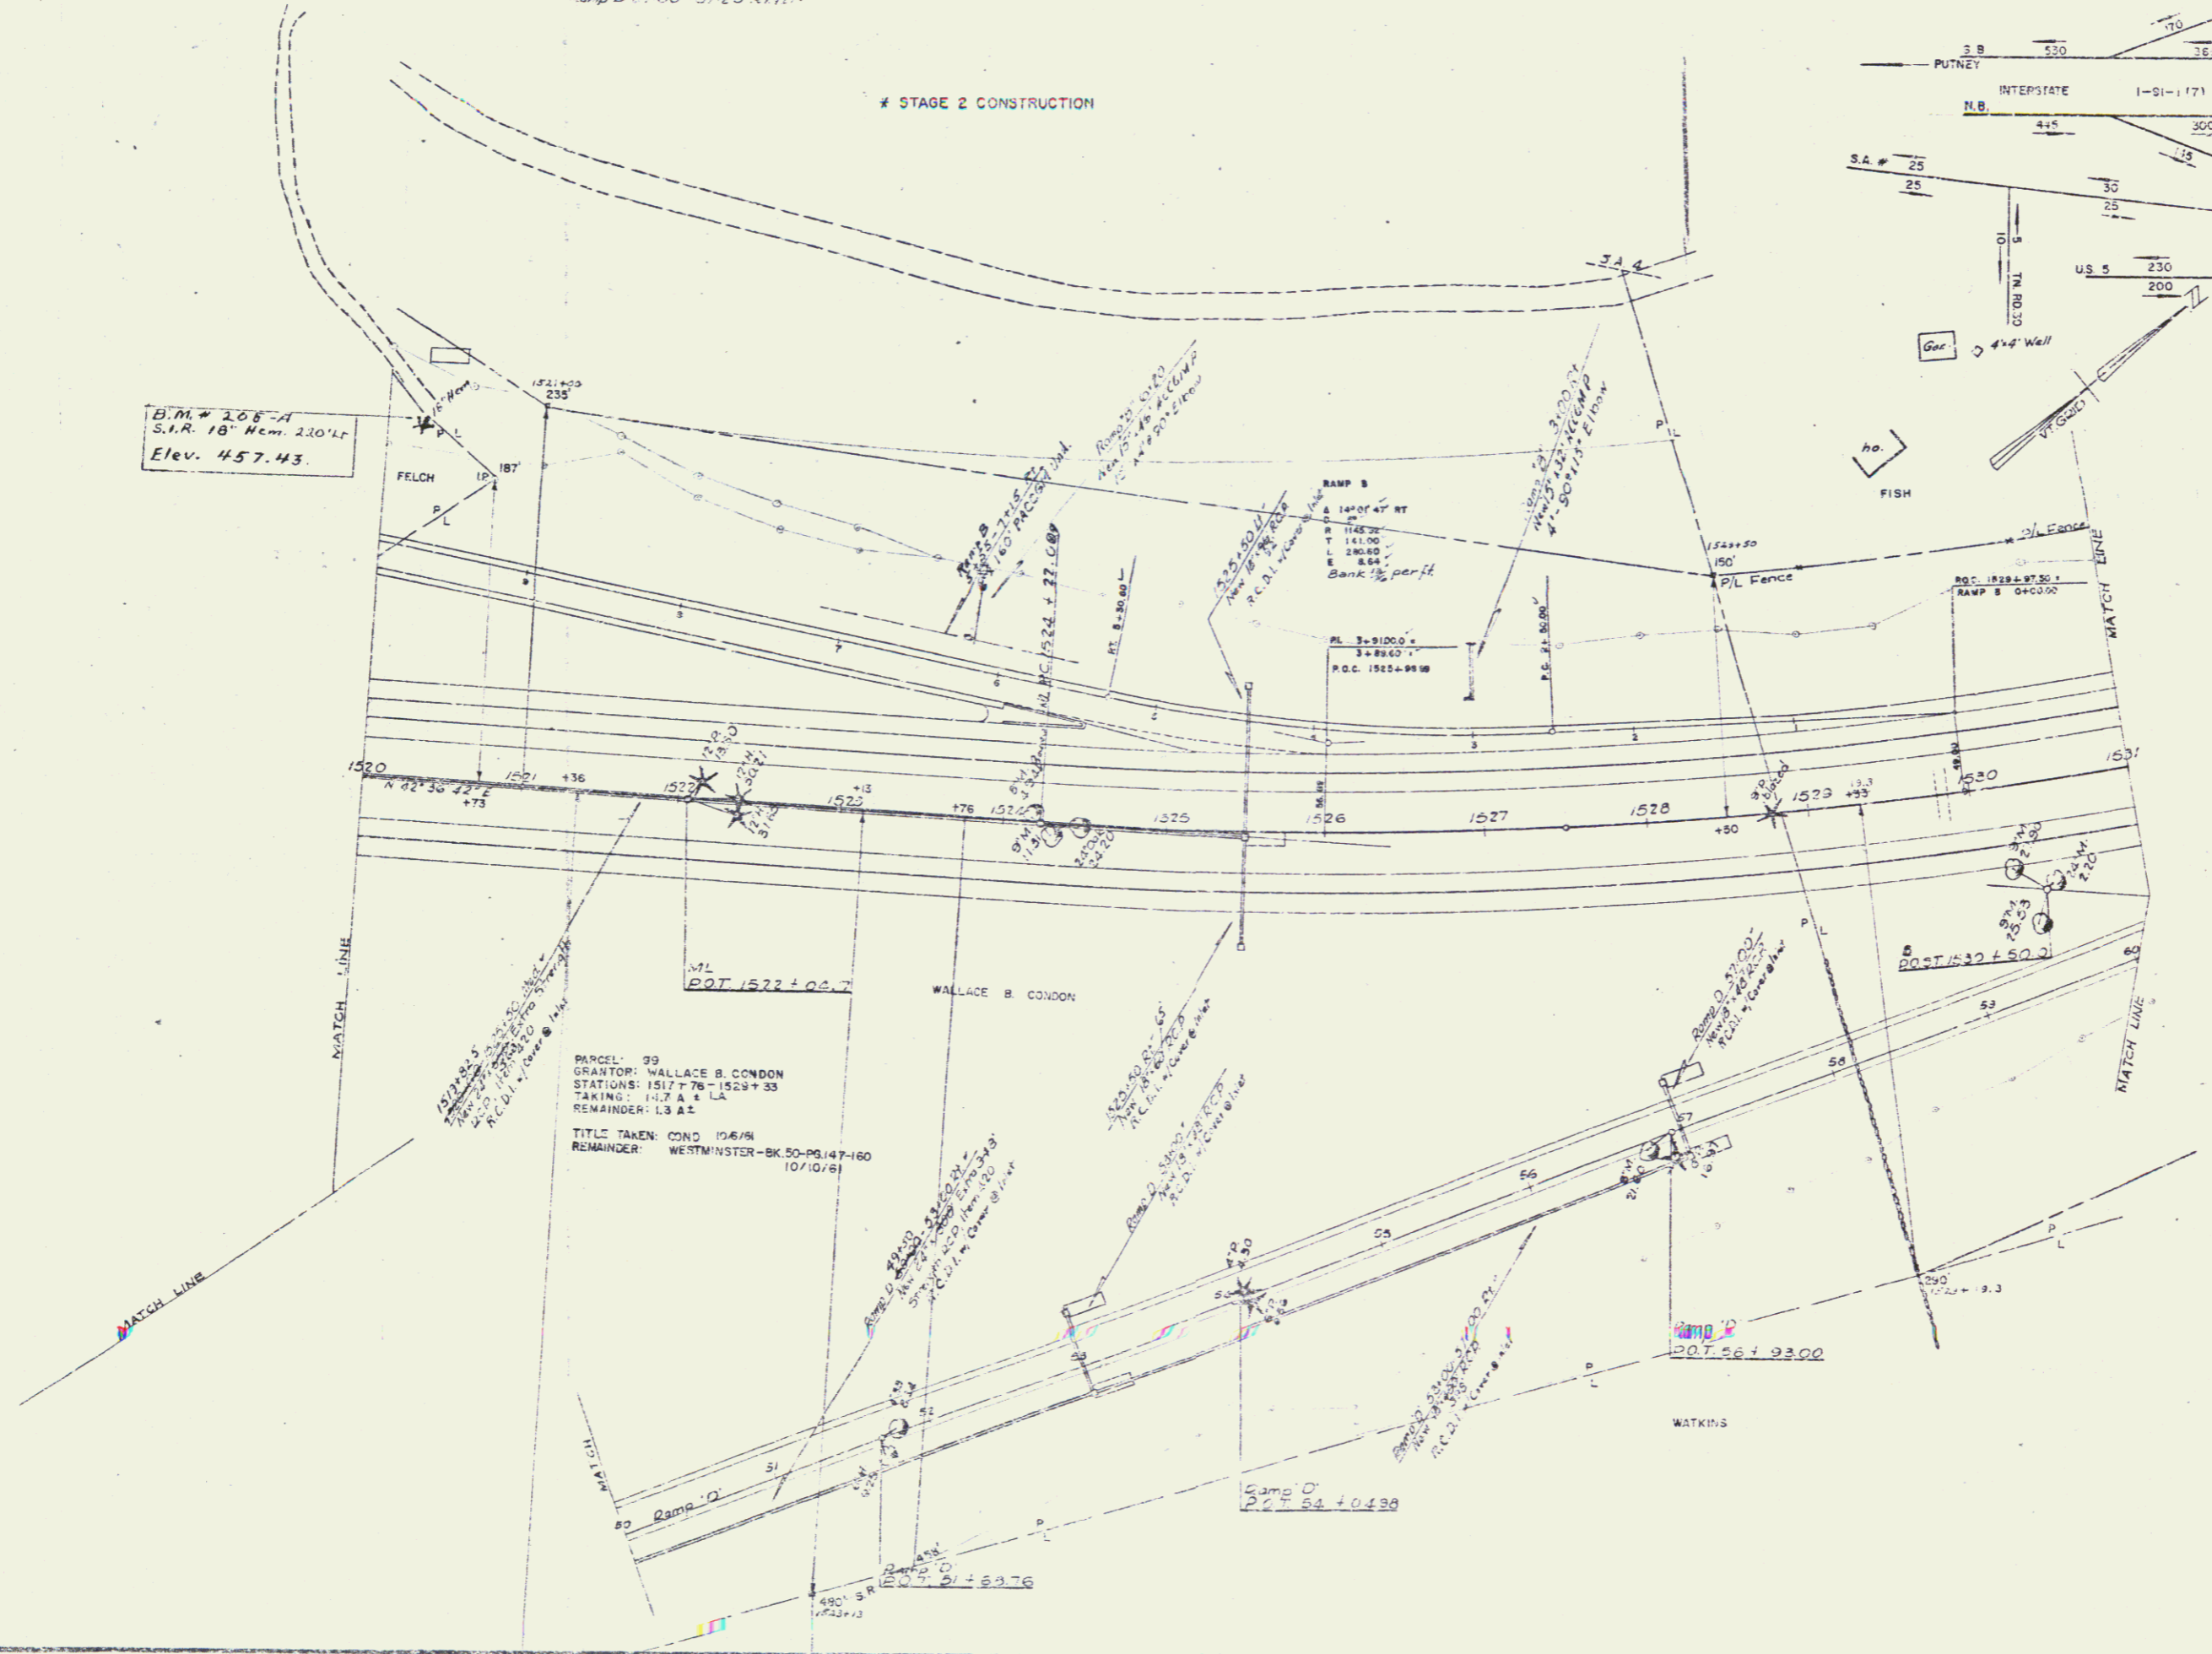

WALLACE B CONDON  
GRANTOR: WALLACE B CONDON  
STATIONS: 1517+76 - 1523+33  
TAKING: 1517 & 1518  
REMAINDER: 1518 & 1519  
TITLE TAKEN: COND 10/6/94  
REMAINDER: WESTMINSTER-BK 50-PG 147-160  
10/10/81

Stage 2 Construction  
sheet 36 of 199 sheets  
STAGE 1 CONSTRUCTION  
WESTMINSTER

PROJECT I NO 91-1 (17) 123  
SHEET 36 OF 199 SHEETS

CONTRACT NO. 2