

INDEX OF SHEETS

- 1 TITLE PAGE
- 2-3 TYPICAL SECTIONS AND DETAILS
- 4-5 QUANTITY SHEETS, ITEMS
- 6-7 GRADE AND EARTHWORK SHEETS
- 8-11 EARTHWORK SUMMARY
- 12 PLAN AND PROFILE SHEETS
- 13-15 **TRAFFIC SIGN LOCATION PLAN**
- 16-18 TRAFFIC SIGNS, DESIGN AND CONSTRUCTION DETAILS, SUMMARY AND GENERAL NOTES
- 19-21 SIX-TONS RIVER STRUCTURES
- 22-24 SCB-30-58(1) 30' ROADWAY COMPOSITE BEAM BRIDGES
- 25-27 SCB-30-58(2) 30' ROADWAY COMPOSITE BEAM BRIDGES
- 28-30 SB-50-60 DETAILS OF BRIDGE RAILING (2 SHEETS)
- 31-33 SB-20-56 CONSTRUCTION DETAILS FOR WF BRIDGES
- 34-36 SB-22-58 DETAIL OF EXPANSION JOINT OVER PIERS AND ABUTMENTS
- 37-39 SCB-D-60 DETAILS OF WF BEAMS-BRIDGES
- 40-42 A-61 DRILLING AND BLASTING OF SOLID ROCK
- 43-45 B-1 BANKING TABLES
- 46-48 B-5 TYPICAL SLOPE GRADING
- 49-51 **B-6 MUCK EXCAVATION**
- 52-54 B-13 DRIVEWAY DETAILS
- 55-57 B-17 DETAIL OF GUARD RAIL IN MEDIAN, SAFETY TURNOUT AND U-TURN
- 58-60 C-1 CURBS
- 61-63 D-1 PRECAST R.C.P. DROP INLETS AND CATCH BASINS
- 64-66 D-2 HEADWALLS AND UNDERDRAIN
- 67-69 D-3 GUTTERS
- 70-72 D-4 PLATE PIPE, PIPE ELBOWS, FLUSHING BASINS AND METAL END SECTIONS
- 73-75 D-6 REINFORCED CONCRETE DROP INLETS
- 76-78 D-10 TOP FOR A DROP INLET
- 79-81 D-11 GRATES AND COVERS FOR DROP INLETS
- 82-84 D-13 CONCRETE CATCH BASINS OR MANHOLES
- 85-87 E-1 BARRICADES, SIGNS AND LIGHTS (ROADWAY)
- 88-90 E-3 REGULATORY SIGNS
- 91-93 E-4 ROUTE MARKERS AND AUXILIARY MARKERS
- 94-96 E-5 SIGN POST FOOTINGS
- 97-99 E-7 STANDARD SIGN PLACEMENT
- 100-102 E-8 DELINEATORS
- 103-105 E-9 CONSTRUCTION IDENTIFICATION SIGNS
- 106-108 F-1 PROPERTY LINE FENCE
- 109-111 G-1 STEEL BEAM GUARD RAIL
- 112-114 G-3 THREE CABLE GUARD RAIL
- 115-117 G-4 MARKER POSTS AND GUIDE POSTS
- 118-120 J-1 PROJECT MARKERS AND BOUNDARY MARKERS
- 121-123 CROSS SECTIONS


**STATE OF VERMONT
DEPARTMENT OF HIGHWAYS**

**PROPOSED IMPROVEMENT
INTERSTATE PROJECT IN THE TOWNS OF
WESTMINSTER - ROCKINGHAM
COUNTY OF WINDHAM**

**PROJECT NO. I 91-1 (15) Interstate Route I 91
CONTRACT NO. 2**

BEGINNING 0.543 MILES SOUTH OF THE WESTMINSTER-ROCKINGHAM TOWN LINE AT STATION 16311+00 AND CONTINUING IN A NORTHERLY DIRECTION 1.368 MILES TO STATION 17024+00
 LENGTH OF ROADWAY = 6,692.50 FEET = 1.267 MILES
 LENGTH OF BRIDGE = 5,325.00 FEET = 1.010 MILES
 LENGTH OF CONTRACT = 7,225.00 FEET = 1.368 MILES

DESIGN DESIGNATION
 ADT - 19,500 = 2280
 ADT - 9,750 = 5060
 DHV - 97.75 = 715
 T = 7%
 D = 54%
 V = (70) MPH

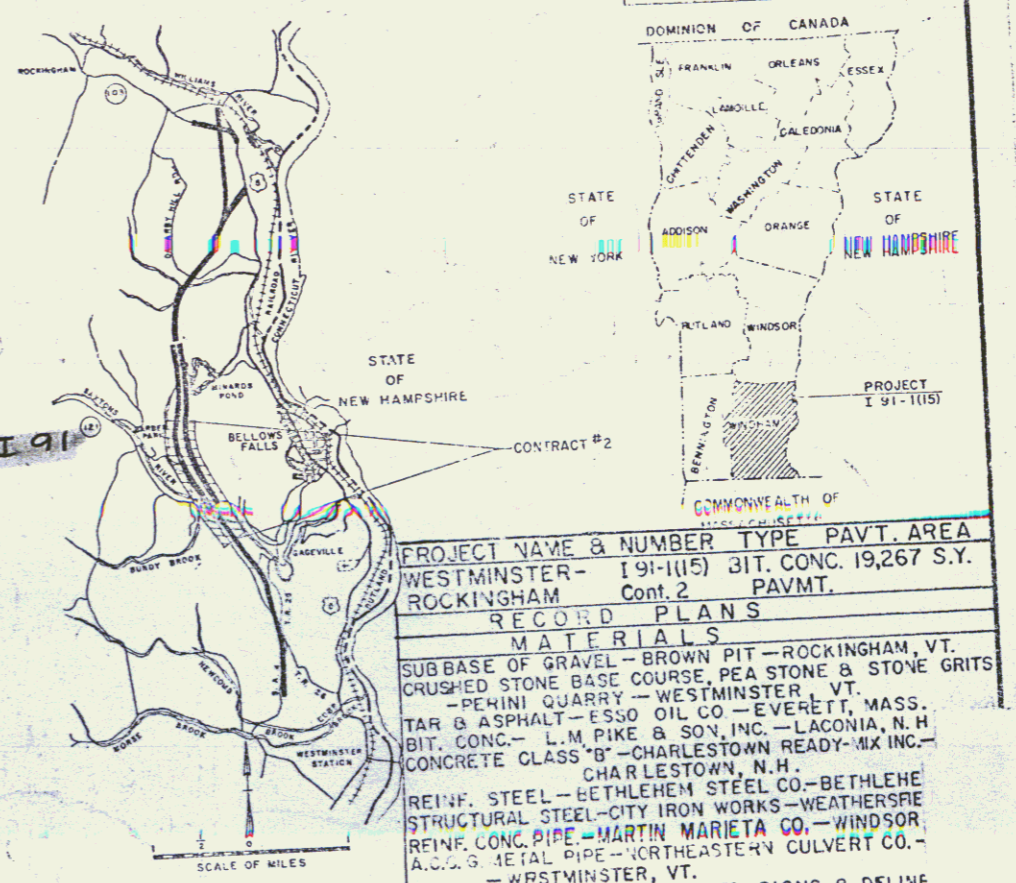

PROJECT NAME & NUMBER	TYPE	PAVMT. AREA
WESTMINSTER - I 91-1(15)	31T. CONC.	19,267 S.Y.
ROCKINGHAM Cont. 2	PAVMT.	

RECORD PLANS


MATERIALS

SUBBASE OF GRAVEL - BROWN PIT - ROCKINGHAM, VT.
 CRUSHED STONE BASE COURSE, PEA STONE & STONE GRITS - PEHINI QUARRY - WESTMINSTER, VT.
 TAR & ASPHALT - ESSO OIL CO. - EVERETT, MASS.
 BIT. CONC. - L.M. PIKE & SON, INC. - LACONIA, N.H.
 CONCRETE CLASS "B" - CHARLESTOWN READY-MIX INC. - CHARLESTOWN, N.H.
 REINF. STEEL - EETHLEHEM STEEL WORKS - WEATHERSPE
 STRUCTURAL STEEL - CITY IRON WORKS - WINDSOR
 REINF. CONC. PIPE - MARTIN MARIETTA CO. - WINDSOR
 A.C.S.G. METAL PIPE - NORTHEASTERN CULVERT CO. - WESTMINSTER, VT.

GUARD RAIL, PROPERTY LINE FENCE, MARKER POSTS, SIGNS & DELINE. - S. F. GRISWOLD & CO. INC. - WILLISTON, VT.

CONTRACTOR - PERINI CORP.
 FRAMINGHAM, MASS.
RESIDENT ENGINEER - THOMAS R. PINELLO
INSPECTOR - LEON TESSIER
RECORD PLANS - LEON TESSIER

CONTRACT NO. 2
 DATED - MARCH 16, 1962.
 STARTED - APRIL 5, 1962.
 COMPLETED - SEPT. 11, 1963.
 ACCEPTED - SEPT. 11, 1963.

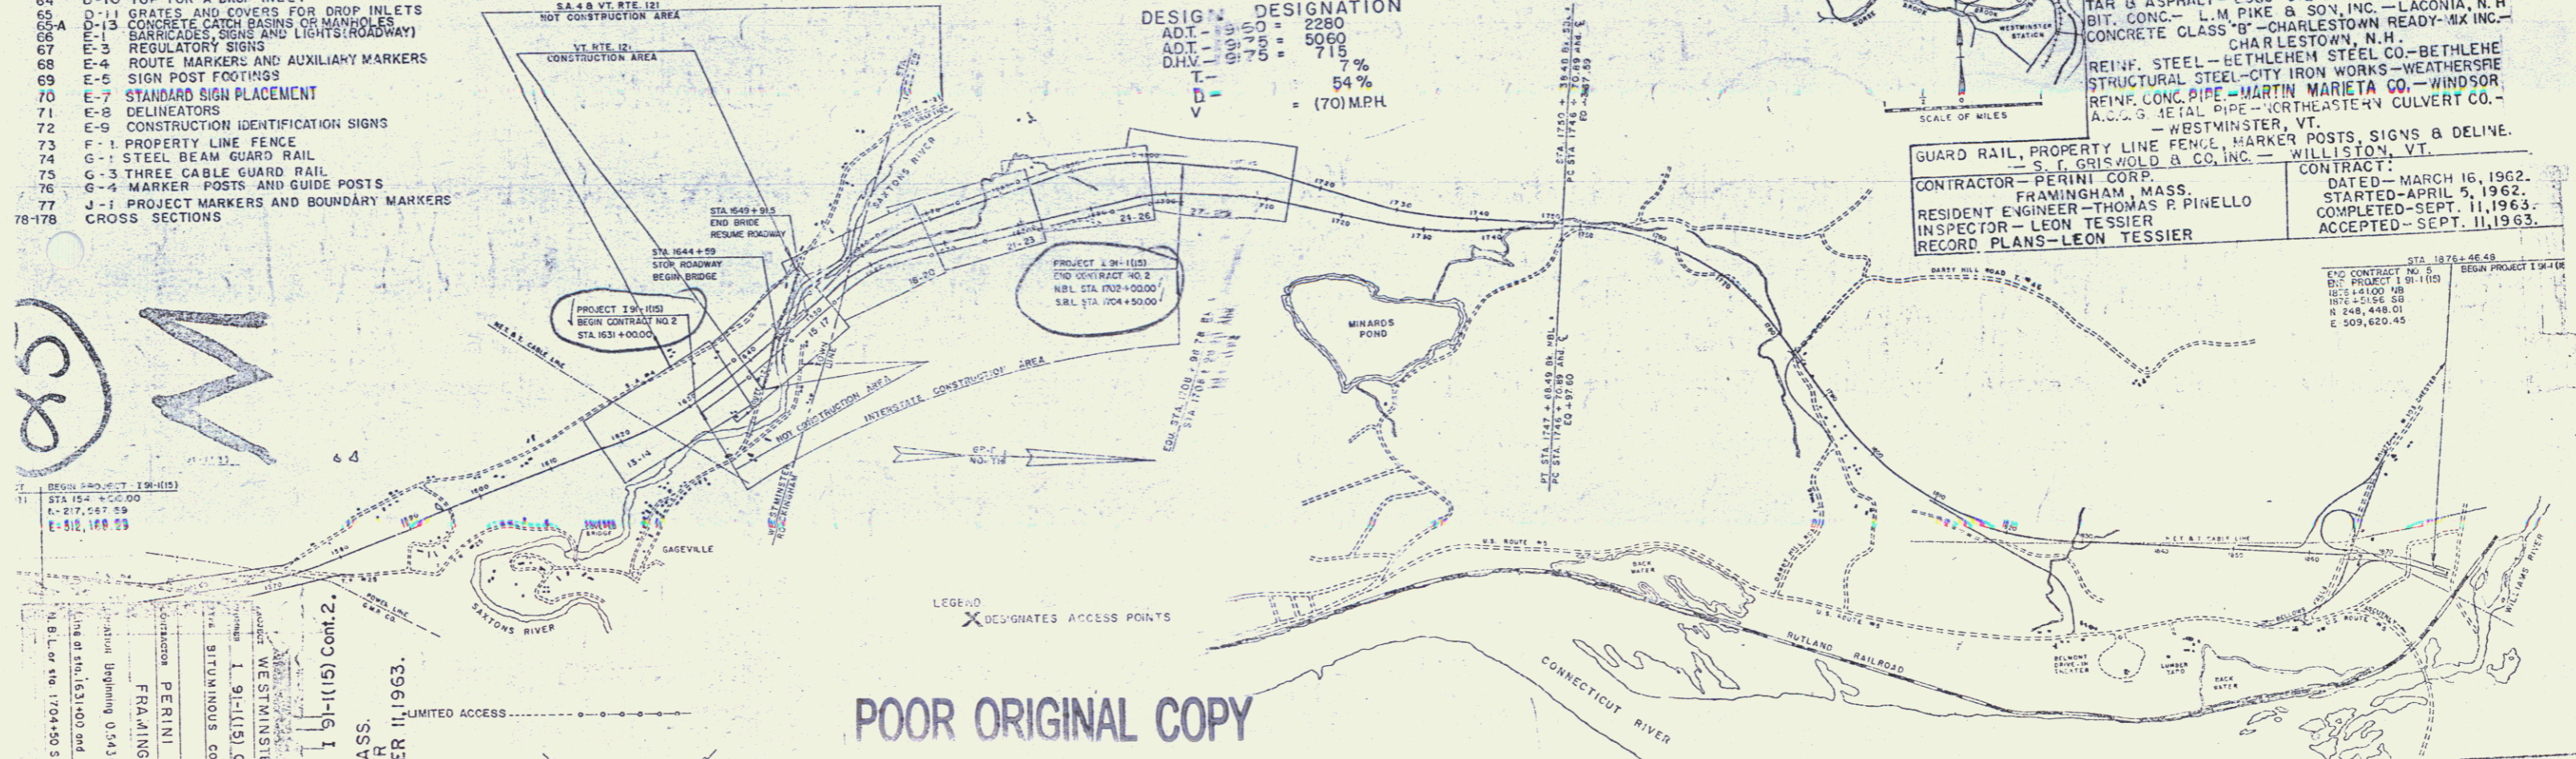

**POOR ORIGINAL COPY
RIGHT-OF-WAY
and Construction Plans**

WESTMINSTER - ROCKINGHAM I 91-1(15) Cont. 2.
 CONTRACTOR - PERINI CORP., FRAMINGHAM, MASS.
 RECORD PLANS BY LEON TESSIER
 COMPLETED - SEPTEMBER 11, 1963.

CURVE DATA

DEFLECTION OF ANGLE	A
DEGREE OF CURVE	D
RADIUS OF CURVE	R
TANGENT DISTANCE	T
LENGTH OF CURVE	L
EXTERNAL DISTANCE	E
POINT OF INTERSECTION	PI
POINT OF CURVE	P.C.
POINT OF TANGENT	P.T.
POINT BY TANGENT	P.O.T.
POINT ON ALIGNMENT	P.O.A.

SCALES

TYPICALS	AS NOTED
PLAN	1" = 100'
PROFILE	HORIZONTAL 1" = 100'
	VERTICAL 1" = 10'
CROSS-SECTIONS	1" = 10'

DESIGNED AND RECOMMENDED BY
 WILLIAM J. HARRIS, CIVIL ENGINEER
 STATE OF VERMONT LICENSE NO. 122
 DATE JULY 21, 1960

THESE PLANS ARE SUBJECT TO SUCH REVISIONS AS MAY BE REQUIRED BY THE BUREAU OF PUBLIC ROADS OR THE COMMISSIONER OF HIGHWAYS.
 CONSTRUCTION IS TO BE CARRIED ON IN ACCORDANCE WITH THE PLANS AND THE STANDARD SPECIFICATIONS FOR HIGHWAY AND BRIDGE CONSTRUCTION OF VERMONT 1956 SUBMITTED TO THE BUREAU OF PUBLIC ROADS AS APPROVED JULY 5, 1956, INCLUDING ALL SUBSEQUENT APPROVED REVISIONS AND SUCH REVISED SPECIFICATIONS AND SPECIAL PROVISIONS AS ARE QUANTIFIED WITH THE PLANS.

DEPARTMENT OF COMMERCE
 BUREAU OF PUBLIC ROADS

APPROVED
 [Signature]
 CHIEF ENGINEER