


DRILLING & BLASTING OF SOLID ROCK SUBGRADE, 115M H&M
 SEE STA 1745+00 TO STA 1747+00
 SEE STA 1747+00 TO STA 1747+50 RL
 STA 1747+71 AND TO STA 1754+00

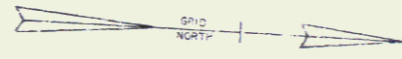

PROPERTY LINE FENCE W/STEEL POSTS
 NGL STA 1742+00 TO STA 1747+00 AT
 32.5' TO 1745+00 TO STA 1747+00 AT
 To be erected in the vicinity of the
 pipe gallery at the approximate
 location shown on plan sheet No. 24
 of 187 or as directed by the
 engineer.


THREE CARL SWORD MAIL W/STEEL POSTS
 NGL STA 1747+00 TO STA 1748+00
 STA 1748+00 TO STA 1748+50
 STA 1748+50 TO STA 1749+00
 STA 1749+00 TO STA 1749+50
 STA 1749+50 TO STA 1750+00

PAVED GUTTERS
 STA 1747+00 TO STA 1747+50
 STA 1747+50 TO STA 1748+00
 STA 1748+00 TO STA 1748+50
 STA 1748+50 TO STA 1749+00
 STA 1749+00 TO STA 1749+50
 STA 1749+50 TO STA 1750+00

PARCEL 140C
 GRANTOR: BELLOWS FALLS VILLAGE CORP
 STATIONS: 1752+00 - 1752+10
 TAKING: 433A2
 REMAINDER 900 E AT
 R/W: 60' (40' + 20' CLRT)
 TITLE TAKEN - COND 12/6/51
 RECORDED - ROCKINGHAM - BK 113 - PG 152 12/9/51

PARCEL 140D
 STATIONS: 1756+33NGL - 1787+12
 TAKING: 273A2 L.A.

PARCEL 140C
 STATIONS: 1758+00 - 1755+75
 TAKING: 152A2 L.A.

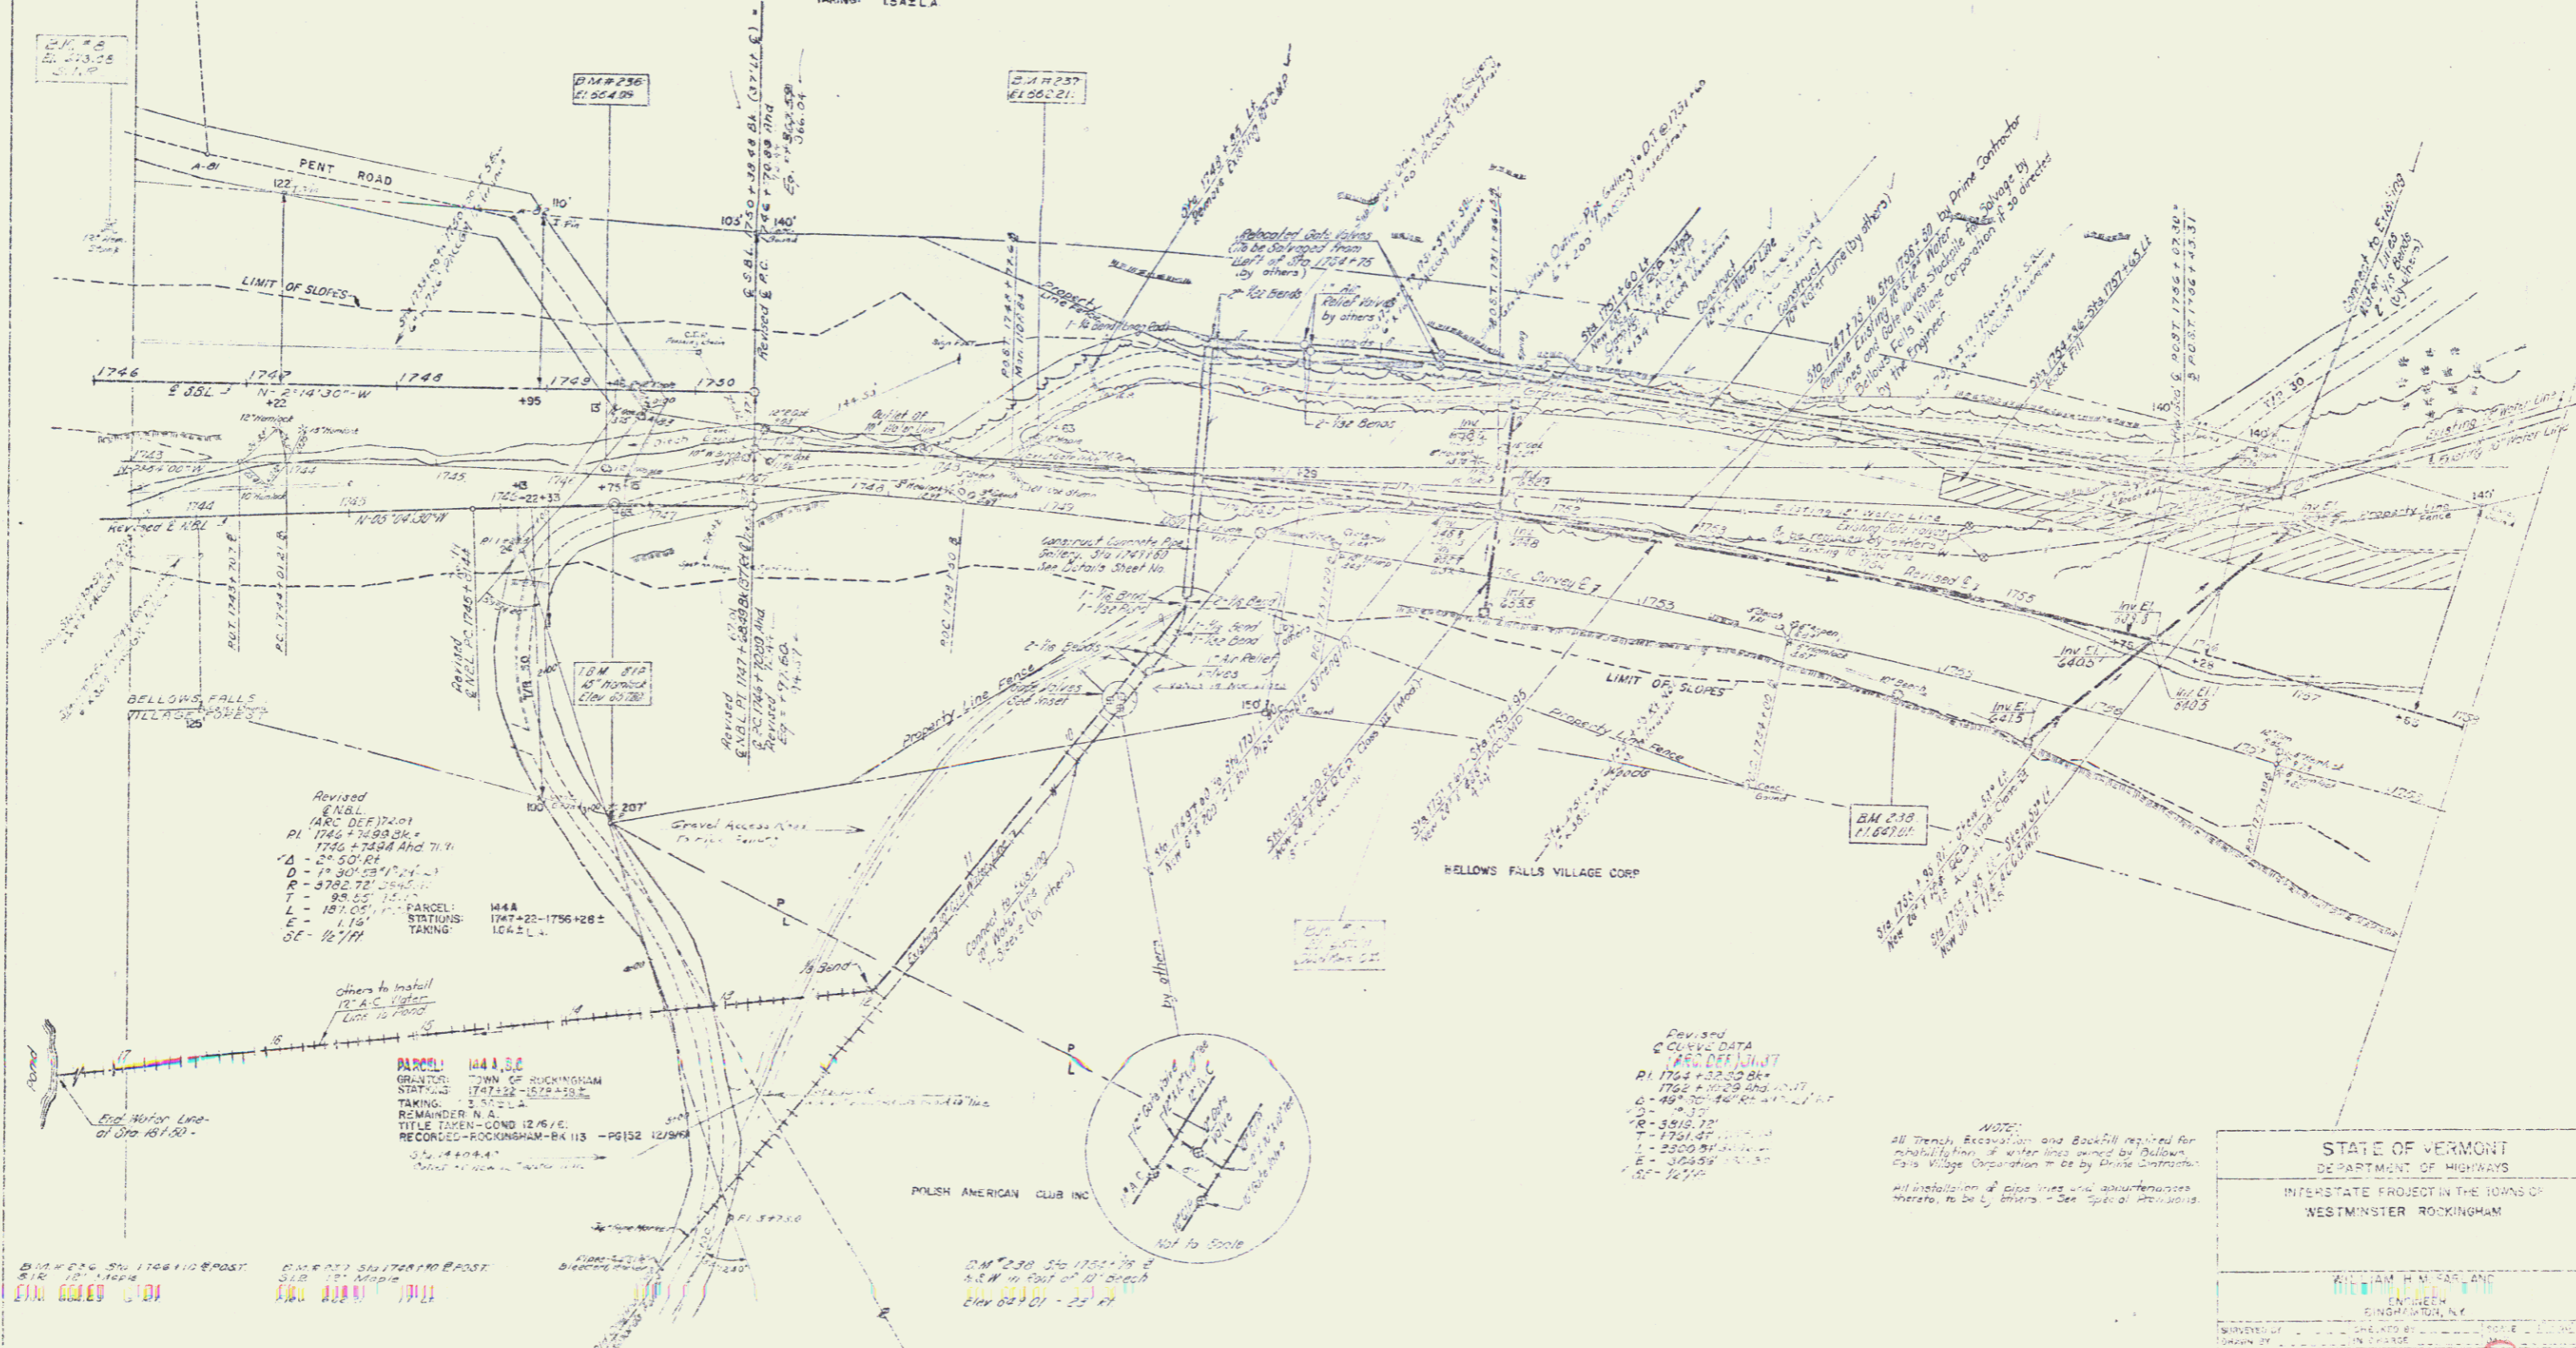

Revised
 NGL
 ARC DE 17401
 PL 1746 + 74.88 RL
 1750 + 74.88 And 71.1
 A - 2° 50' RT
 D - 75.30' (34' 7.4" + 40.9')
 P - 378.2' (171.0' + 207.2')
 T - 89.65' (41.0' + 48.65')
 L - 187.00'
 E - 1.74'
 CE - 12.71'

PARCEL 144A, B, C
 GRANTOR: TOWN OF ROCKINGHAM
 STATIONS: 1747+00 - 1756+28
 TAKING: 1042 L.A.
 REMAINDER IN A
 TITLE TAKEN - COND 12/6/51
 RECORDED - ROCKINGHAM - BK 113 - PG 152 12/9/51

Revised
 CURVE DATA
 ARC DEF JUNCT
 PL 1756 + 102.50 RL
 1758 + 102.50 RL
 A - 49° 30' 34" RT
 D - 117.72'
 P - 3515.72'
 T - 1751.47'
 L - 2250.91'
 E - 3225.51'
 CE - 12.71'

NOTE:
 All Trench, Excavation and Backfill required for
 installation of pipe lines shall be done by Bellows
 Falls Village Corporation or its duly authorized
 contractor. All installation of pipe lines and accessories
 thereto, to be by others - See Special Provisions.

STATE OF VERMONT
 DEPARTMENT OF HIGHWAYS
 INTERSTATE PROJECT IN THE TOWNS OF
 NESTMINSTER ROCKINGHAM

WILLIAM H. PARSONS
 ENGINEER
 SINGAPORE, N.Y.

DATE: 12/21/51
 SHEET: 24 OF 24