

SHEET NO. INDEX OF SHEETS

- 1 TITLE PAGE
- 2-6 TYPICAL SECTIONS AND DETAILS (3" BITUMINOUS CONCRETE PAVEMENT, ITEM 361-B, MOD.)
- 7-8 QUANTITY SHEETS, ITEMS
- 9-10 QUANTITY SHEETS, DRAINAGE
- 11-13 GRADE AND EARTHWORK SHEETS
- 14 EARTHWORK SUMMARY
- 15-27 PLAN AND PROFILE SHEETS
- 28 TRAFFIC SIGN LOCATION PLAN
- 29 TRAFFIC SIGN DESIGN AND CONSTRUCTION DETAILS
- 30 TRAFFIC SIGN SUMMARY AND GENERAL NOTES
- 31 DELINEATOR LOCATION PLAN
- 32 A-61 DRILLING AND BLASTING OF SOLID ROCK
- 33 B-1 BANKING TABLES
- 34 B-5 TYPICAL SLOPE GRADING
- 35 B-6 MUCK EXCAVATION
- 36 B-15 ENTRANCE AND EXIT TERMINALS
- 37 B-16 DIVISIONAL ISLAND AND TRIANGULAR ISLAND DETAILS
- 38 C-1 CURBS
- 39 D-1 PRECAST R.C.P. DROP INLETS AND CATCH BASINS
- 40 D-2 HEADWALLS AND UNDERDRAIN
- 41 D-3 GUTTERS
- 42 D-4 PLATE PIPE, PIPE ELBOWS, FLUSHING BASINS AND METAL END SECTIONS
- 43 D-8 REINFORCED CONCRETE DROP INLETS
- 44 D-10 TOP FOR A DROP INLET
- 45 D-11 GRATES AND COVERS FOR DROP INLETS
- 46 D-13 CONCRETE CATCH BASINS
- 47 E-1 BARRICADES, SIGNS AND LIGHTS (ROADWAY)
- 48 E-3 REGULATORY SIGNS
- 49 E-4 ROUTE MARKERS AND AUXILIARY MARKERS
- 50 E-5 SIGN POST FOOTINGS
- 51 E-6 REGULATORY, WARNING AND GUIDE SIGNS
- 52 E-7 STANDARD SIGN PLACEMENT
- 53 E-8 DELINEATORS
- 54 E-9 CONSTRUCTION IDENTIFICATION SIGNS
- 55 F-1 PROPERTY LINE FENCE
- 56 G-1 STEEL BEAM GUARD RAIL
- 57 G-3 THREE CABLE GUARD RAIL
- 58 H-4 MARKER POSTS AND GUIDE POSTS
- 59 J-1 PROJECT MARKERS AND BOUNDARY MARKERS
- 60 J-3 MINIMUM PLANTING DISTANCES
- 61-114 CROSS SECTIONS

STATE OF VERMONT
DEPARTMENT OF HIGHWAYS

PROPOSED IMPROVEMENT
INTERSTATE PROJECT IN THE TOWNS OF
WESTMINSTER - ROCKINGHAM
COUNTY OF WINDHAM

PROJECT NO. 91-1(15)
CONTRACT NO. 4 Interstate Route I-91

BEGINNING 2.417 MILES NORTH OF THE WESTMINSTER-ROCKINGHAM
TOWN LINE AT STATION 1785+00 AND CONTINUING IN A NORTHERLY
DIRECTION 1.117 MILES TO STATION 1844+00

LENGTH OF ROADWAY = 5,900.00 FEET = 1.117 MILES
LENGTH OF CONTRACT = 5,900.00 FEET = 1.117 MILES

DESIGN DESIGNATION

ADT - 1960 = 2280
ADT - 1975 = 5060
DHV - 1975 = 715
T = 7%
D = 5.4%
V = (70) M.P.H.

SQUARE RAIL
MARKER POSTS
SIGNS & DELINEATORS
PROPERTY LINE FENCE
S.T. GRISWOLD CO., INC.
WILLISTON, VT.

CONTRACTOR: CALEDONIA SAND & GRAVEL CO., INC.
RESIDENT ENGINEER: SANFORD C. BRIGHAM
INSPECTOR: MARK W. REDMOND
RECORD PLANS: MARK W. REDMOND
CONTRACT DATED: 26 MARCH 1962
CONTRACT STARTED: 2 APRIL 1962
CONTRACT COMPLETED: 17 OCT. 63
CONTRACT ACCEPTED: 17 OCT. 63

PROJECT NAME & NUMBER	TYPE	PAVEMENT AREA
WESTMINSTER-ROCKINGHAM I 91-1(15)	3" BIT. CONCRETE	17,044 sq.

RECORD PLANS
MATERIALS

SUB-BASE OF GRAVEL - REED PIT, WESTMINSTER, VT.
SUB-BASE OF SAND - RAND PIT, ROCKINGHAM, VT.
FLAGSTONE - CALEDONIA SAND & GRAVEL, TOWN QUARRY, ROCKINGHAM, VT.
GRITS - PERINI CRUSHER - PARDA, GOLDSMITH, COTE - WESTMINSTER, VT.
TAR & ASPHALT - MOBIL OIL CO., E. PROVIDENCE, R. I.
DIT. CONCRETE - L. M. PINE D. SHEPHERD, CHARLESTOWN, N. H.
CONCRETE - CHARLESTOWN READY-MIX INC., CHARLESTOWN, N. H.
REINF. STEEL, FLUSHING BASINS, STEEL GRATES - VT. STRUCTURAL STEEL, BURL. VT.
REINF. CONCRETE PIPE - MARTIN MARIETTA CO., WINDSOR, VT.
A.C. C. G. METAL PIPE - N. E. METAL CULKERT CO., WHITE RIVER JCT., VT.
FRANITE CURB - BARRETTO - M. FORD, N. H.
TREES & SHRUBS - PUTNEY NURSERY, PUTNEY, VT.

PROJECT BEGIN PROJECT: 1785+00
191+00
STA 1844+00.00
N-217,567.89
E-52,168.29

CALEDONIA SAND & GRAVEL CO., INC.
ST. JOHNSBURY, VT.
CONTRACTOR: CALEDONIA SAND & GRAVEL CO., INC.
RESIDENT ENGINEER: SANFORD C. BRIGHAM
INSPECTOR: MARK W. REDMOND
RECORD PLANS: MARK W. REDMOND
CONTRACT DATED: 26 MARCH 1962
CONTRACT STARTED: 2 APRIL 1962
CONTRACT COMPLETED: 17 OCT. 63
CONTRACT ACCEPTED: 17 OCT. 63

WESTMINSTER-ROCKINGHAM I 91-1(15) CONTRACT NO. 4
CONTRACTOR: CALEDONIA SAND & GRAVEL CO., INC.
RESIDENT ENGINEER: SANFORD C. BRIGHAM
INSPECTOR: MARK W. REDMOND
RECORD PLANS: MARK W. REDMOND
CONTRACT DATED: 26 MARCH 1962
CONTRACT STARTED: 2 APRIL 1962
CONTRACT COMPLETED: 17 OCT. 63
CONTRACT ACCEPTED: 17 OCT. 63

POOR ORIGINAL COPY

SCALES
TITLE: 1" = 1000'
TYPICAL: AS NOTED
PLAN: 1" = 50'
PROFILE HORIZONTAL: 1" = 10'
PROFILE VERTICAL: 1" = 10'


CURVE DATA
DEFLECTION OF ANGLE
DEGREE OF CURVE
RADIUS OF CURVE
TANGENT DISTANCE
LENGTH OF CURVE
EXTERNAL DISTANCE
POINT OF INTERSECTION
POINT OF CURVE
POINT OF TANGENT
POINT ON TANGENT
POINT ON SUB-TANGENT
POST

APPROVED: [Signature] DATE: [Date]
APPROVED: [Signature] DATE: [Date]
APPROVED: [Signature] DATE: [Date]
APPROVED: [Signature] DATE: [Date]

THESE PLANS ARE SUBJECT TO SUCH REVISIONS AS MAY BE
REQUIRED BY THE BUREAU OF PUBLIC ROADS OR THE COMMISSIONER
OF HIGHWAYS
CONSTRUCTION IS TO BE CARRIED ON IN ACCORDANCE WITH
THE PLANS AND THE STANDARD SPECIFICATIONS FOR HIGHWAY AND BRIDGE
CONSTRUCTION OF VERMONT SUBMITTED TO THE BUREAU OF
PUBLIC ROADS AS APPROVED JULY 5, 1954, INCLUDING ALL SUBSEQUENT
APPROVED REVISIONS AND SUCH REVISED SPECIFICATIONS AND OTHER
PROVISIONS AS ARE FURNISHED WITH THE PLANS.

DEPARTMENT OF COMMERCE
BUREAU OF PUBLIC ROADS

PROJECT CONTRACT NO. 4 NO. I 91-1(15)
SHEET 1 OF 114 SHEETS

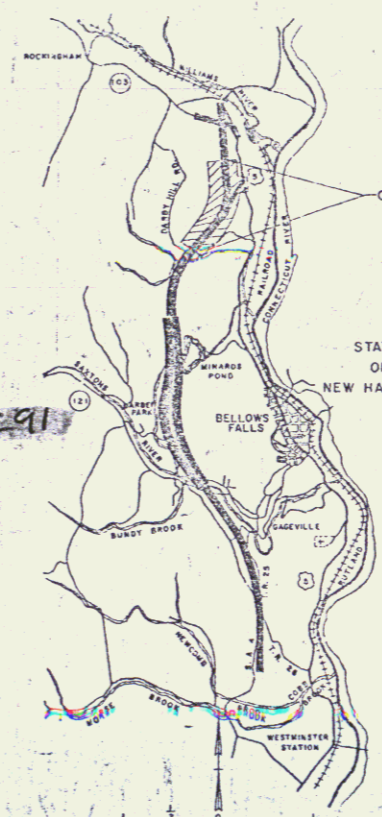

RIGHT-OF-WAY
and Construction Plans

STATE OF VERMONT
PROJECT NO. 91-1(15)
SHEET NO. 114

