


TRIPER CARLS ROAD RAIL
 DRILLING & BLASTING of SOLID ROCK
 SUBGRADE

1925+00-1926+00	1926+00-1927+00	1927+00-1928+00
1928+00-1929+00	1929+00-1930+00	1930+00-1931+00
1931+00-1932+00	1932+00-1933+00	1933+00-1934+00
1934+00-1935+00	1935+00-1936+00	1936+00-1937+00
1937+00-1938+00	1938+00-1939+00	1939+00-1940+00

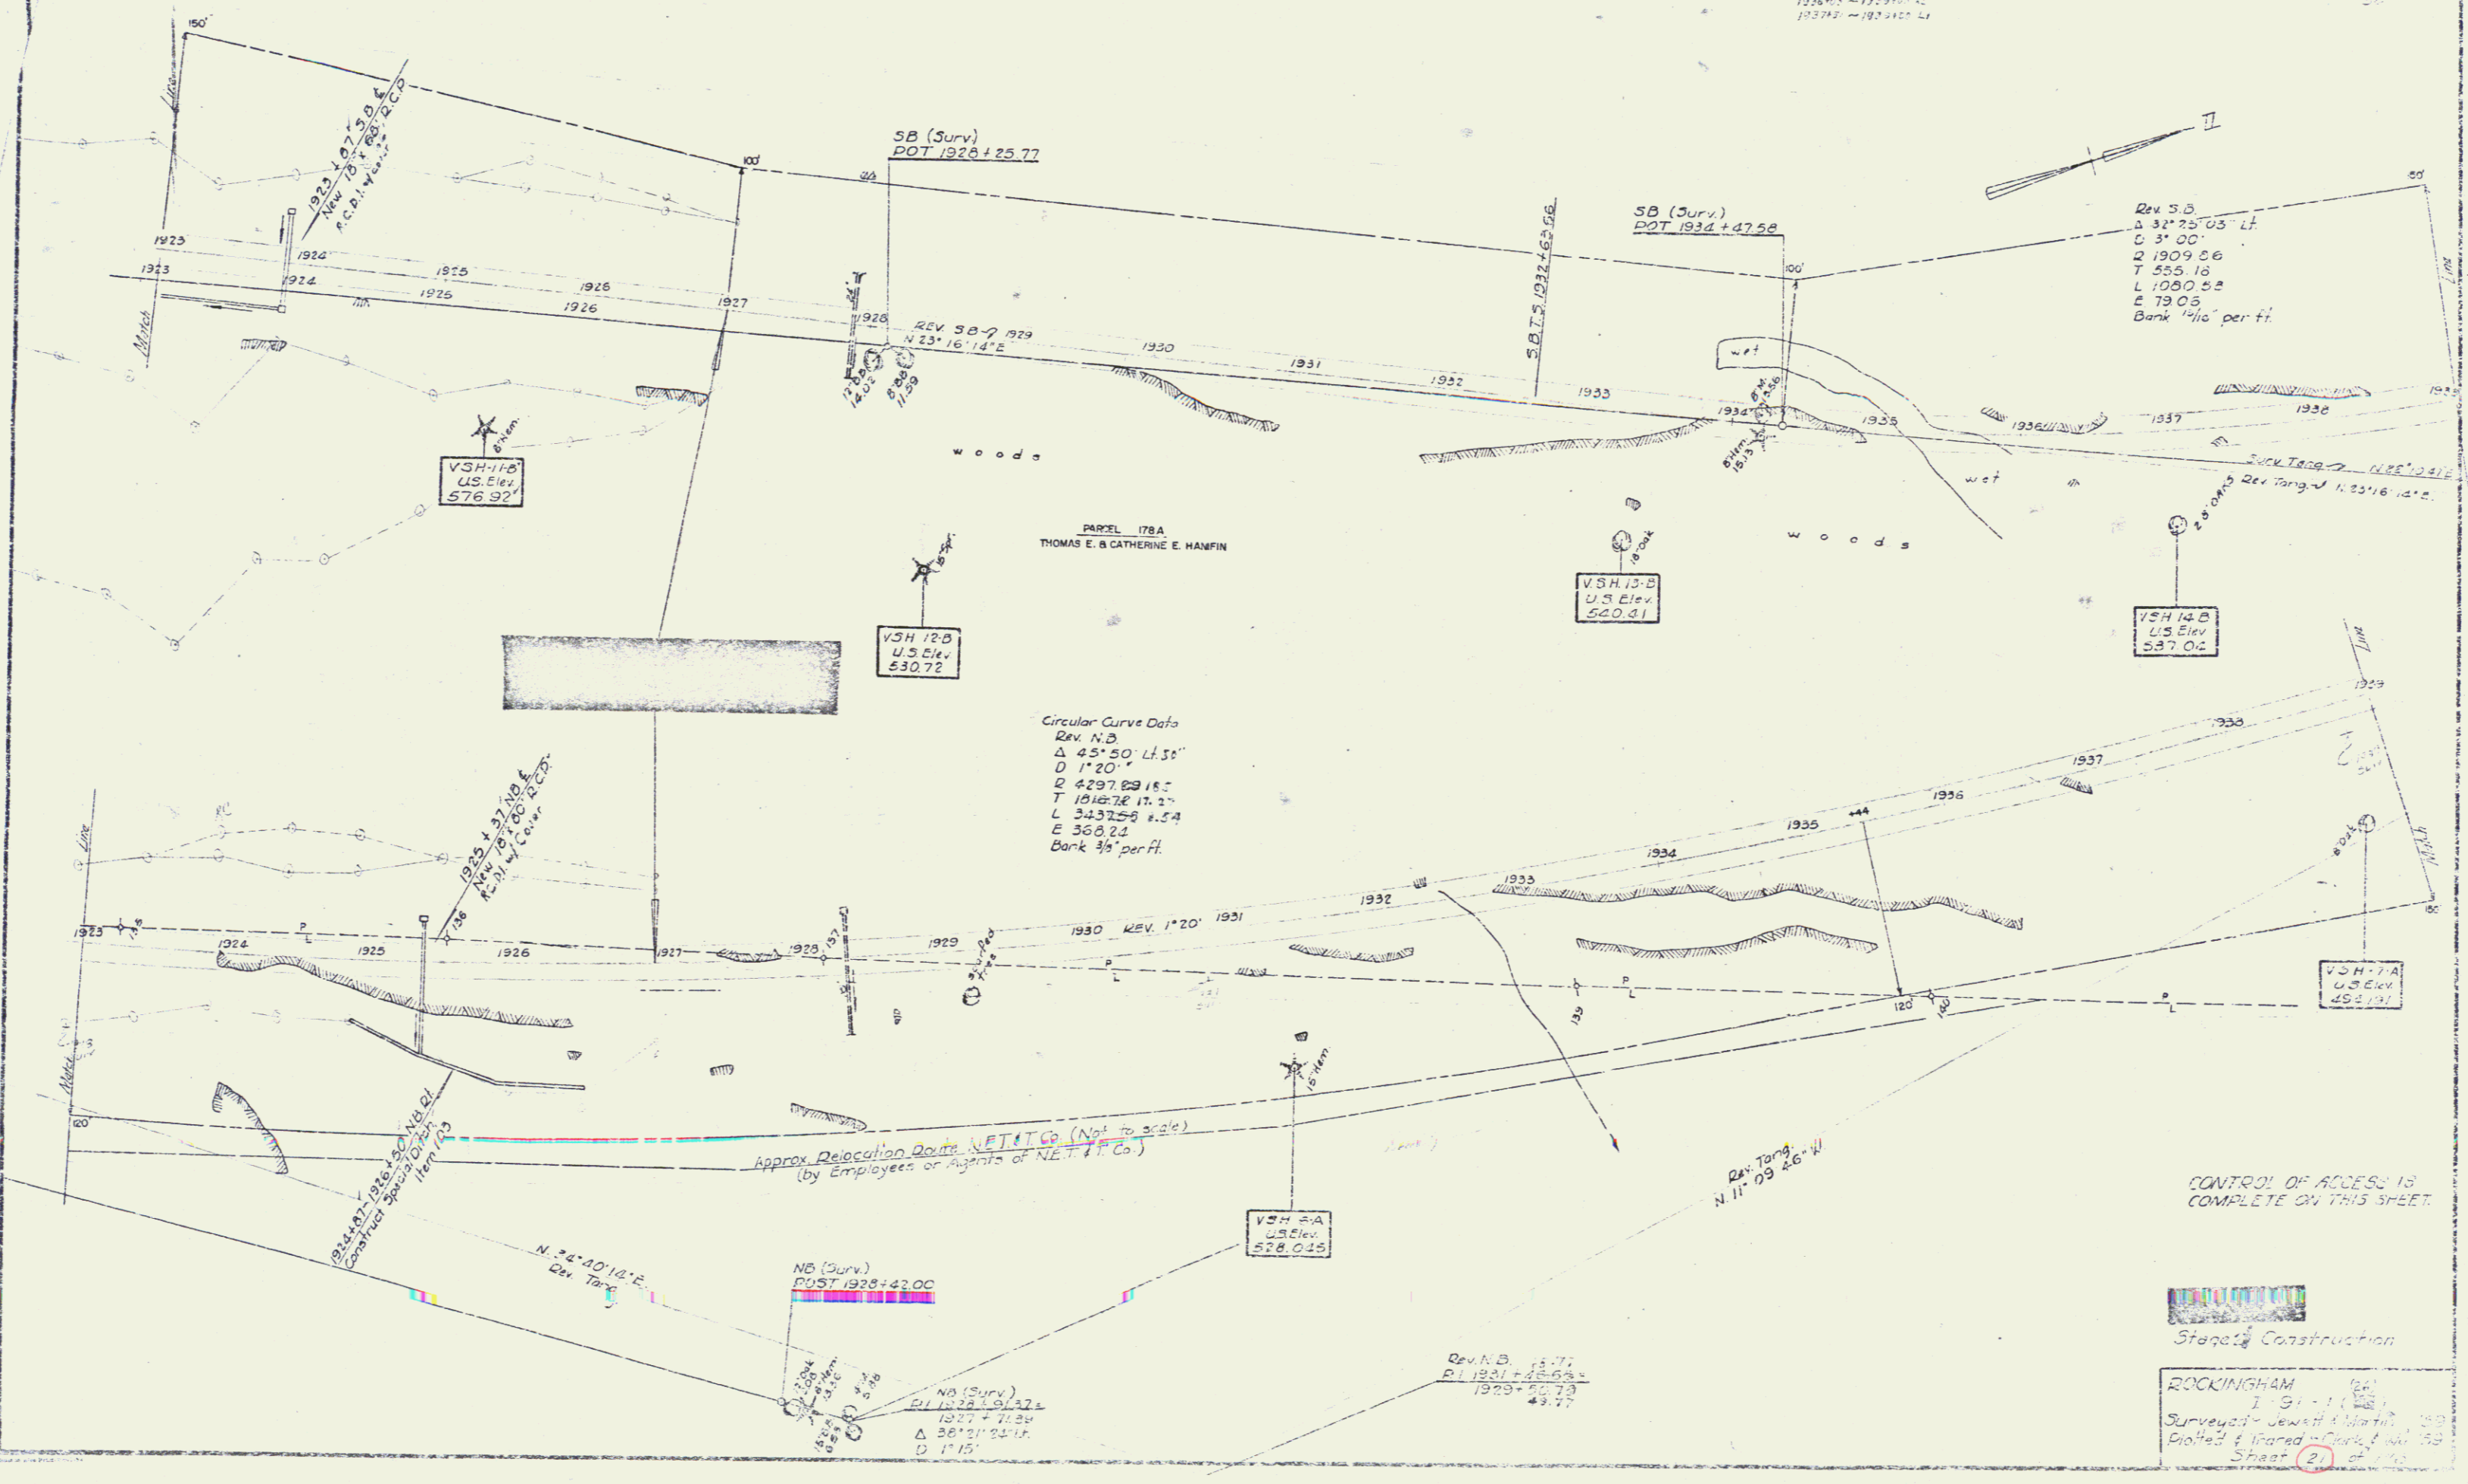

CONTROL OF ACCESS IS COMPLETE ON THIS SHEET.

Stages Construction

ROCKINGHAM
 I 91-1-1
 Surveyed by Jewett Martin
 Plotted & Inset by Carl Paul
 Sheet 21 of 22