


PLAN	DESIGNED BY	DATE
	W. J. ZIEGLER	10/1/50
	CHECKED BY	
	W. J. ZIEGLER	
	APPROVED BY	
	W. J. ZIEGLER	

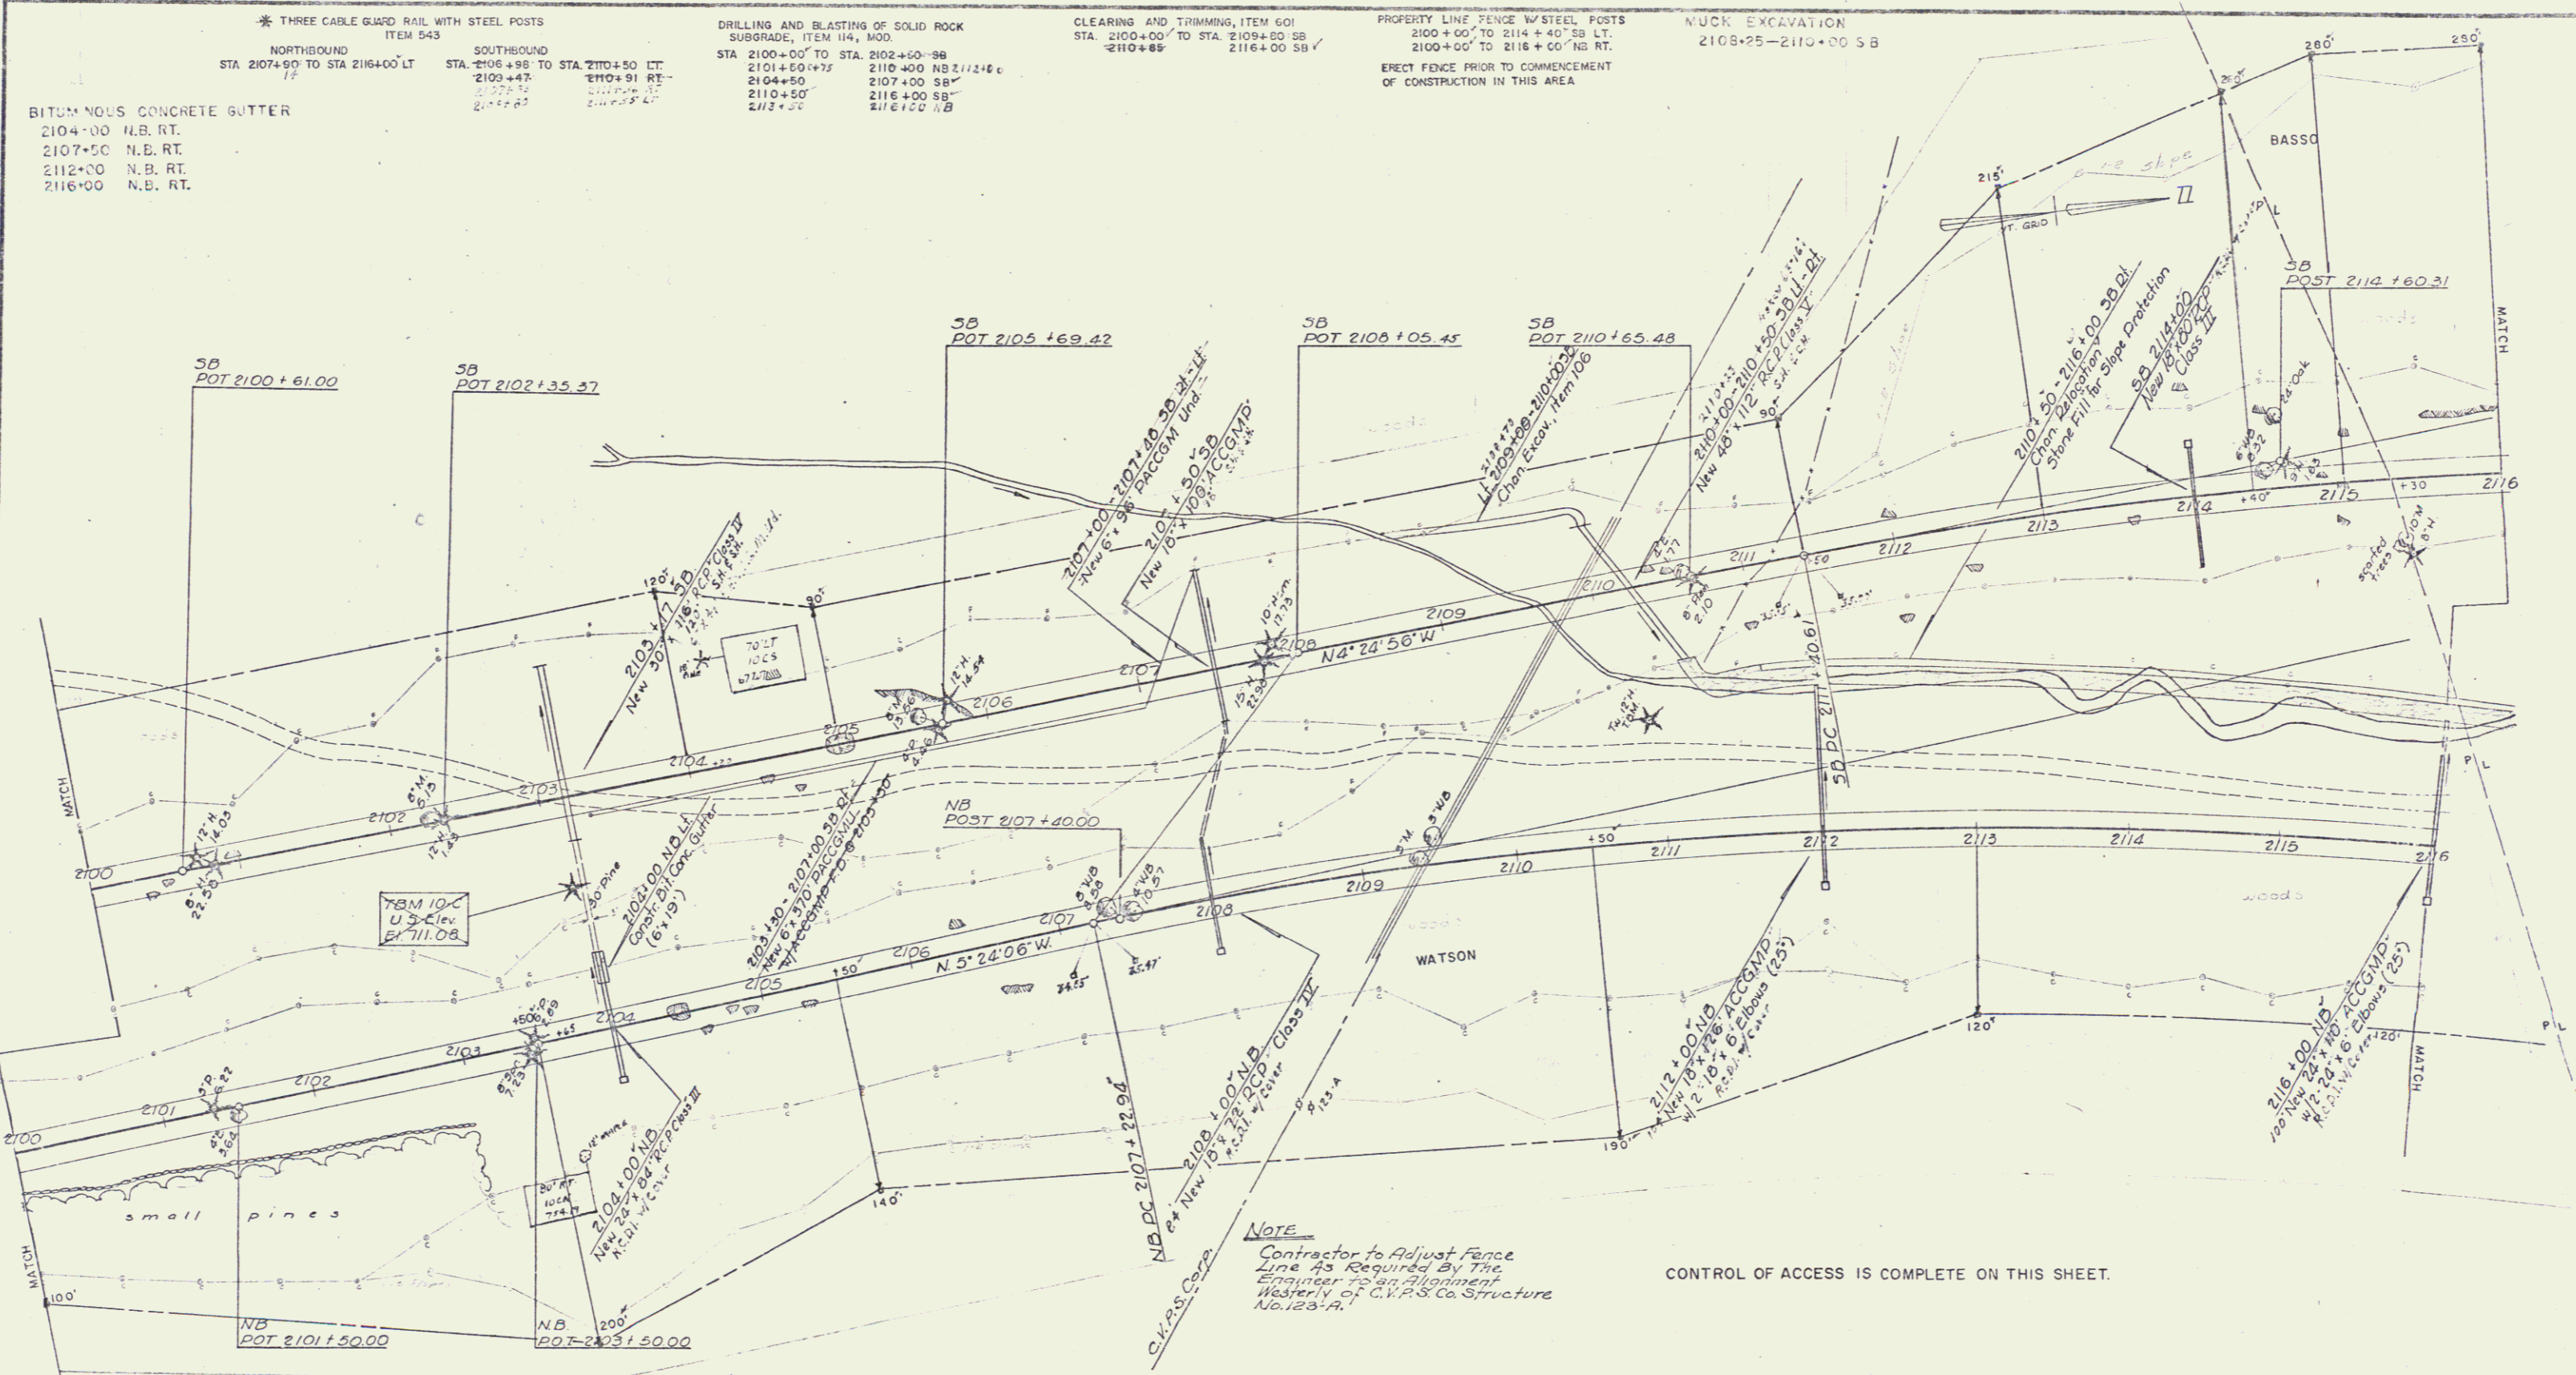

* THREE CABLE GUARD RAIL WITH STEEL POSTS
ITEM 543

NORTHBOUND STA 2107+90 TO STA 2116+00 LT
SOUTHBOUND STA 2108+98 TO STA 2110+50 LT
2103+47 2110+91 RT
2107+19 2110+40 RT
2107+67 2110+47

DRILLING AND BLASTING OF SOLID ROCK
SUBGRADE, ITEM 114, MOD.
STA 2100+00 TO STA 2102+50 SB
2101+50+75 2107+00 SB
2104+50 2107+00 SB
2110+50 2116+00 SB
2112+50 2116+00 SB

CLEARING AND TRIMMING, ITEM 601
STA 2100+00 TO STA 2109+80 SB
2110+85 2116+00 SB


PROPERTY LINE FENCE W/ STEEL POSTS
2100+00 TO 2114+40 SB LT.
2100+00 TO 2116+00 NB RT.
ERECT FENCE PRIOR TO COMMENCEMENT
OF CONSTRUCTION IN THIS AREA.

MUCK EXCAVATION
2108+25-2110+00 SB

BITUMINOUS CONCRETE GUTTER
2104+00 N.B. RT.
2107+50 N.B. RT.
2112+00 N.B. RT.
2116+00 N.B. RT.

CONTROL OF ACCESS IS COMPLETE ON THIS SHEET.

* THESE ITEMS ARE STAGE 2 CONSTRUCTION

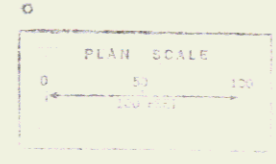

STAGE 2 CONSTRUCTION
SPRINGFIELD
Proj 191-10 (1950)
Sheet 41 of 557