

DRILLING AND BLASTING OF SOLID ROCK SUBGRADE, ITEM 114 MOD.
 STA. 2116+00 TO STA. 2122+00 SB
 2116+50 2130+00 NB
 2117+10

CLEARING AND TRIMMING, ITEM 601
 STA 2116+00 TO STA. 2132+00 SB
 2116+00-2117+03 NB RT
 ERECT FENCE PRIOR TO COMMENCEMENT OF CONSTRUCTION IN THIS AREA


* BITUMINOUS CONCRETE CURB, ITEM 555
 STA 2122+25 TO STA 2127+00 RT SB
 STA 2127+50 TO STA 2132+00 RT SB

MUCK EXCAVATION
 2120+00-2132+00 SB

* THREE CABLE GUARD RAIL WITH STEEL POSTS, ITEM 543
 NORTHBOUND STA 2116+00 TO STA 2119+80 LT.
 SOUTHBOUND STA 2121+56 TO STA. 2125+04 RT
 2124+80 2131+80 LT.
 9.12 9.12

BITUMINOUS CONCRETE GUTTER
 2120+00 N.B. RT.
 2123+50 N.B. RT.
 2127+00 N.B. RT.
 2127+25 S.B. RT.
 2127+50 N.B. LT.

PLAN	DATE	BY	CHKD.
REVISED			
ADDITIONAL WORK			
REVISIONS			
NO.			

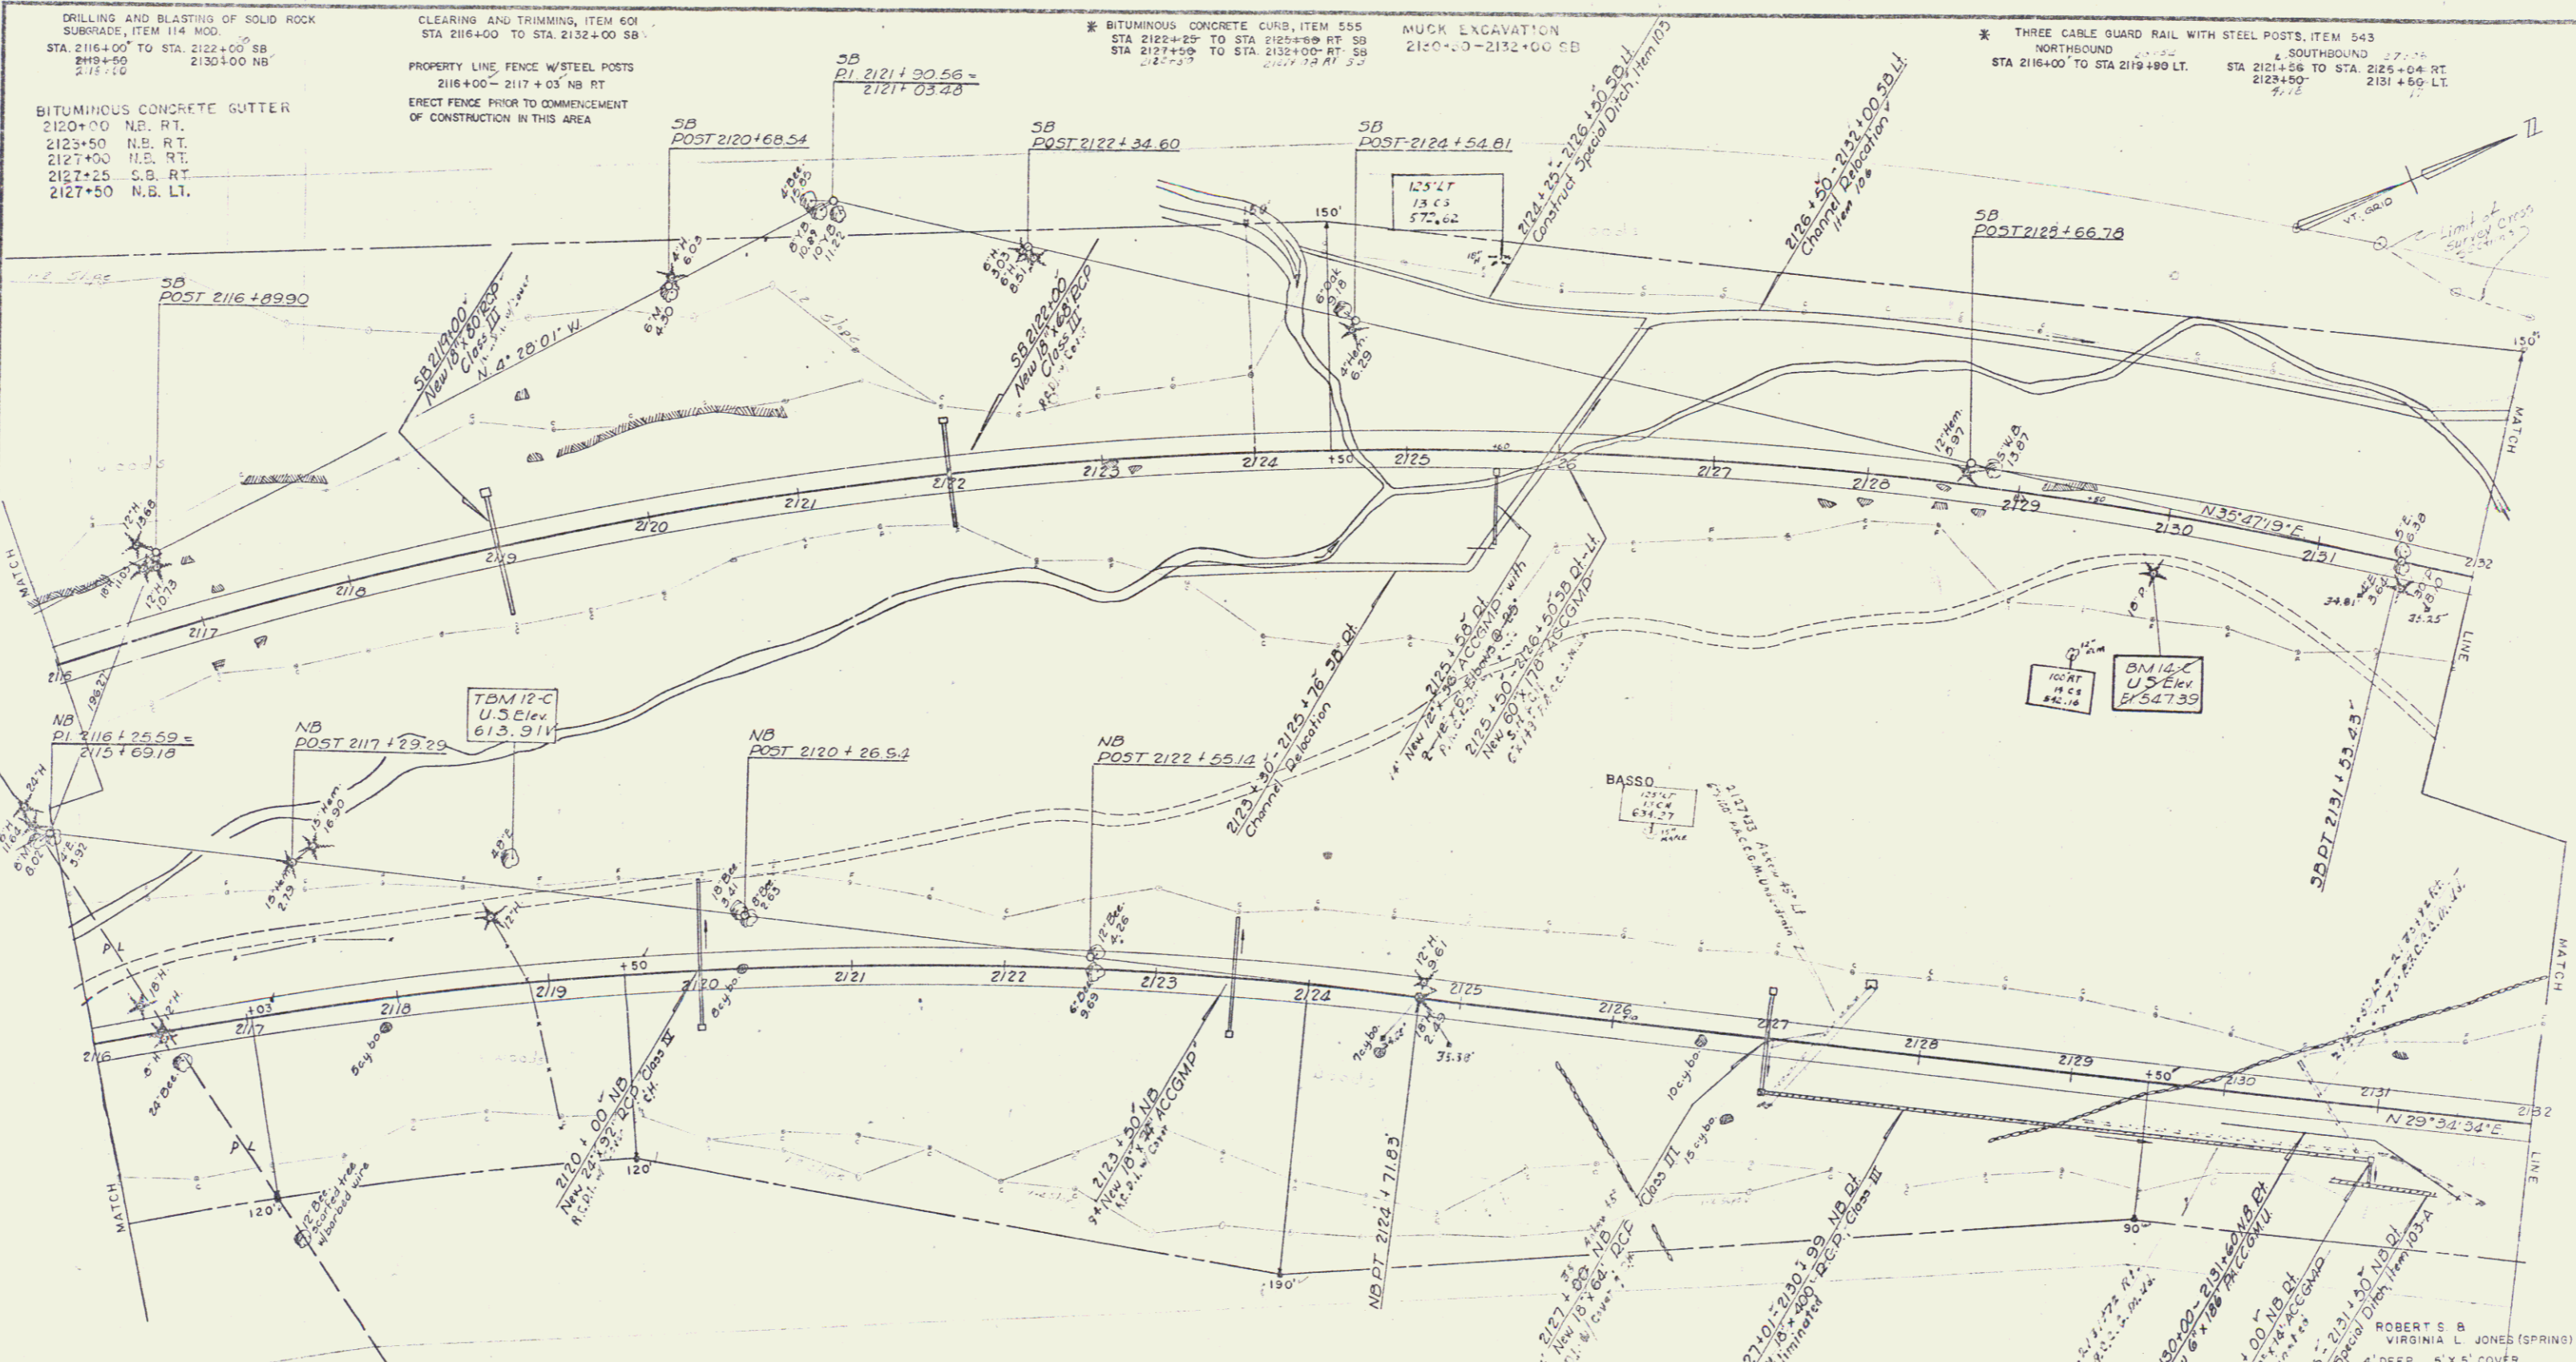


Northbound
 Δ 31° 58' 20" Rt.
 D 2'
 R 2864.73'
 T 902.65'
 L 1748.69'
 E 138.84'
 bank 1/2" per foot

Southbound
 Δ 40° 15' 20" Rt.
 D 2'
 R 2864.75'
 T 1049.95'
 L 2012.82'
 E 186.34'
 bank 1/2" per foot

PARCEL GRANTOR	196	STA. 2114+40 SBL - 2140+58 NBL
TAKING RIGHTS	EDMUND & ALICE W. BASSO	
DRAINAGE	40.2 AC LA 598.42	2131+50 RT
TITLE TAKEN	WD - 10-30-63	
RECORDED	SPRINGFIELD 5	929 VOL. 11-12-63

CONTROL OF ACCESS IS COMPLETE ON THIS SHEET.

* THESE ITEMS ARE STAGE 2 CONSTRUCTION

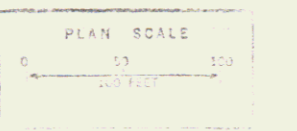

STAGE 2 CONSTRUCTION
 SPRINGFIELD
 I 91-1 (136)
 Sheet 43 of 357