


PLAN	REV	BY	DATE
1		LOWEY	10/20/83
2		LOWEY	11/15/83
3		LOWEY	12/15/83
4		LOWEY	1/15/84
5		LOWEY	2/15/84
6		LOWEY	3/15/84
7		LOWEY	4/15/84
8		LOWEY	5/15/84
9		LOWEY	6/15/84
10		LOWEY	7/15/84
11		LOWEY	8/15/84
12		LOWEY	9/15/84
13		LOWEY	10/15/84
14		LOWEY	11/15/84
15		LOWEY	12/15/84
16		LOWEY	1/15/85
17		LOWEY	2/15/85
18		LOWEY	3/15/85
19		LOWEY	4/15/85
20		LOWEY	5/15/85
21		LOWEY	6/15/85
22		LOWEY	7/15/85
23		LOWEY	8/15/85
24		LOWEY	9/15/85
25		LOWEY	10/15/85
26		LOWEY	11/15/85
27		LOWEY	12/15/85
28		LOWEY	1/15/86
29		LOWEY	2/15/86
30		LOWEY	3/15/86
31		LOWEY	4/15/86
32		LOWEY	5/15/86
33		LOWEY	6/15/86
34		LOWEY	7/15/86
35		LOWEY	8/15/86
36		LOWEY	9/15/86
37		LOWEY	10/15/86
38		LOWEY	11/15/86
39		LOWEY	12/15/86
40		LOWEY	1/15/87
41		LOWEY	2/15/87
42		LOWEY	3/15/87
43		LOWEY	4/15/87
44		LOWEY	5/15/87
45		LOWEY	6/15/87
46		LOWEY	7/15/87
47		LOWEY	8/15/87
48		LOWEY	9/15/87
49		LOWEY	10/15/87
50		LOWEY	11/15/87
51		LOWEY	12/15/87
52		LOWEY	1/15/88
53		LOWEY	2/15/88
54		LOWEY	3/15/88
55		LOWEY	4/15/88
56		LOWEY	5/15/88
57		LOWEY	6/15/88
58		LOWEY	7/15/88
59		LOWEY	8/15/88
60		LOWEY	9/15/88
61		LOWEY	10/15/88
62		LOWEY	11/15/88
63		LOWEY	12/15/88
64		LOWEY	1/15/89
65		LOWEY	2/15/89
66		LOWEY	3/15/89
67		LOWEY	4/15/89
68		LOWEY	5/15/89
69		LOWEY	6/15/89
70		LOWEY	7/15/89
71		LOWEY	8/15/89
72		LOWEY	9/15/89
73		LOWEY	10/15/89
74		LOWEY	11/15/89
75		LOWEY	12/15/89
76		LOWEY	1/15/90
77		LOWEY	2/15/90
78		LOWEY	3/15/90
79		LOWEY	4/15/90
80		LOWEY	5/15/90
81		LOWEY	6/15/90
82		LOWEY	7/15/90
83		LOWEY	8/15/90
84		LOWEY	9/15/90
85		LOWEY	10/15/90
86		LOWEY	11/15/90
87		LOWEY	12/15/90
88		LOWEY	1/15/91
89		LOWEY	2/15/91
90		LOWEY	3/15/91
91		LOWEY	4/15/91
92		LOWEY	5/15/91
93		LOWEY	6/15/91
94		LOWEY	7/15/91
95		LOWEY	8/15/91
96		LOWEY	9/15/91
97		LOWEY	10/15/91
98		LOWEY	11/15/91
99		LOWEY	12/15/91
100		LOWEY	1/15/92

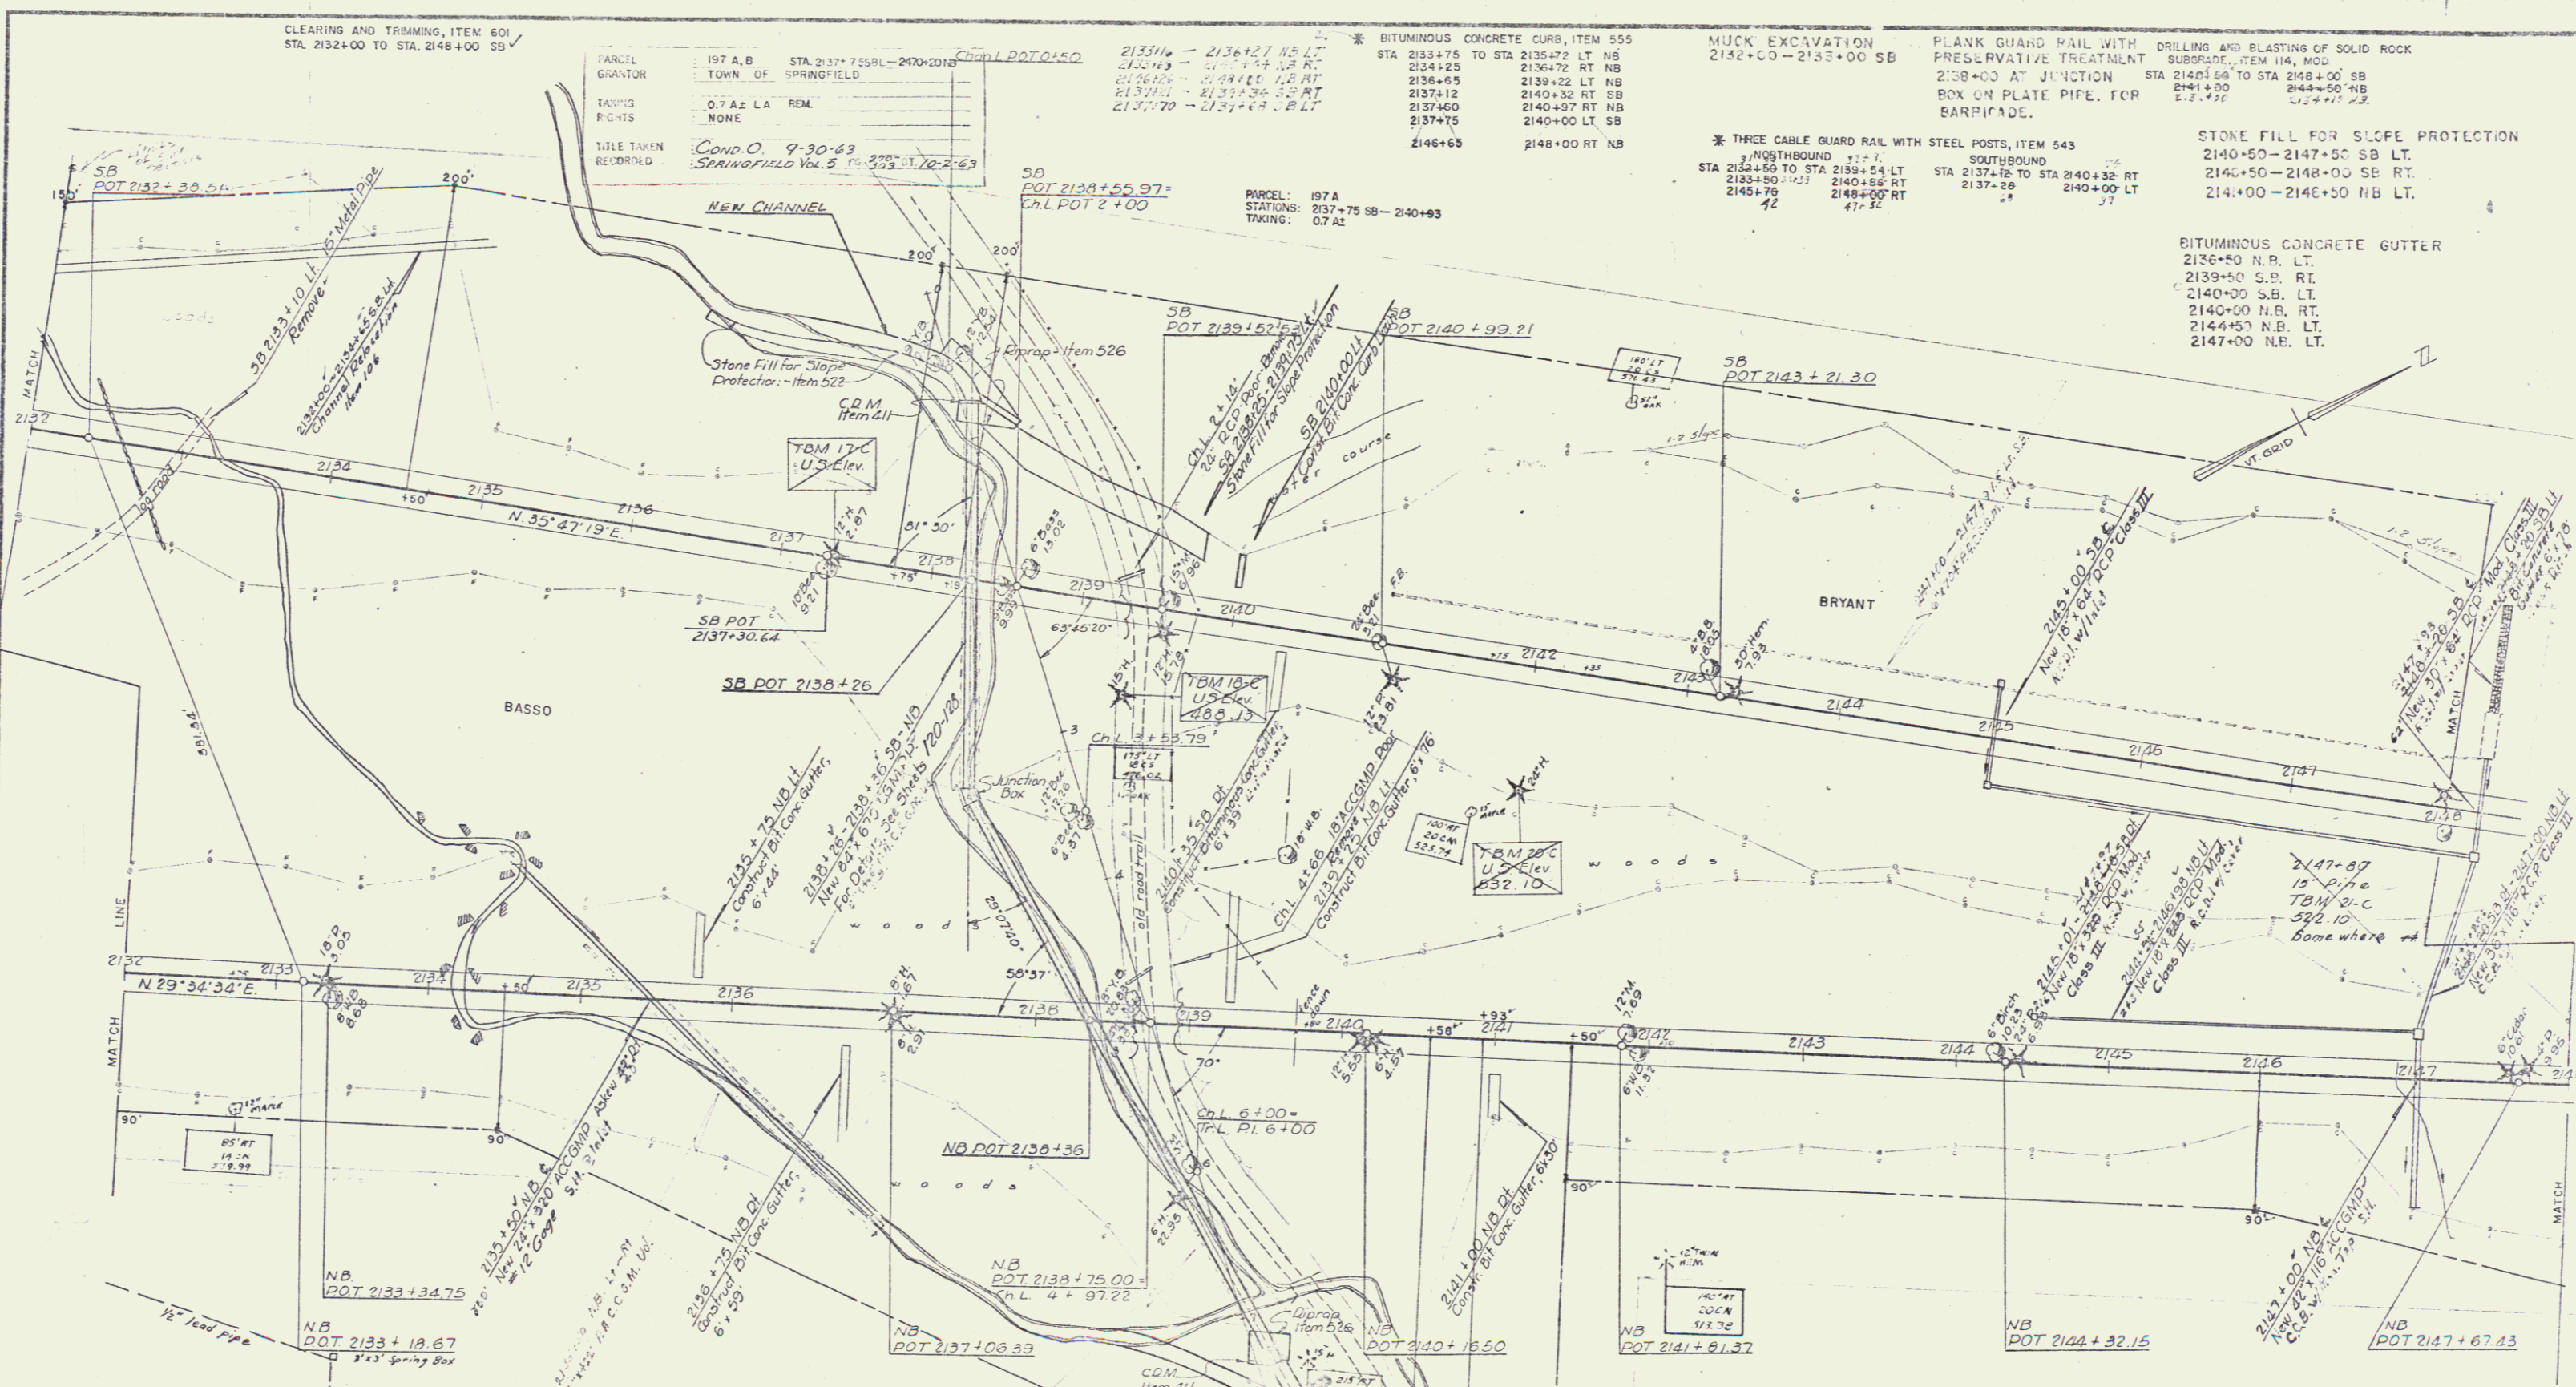

CLEARING AND TRIMMING, ITEM 601
STA. 2132+00 TO STA. 2148+00 SB

PARCEL	197 A, B	STA. 2137+75 RL - 2470+20 RL
TOWN OF	SPRINGFIELD	
TAXING RIGHTS	0.7 AC LA REM.	
TITLE TAKEN RECORDED	COND. O. 9-30-83	SPRINGFIELD VOL. 5 P. 378

ITEM	2133+16 - 2136+27 NB LT	* BITUMINOUS CONCRETE CURB, ITEM 555
STA.	2133+75 TO STA. 2135+72 LT NB	STA. 2133+75 TO STA. 2135+72 LT NB
ITEM	2136+28 - 2139+11 NB RT	2136+25 2136+72 RT NB
STA.	2136+25 TO STA. 2139+11 NB RT	2139+22 LT NB
ITEM	2139+12 - 2141+13 NB RT	2137+12 2140+32 RT SB
STA.	2139+12 TO STA. 2141+13 NB RT	2137+40 2140+97 RT NB
ITEM	2141+14 - 2143+15 NB RT	2137+75 2140+00 LT SB
STA.	2141+14 TO STA. 2143+15 NB RT	2146+65 2148+00 RT NB

MUCK EXCAVATION
2152+00 - 2155+00 SB


PLANK GUARD RAIL WITH PRESERVATIVE TREATMENT
2138+00 AT JUNCTION STA. 2141+00 TO STA. 2144+00 SB

STONE FILL FOR SLOPE PROTECTION
2140+50 - 2147+50 SB LT.
2140+50 - 2148+00 SB RT.
2140+00 - 2146+50 NB LT.

BITUMINOUS CONCRETE GUTTER
2136+50 N.B. LT.
2139+50 S.B. RT.
2140+00 S.B. LT.
2140+00 N.B. RT.
2144+50 N.B. LT.
2147+00 N.B. LT.

CONTROL OF ACCESS IS COMPLETE ON THIS SHEET.

* THESE ITEMS ARE STAGE 2 CONSTRUCTION

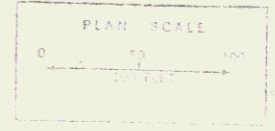

STAGE 2 CONSTRUCTION
SPRINGFIELD
PROJ. 91-11 (26)
Sheet 45 of 50
GRAVEL BROOK