

PLAN
 DRAWN BY
 CHECKED BY
 DATE
 NO.

DRILLING AND BLASTING OF SOLID ROCK SUBGRADE, ITEM 114, MOD. STA 2148+00 TO STA 2162+50 SB 2155+00' 2164+50 NB 6'+0"


CLEARING AND TRIMMING, ITEM 501 STA 2144+00 TO STA 2154+00 SB'

THREE CABLE GUARD RAIL WITH STEEL POSTS, ITEM 543 NORTHBOUND STA 2148+00 TO STA 2149+76 RT 2163+34 2164+00 RT LT 2148+76 2149+76

BITUMINOUS CONCRETE CUTTER STA 2149+50 N.B. RT 2153+50 S.B. RT 2159+50 N.E. RT 2159+50 N.W. LT 2163+50 N.B. MET. 2164+00 S.B. LT.

BITUMINOUS CONCRETE CURB, ITEM 558 STA. 2163+34 TO 2164+00 RT NB 2148+00'


PROPERTY LINE FENCE WITH STEEL POSTS 2155+50 - 2164+00 NP RT 2161+50 - 2164+00 SB LT

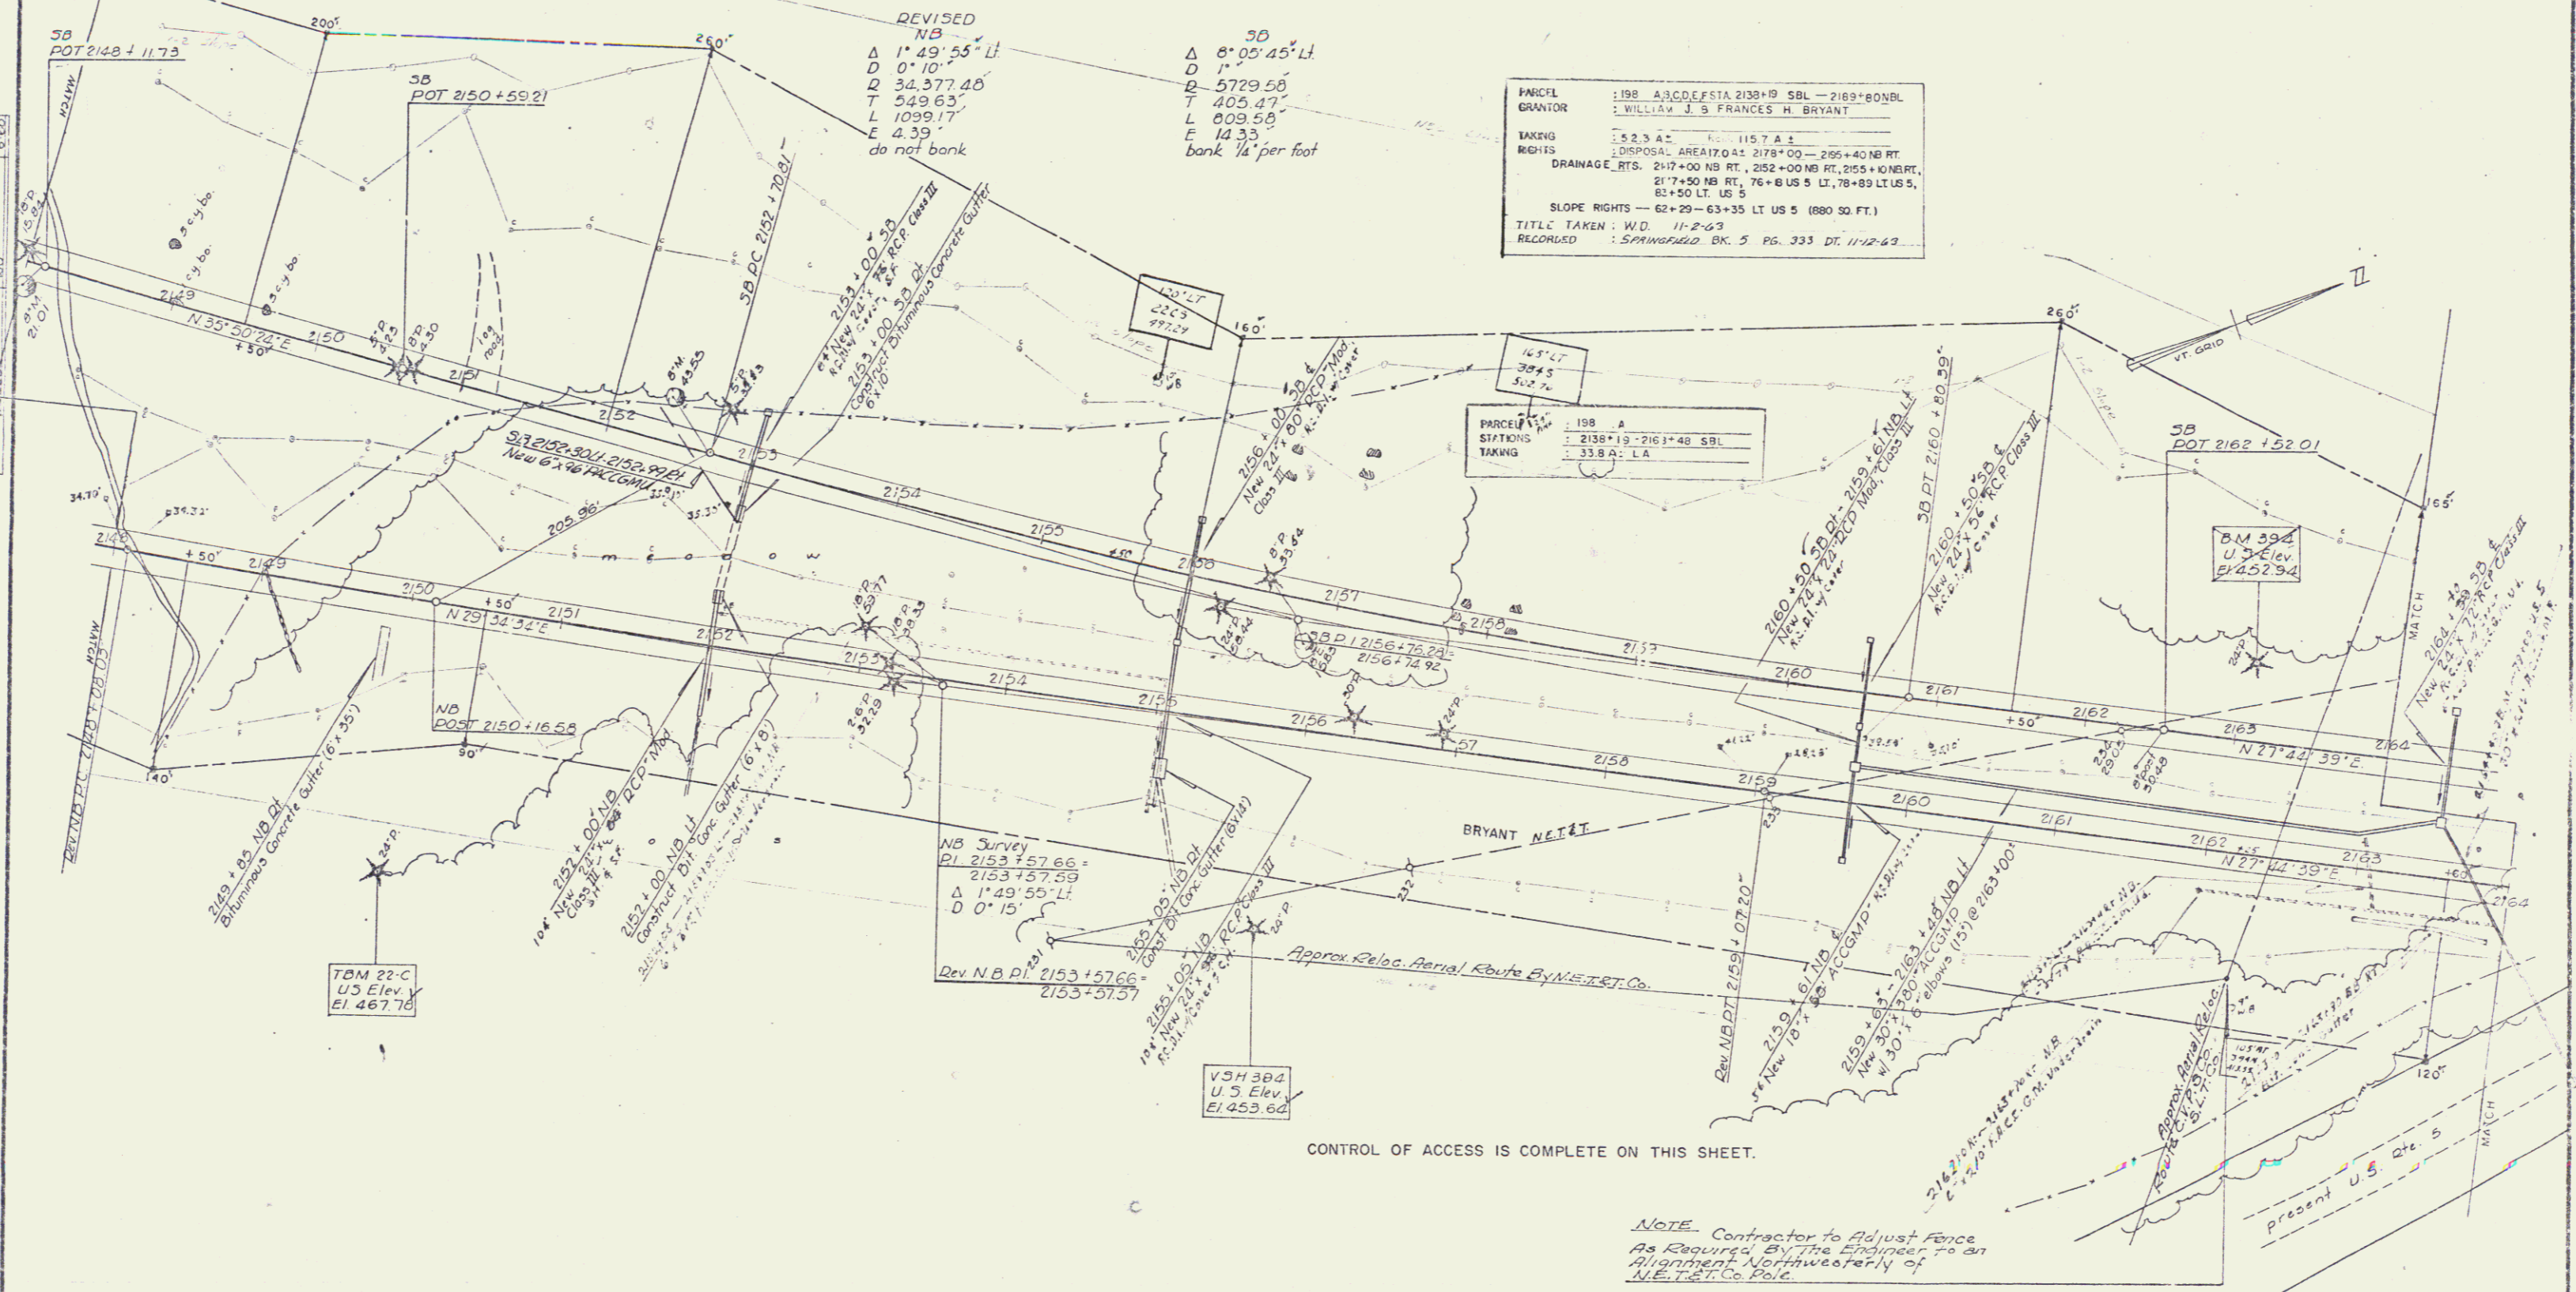

CONTROL OF ACCESS IS COMPLETE ON THIS SHEET.

NOTE: Contractor to Adjust Fence As Required By The Engineer To an Alignment Northwesterly of N.E.T. Co. Pole.

* THESE ITEMS ARE STAGE 2 CONSTRUCTION

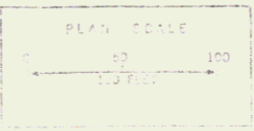

STAGE 2 CONSTRUCTION
 SPRINGFIELD
 Proj. I-91 (123)
 Sheet 47 of 307