

MUCK, EXCAVATION, ITEM 116  
 STA 2174+00 TO STA 2179+00 NB  
 2174+00 2179+00 SB

BITUMINOUS CONCRETE CURB, ITEM 555  
 STA 2166+12 TO STA 2174+00 RT NB  
 STA 2164+00 TO STA 2165+50 RT NB  
 STA 2174+91.3 TO STA 2175+16 LT SB  
 STA 2178+30 TO STA 2179+00 LT SB

SUB-BASE OF GRAVEL, ITEM 201-A, MOD  
 STA 2177+50 TO STA 2179+00 NB  
 2174+00 2179+00 SB

PROPERTY LINE FENCE WITH STEEL POSTS  
 ITEM 583-B  
 STA 2164+00 TO STA 2167+77 SB  
 2164+00 2165+70 NB  
 2168+08.9 2170+00 SB  
 2173+53 2175+50 SB  
 2167+57 2170+00 A.C.R.

THREE CABLE GUARD RAIL WITH STEEL POSTS, ITEM 543  
 # NORTHBOUND  
 STA 2164+00 TO STA 2165+50 RT  
 2165+64.1 2165+83 MED  
 2168+19.7 2179+00 RT  
 2168+45 - 2175+12 MED

BITUMINOUS CONCRETE GUTTER  
 2155+50 N.B. MED.  
 2174+75 N.B. Y' PAVT.-MED.  
 2174+75 S.B. Y' PAVT.-MED.  
 2175+0-2177+0 N.B. MED.  
 2177+50 S.B. LT.

STONE FILL FOR SLOPE PROTECTION, ITEM 522  
 STA 2177+50 TO STA 2179+00 RT. NB

PARCEL : 198 D  
 STATIONS : 63+57 - 75+10 U.S.  
 TAKING : 1.9 A\*

PARCEL : 198 B  
 STATIONS : 2176+90 - 2177+10 S.B.L.  
 TAKING : 840. SQ. FT.

PARCEL : 198 F  
 STATIONS : 2175+05 - 2176+97 S.B.L.  
 TAKING : 4560. SQ. FT.

PARCEL : 198 A, B STA. 2176+90 - 2180+22  
 OWNER : GLADYS D. WYMAN  
 TAKING : 0.3 AC. REM. 1.2 AC.  
 RIGHTS : SPRING - 2175+20 RT. SB  
 DATE TAKEN : COND. 9-90-69  
 RELATION : SPRINGFIELD Vol. 5, P. 265, DT. 10-2-69

PARCEL : 198 A  
 STATIONS : 2177+66 - 2180+22 S.B.L. LA.  
 TAKING : 0.3 A.S. LA.


PLAN  
 REVISIONS  
 DATE  
 BY  
 CHECKED  
 NO. OF SHEETS  
 NO. OF PARCELS  
 NO. OF STATIONS  
 NO. OF POINTS

CONTROL OF ACCESS IS COMPLETE ON THIS SHEET.  
 ALL CLEARING & GRUBBING WILL BE DONE BY ROADWAY CONTRACTOR

DRILLING & BLASTING OF SOLID  
 ROCK SUBGRADE  
 U.S. RTE. 5.  
 72+96 - 74+79

STANDARD STEEL BEAM GUARD RAIL W/STEEL POSTS  
 U.S. 5  
 STA. 74+78 LT. TO STA. 76+67 LT.  
 75+00 77+00

\* THESE ITEMS ARE STAGE 2 ITEMS  
 U.S. 5 RELOCATION TO BE BUILT IN ITS ENTIRETY  
 DURING STAGE 1 CONSTRUCTION

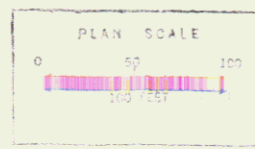

STAGE 2 CONSTRUCTION  
 SPRINGFIELD  
 Proj. I 91-1-10-268  
 Sheet 29 of 37  
 8/2/89