
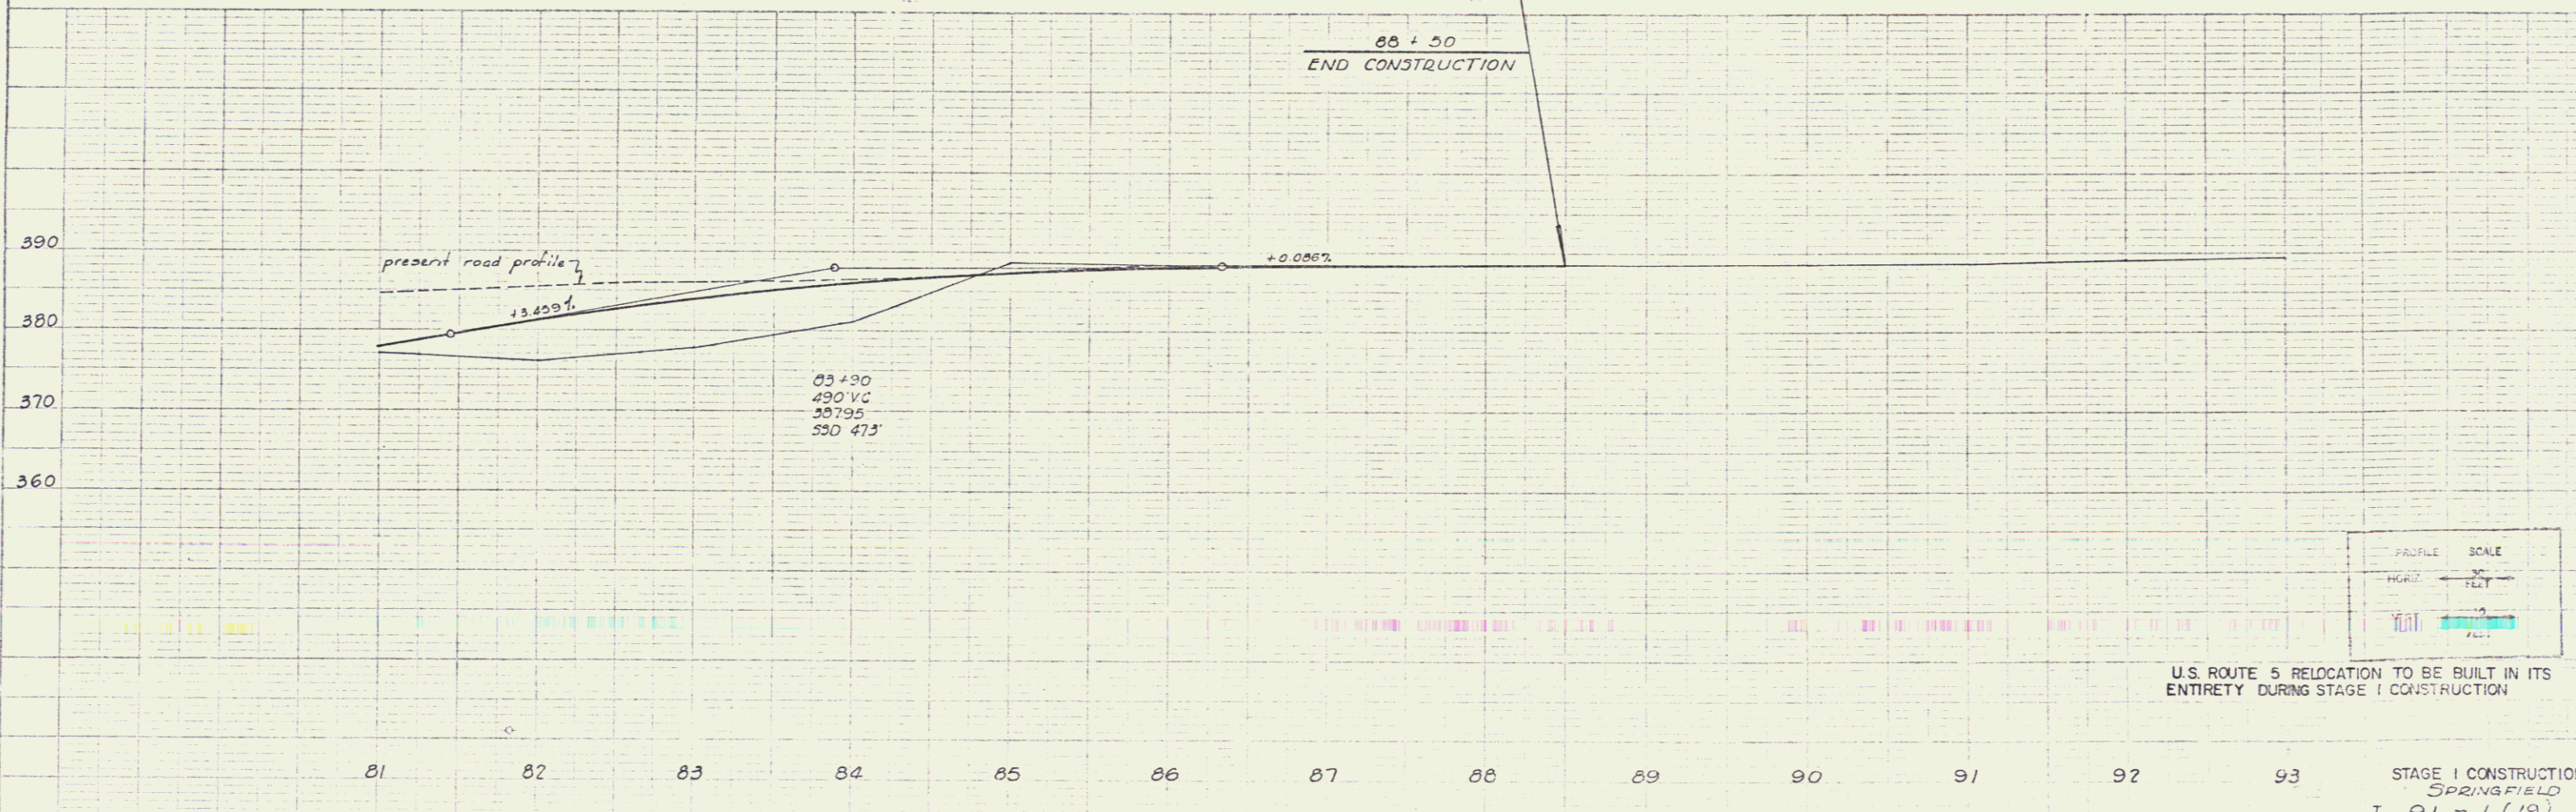


PLAN
 8-60
 Martin
 1412
 9-60

PROFILE
 8-60
 Sigfroy
 1412

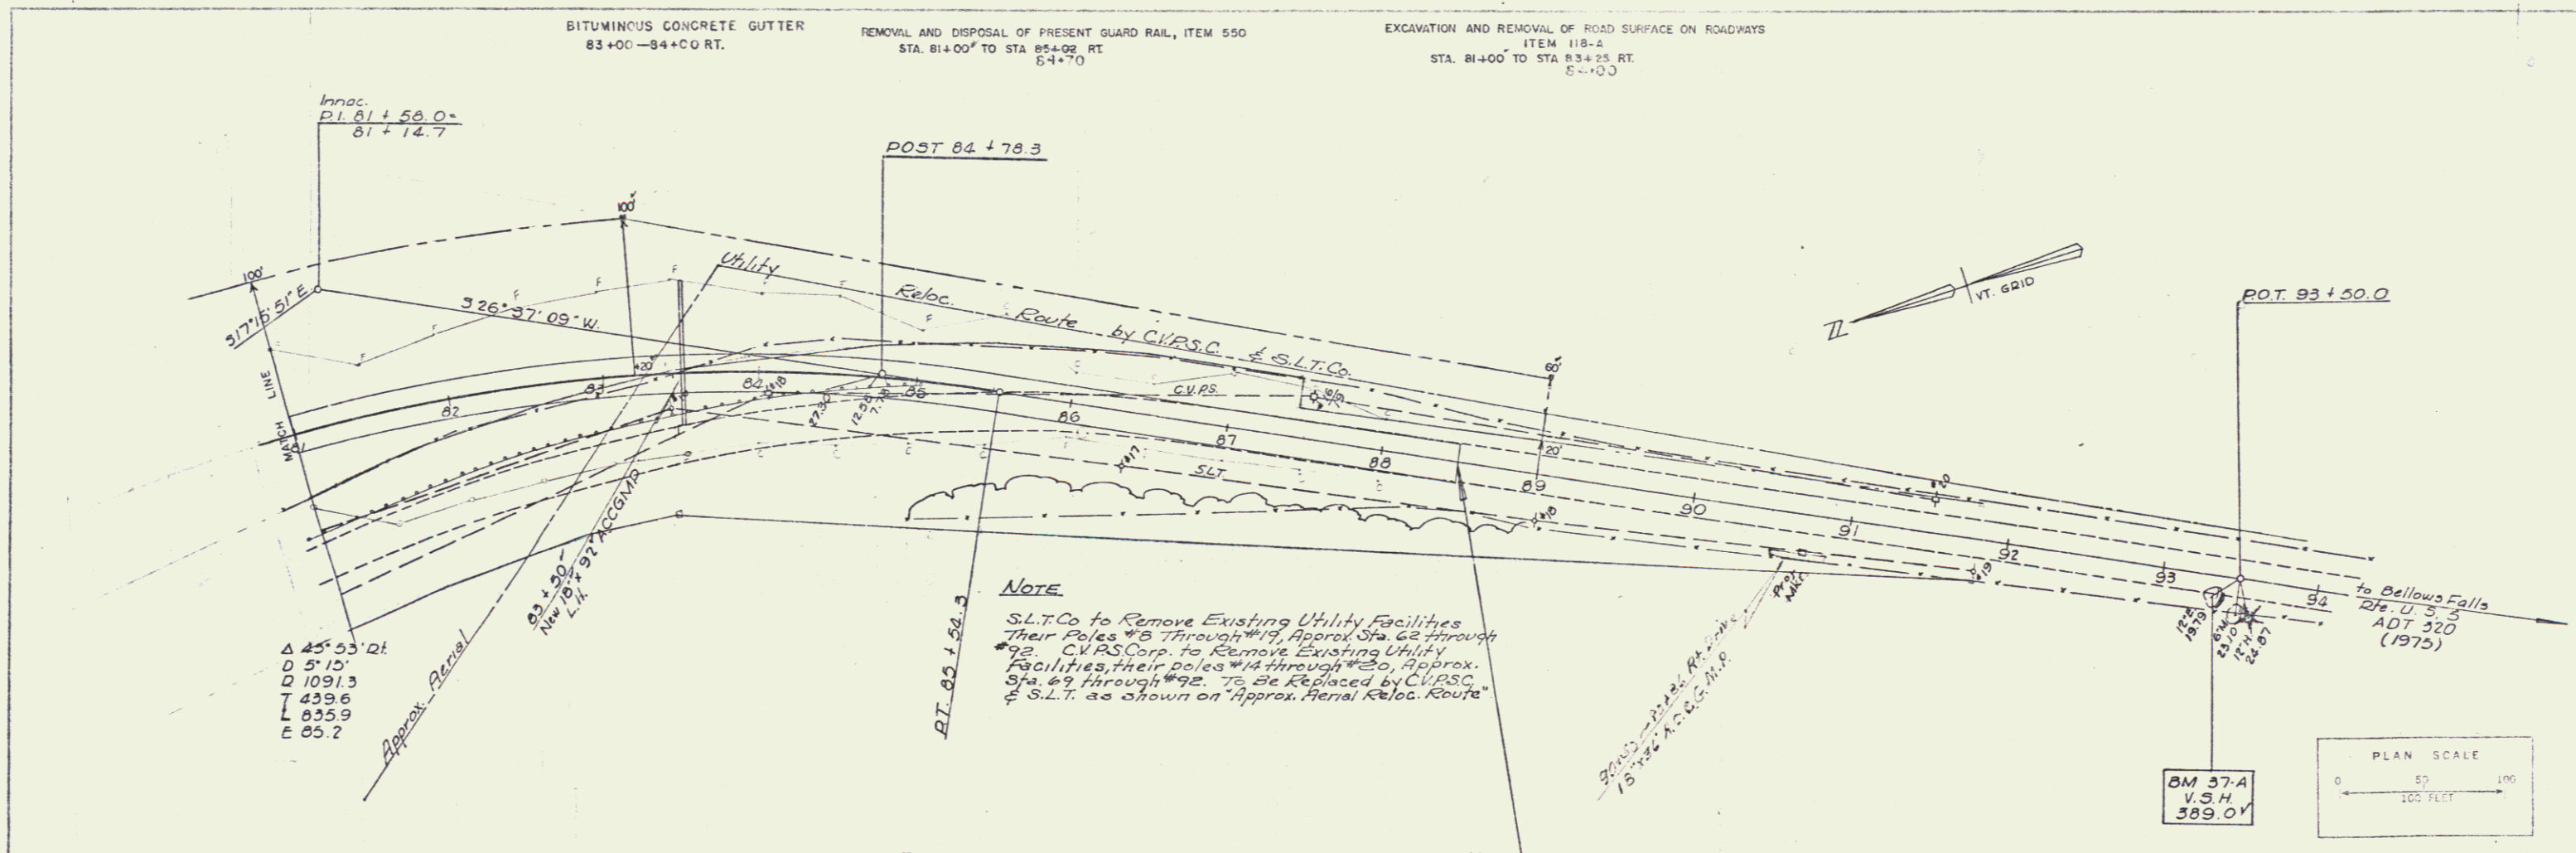

U.S. ROUTE 5 RELOCATION TO BE BUILT IN ITS ENTIRETY DURING STAGE I CONSTRUCTION

STAGE I CONSTRUCTION
 SPRINGFIELD
 I 91-1 (19)
 U.S. Route 5 Relocation
 Sheet 54 of 307