

\* BITUMINOUS CONCRETE CURB, ITEM 555  
 STA 2179+00 TO STA 2185+52 RT NB ✓  
 2179+00 2184+00 LT SB ✓

MUCK EXCAVATION, ITEM 116  
 STA 2179+00 TO STA 2187+00 NB  
 2179+00 2187+00 SB

SUB-BASE OF GRAVEL, ITEM 201-A MOD  
 STA 2179+00 TO STA 2187+00 NB ✓  
 2179+00 2187+00 NB ✓


\* THREE CABLE GUARD RAIL WITH STEEL POSTS, ITEM 543  
 NORTHBOUND  
 STA 2179+00 TO STA 2187+00 RT ✓  
 SOUTHBOUND  
 STA 2179+00 TO STA 2187+00 LT ✓

STONE FILL FOR SLOPE PROTECTION, ITEM 522  
 STA 2179+00 TO STA 2187+00 RT NB ✓  
 2180+50 2187+00 LT SB ✓

BITUMINOUS CONCRETE GUTTER  
 2180+00 N.B. I.E.D.  
 2184+00 N.B. I.E.D.

PROPERTY LINE FENCE WITH  
 STEEL POSTS  
 2179+00—2186+22 SB


PLAN	BY	DATE
SURVEYED	REVISION	1-60
PLOTTED	S. E. E. B. C.	2-64
TRACED	P. M. J.	2-64

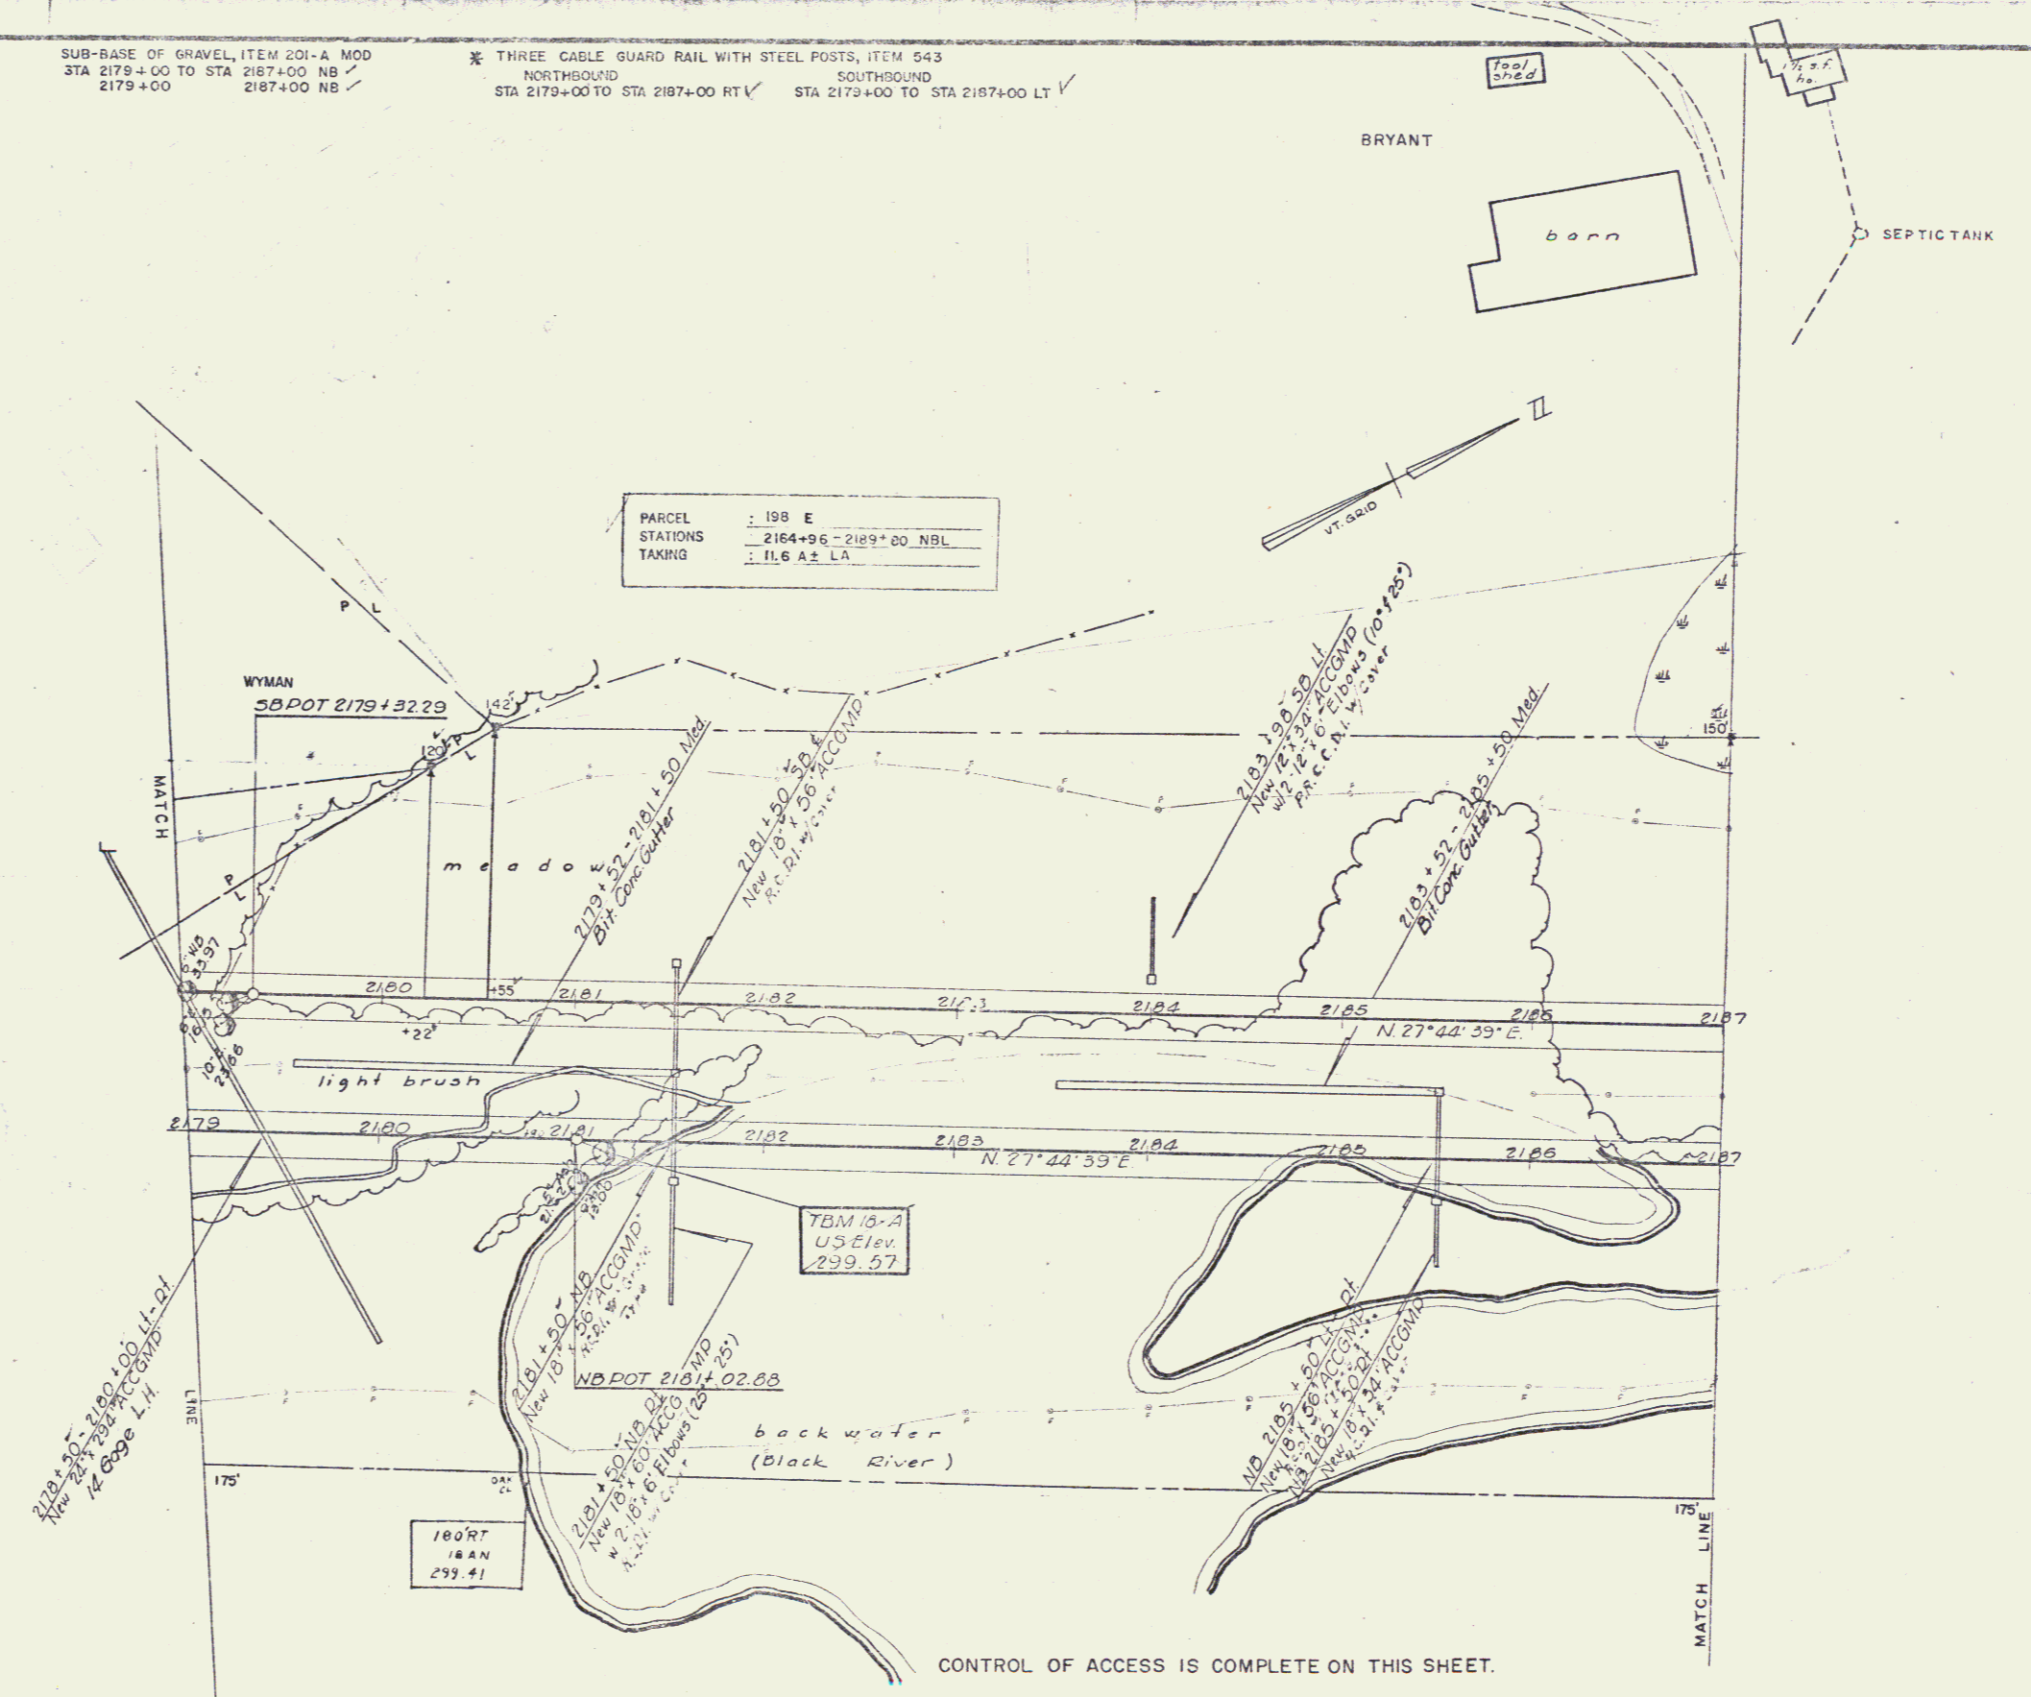

CONTROL OF ACCESS IS COMPLETE ON THIS SHEET.

\* THESE ITEMS ARE STAGE 2 CONSTRUCTION

STAGE 2 CONSTRUCTION

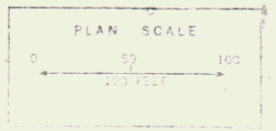

SPRINGFIELD  
 Proj. I 91-1126  
 Sheet 55 of 357